


KAYLOR "B" FIELD LOWER KITTANNING SEAM STRUCTURAL CONTOUR MAP #2

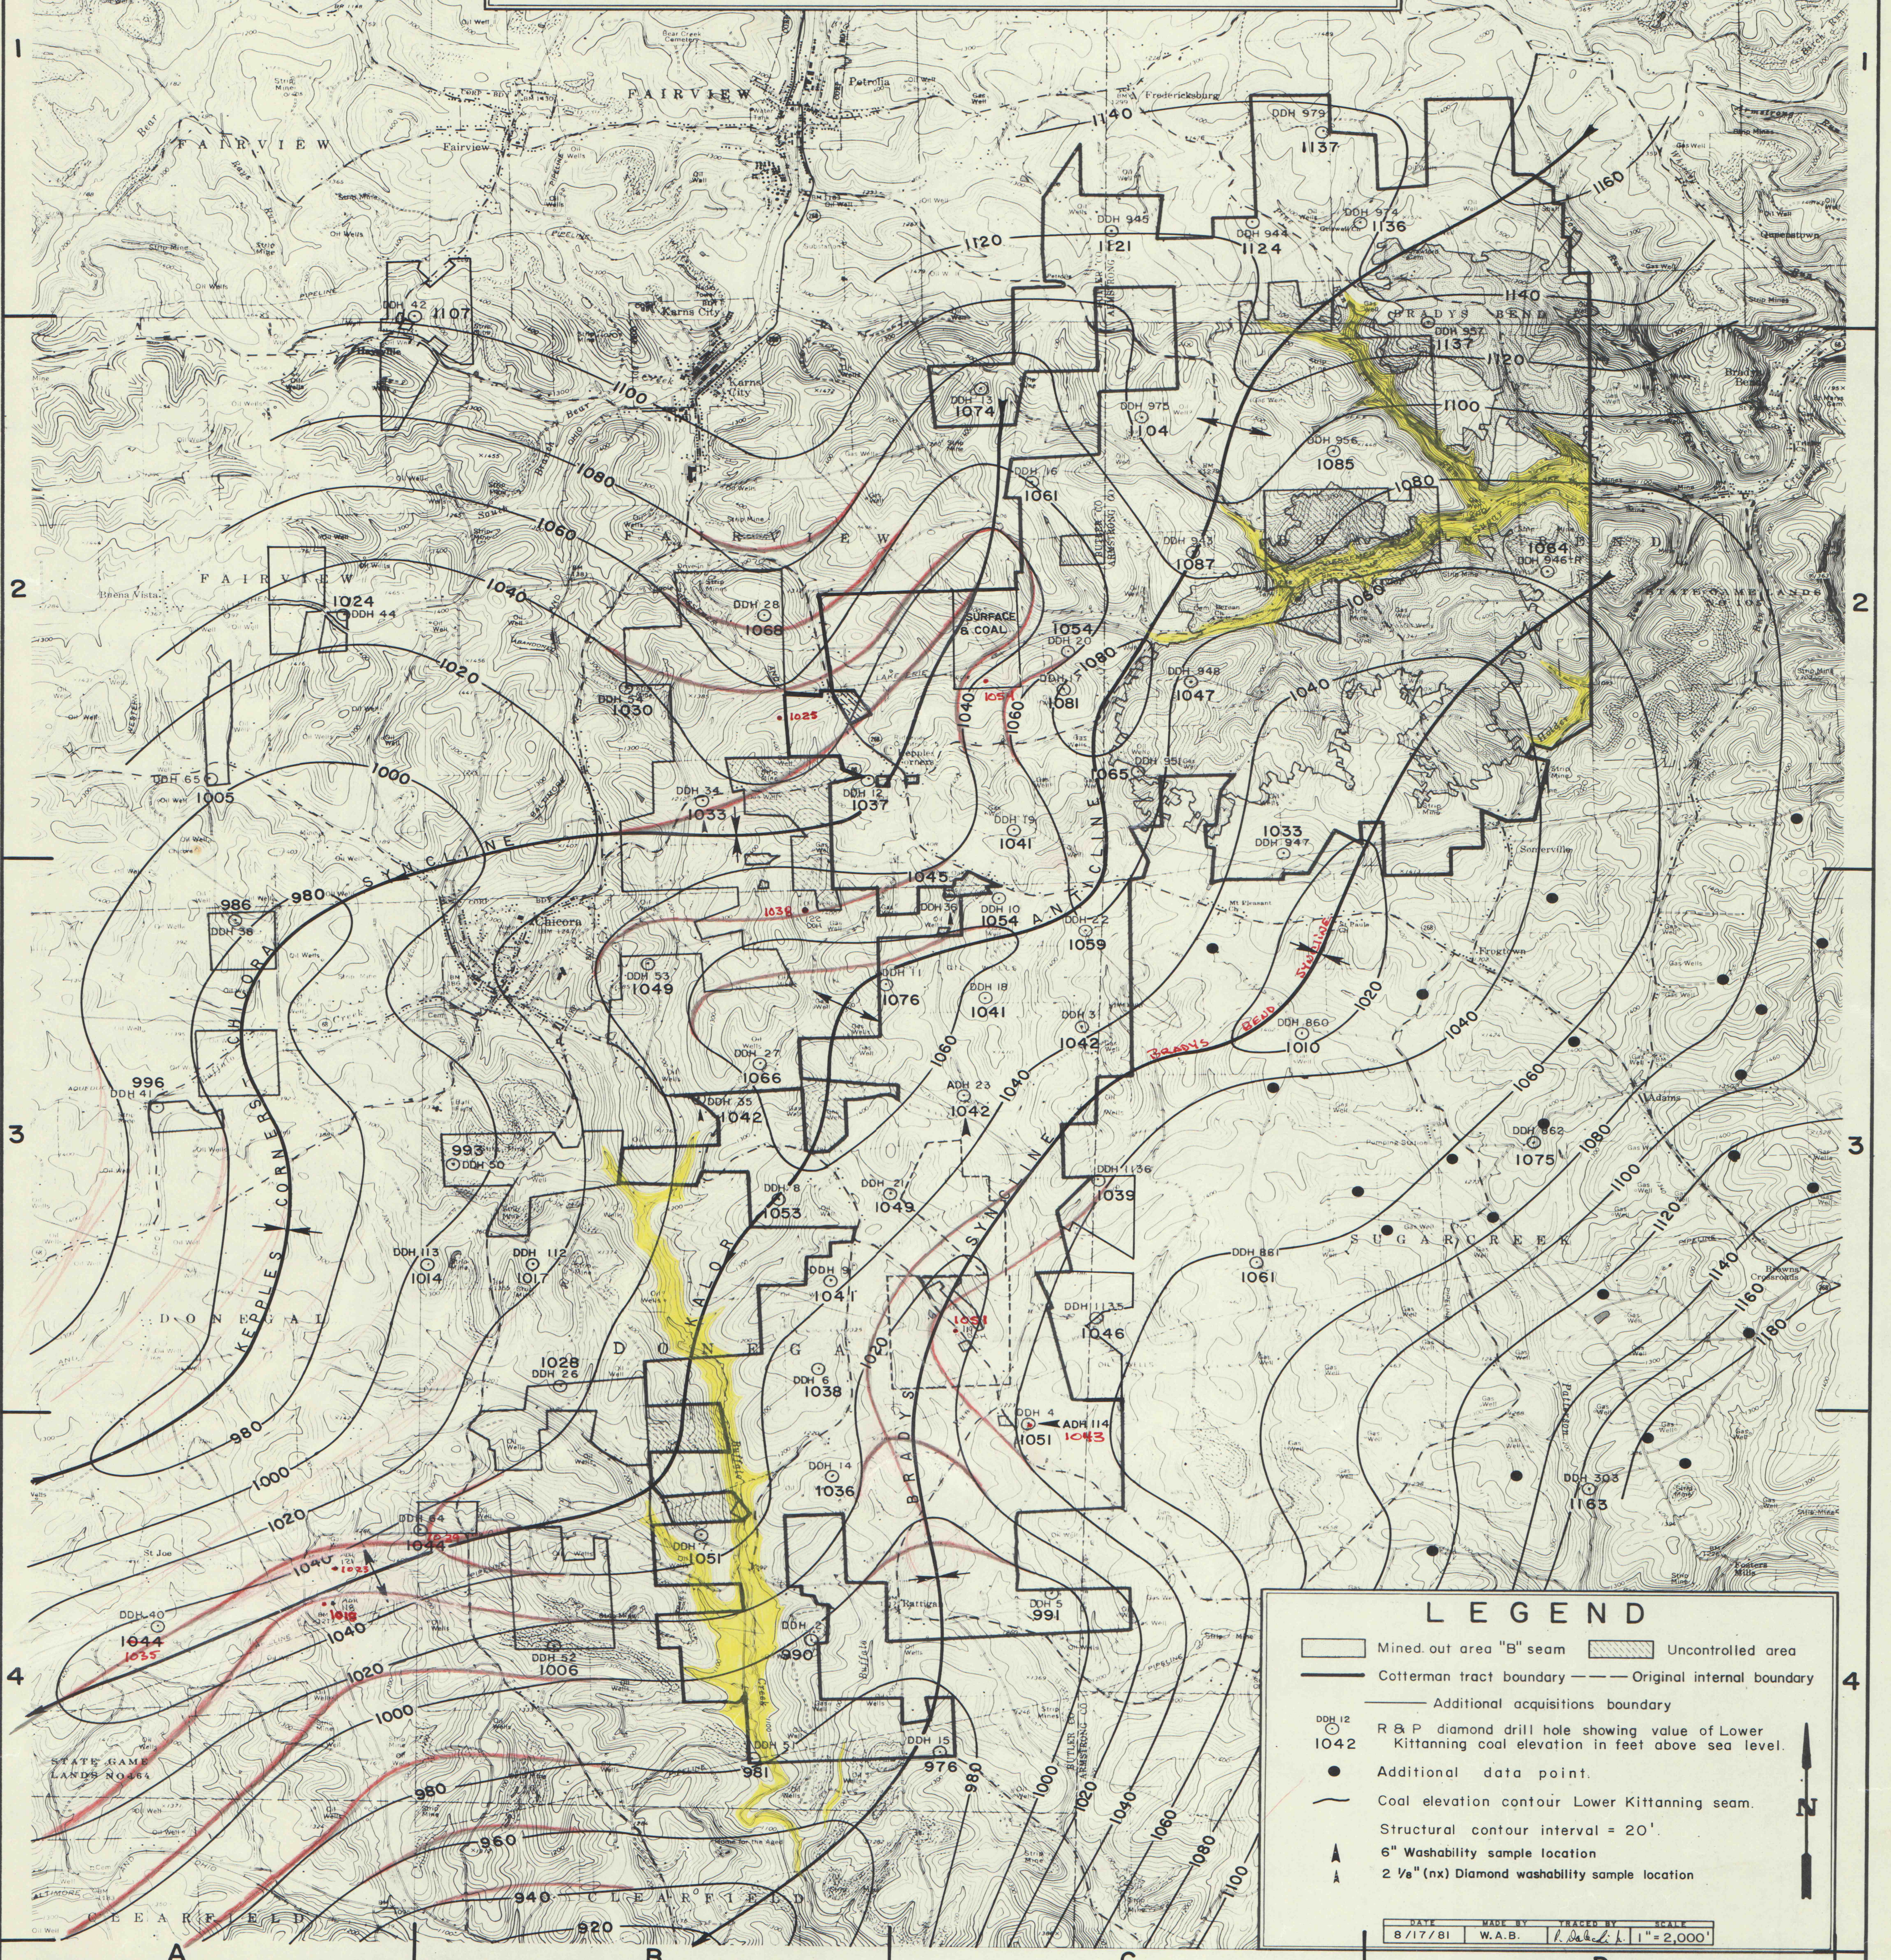

LEGEND

- Mined out area "B" seam
- Cotterman tract boundary
- Additional acquisitions boundary
- R & P diamond drill hole showing value of Lower Kittanning coal elevation in feet above sea level.
- Additional data point.
- Coal elevation contour Lower Kittanning seam.
- Structural contour interval = 20'
- 6" Washability sample location
- 2 1/8" (nx) Diamond washability sample location
- Uncontrolled area
- Original internal boundary

DATE	MADE BY	TRACED BY	SCALE
8/17/81	W.A.B.	R. DeLoach	1" = 2,000'

Change Sur elev
DDH 10 from 1270 to 1280
DDH 4 from 1245 to 1250

Structure Revised 1/15/82 DJS.

100' & LESS OVERBUDEN FOR LK SEAM 1/19/82
IMAPS# 12109