


KAYLOR "B" FIELD LOWER KITTANNING SEAM

ASH
MAP

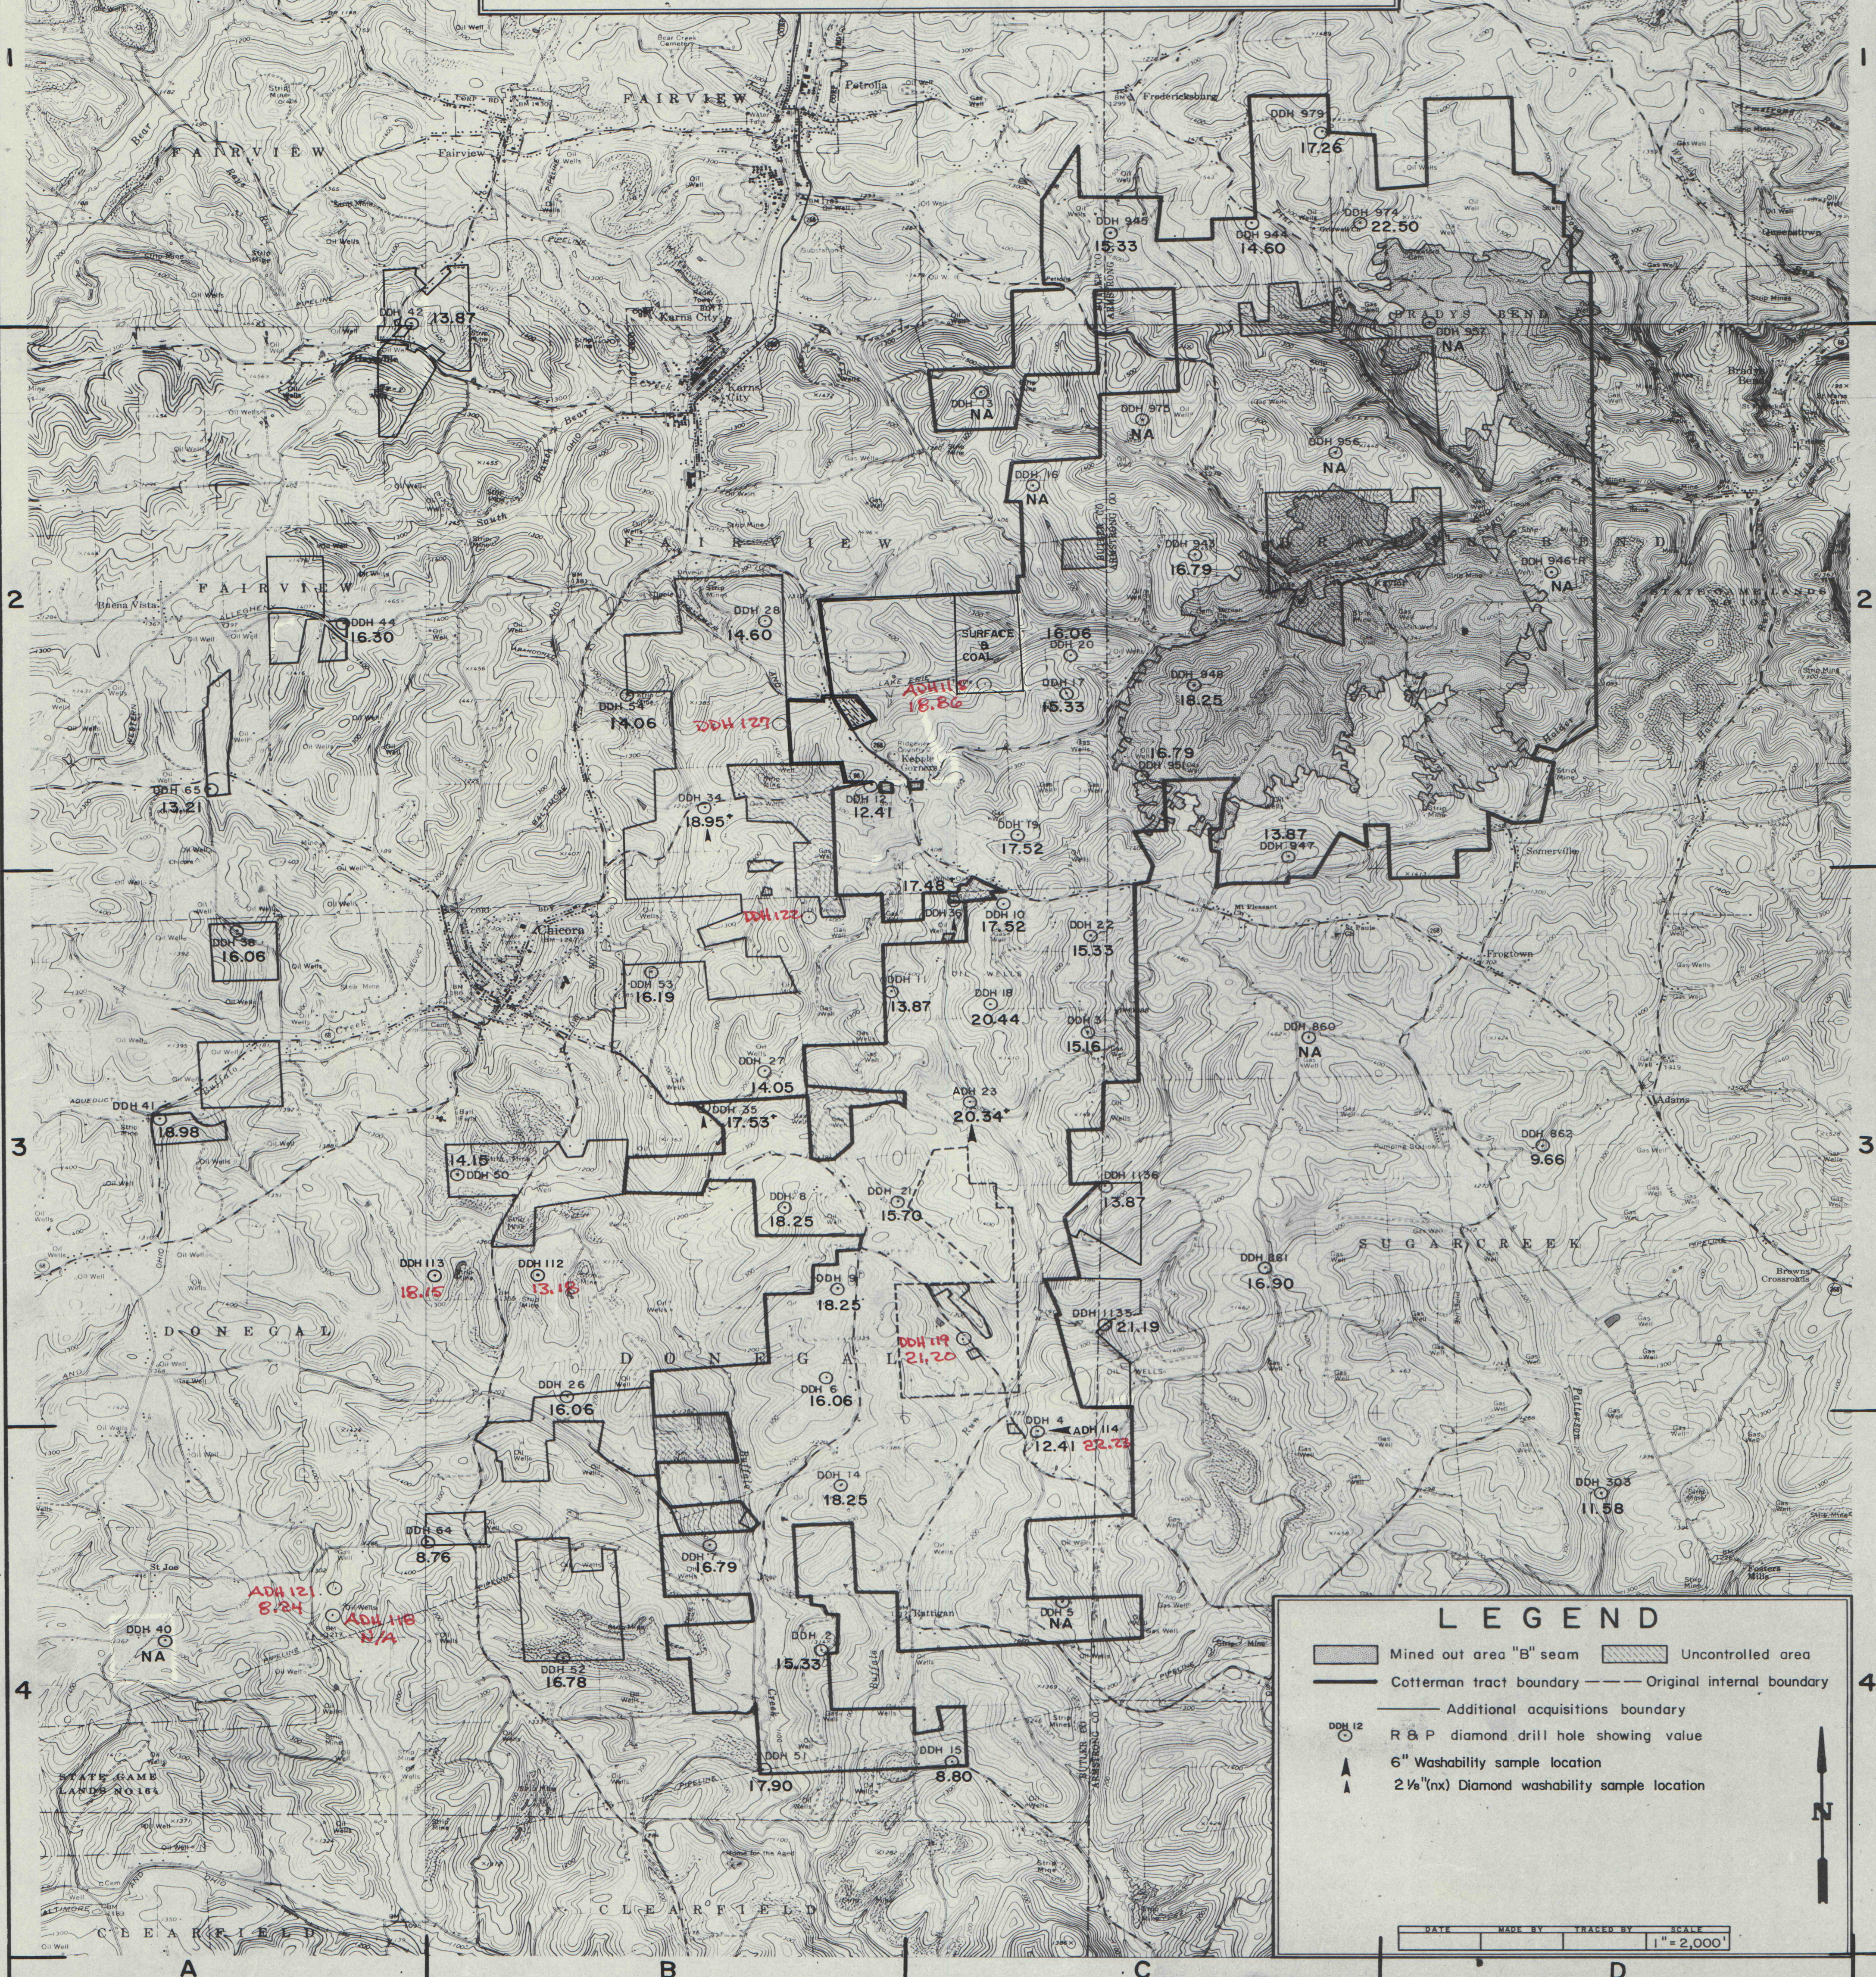

LEGEND

- Mined out area "B" seam
- Uncontrolled area
- Cotterman tract boundary
- Original internal boundary
- Additional acquisitions boundary
- R & P diamond drill hole showing value
- 6" Washability sample location
- 2 1/2" (x) Diamond washability sample location

DATE: _____ MADE BY: _____ DRAWN BY: _____ SCALE: 1" = 2,000'