


MAP #

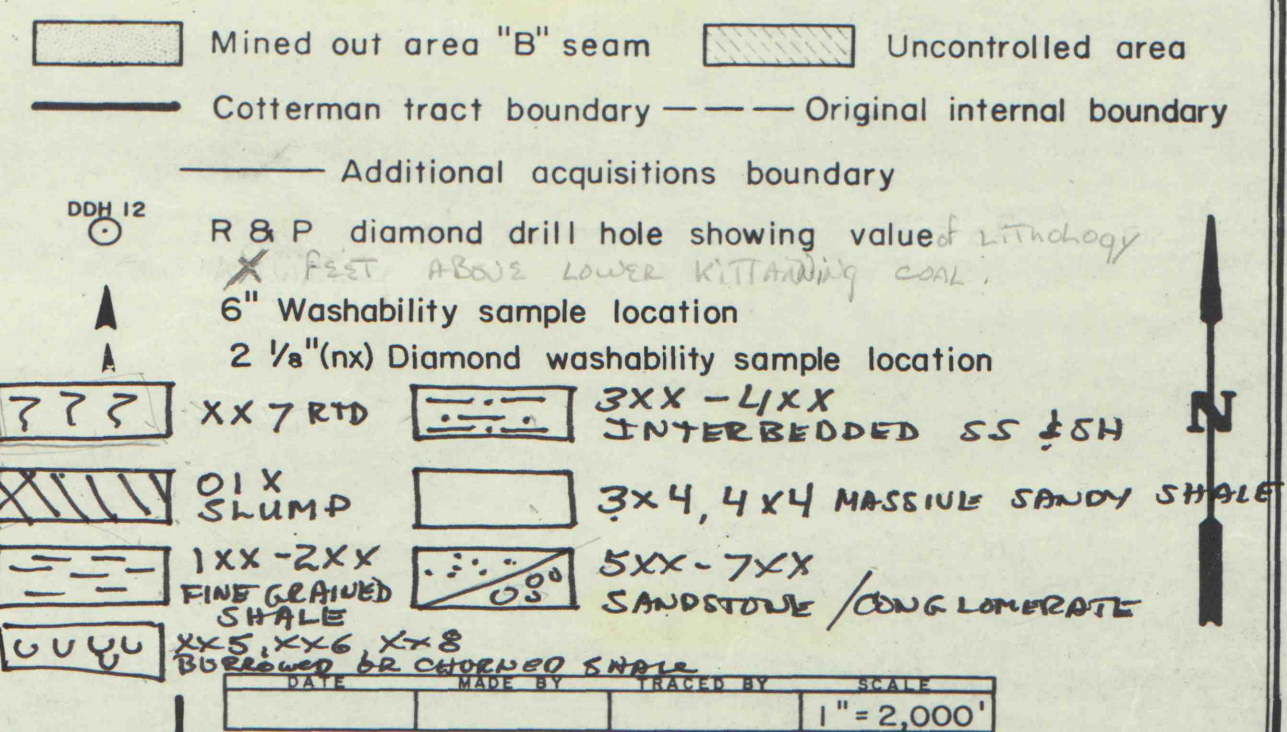

IMAPS#12121