


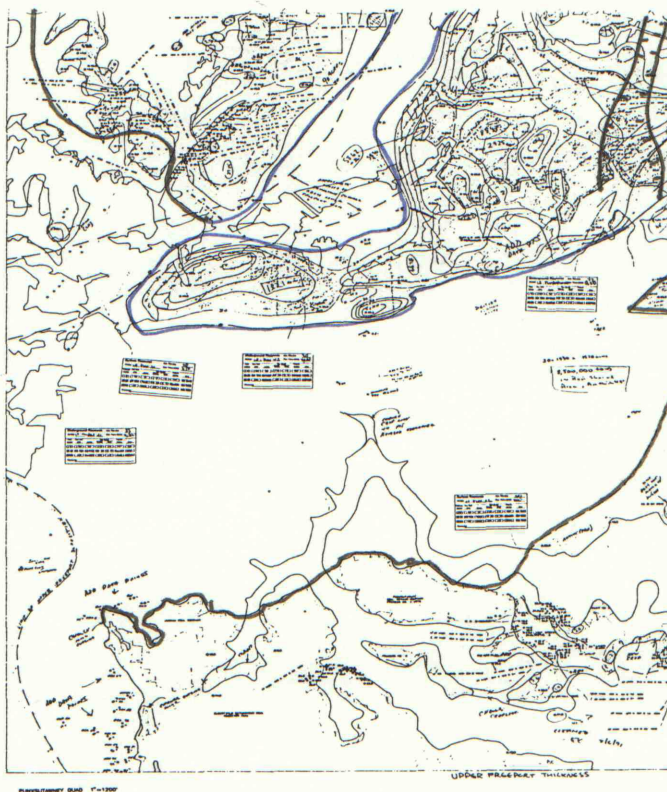

INAPS# 12200