


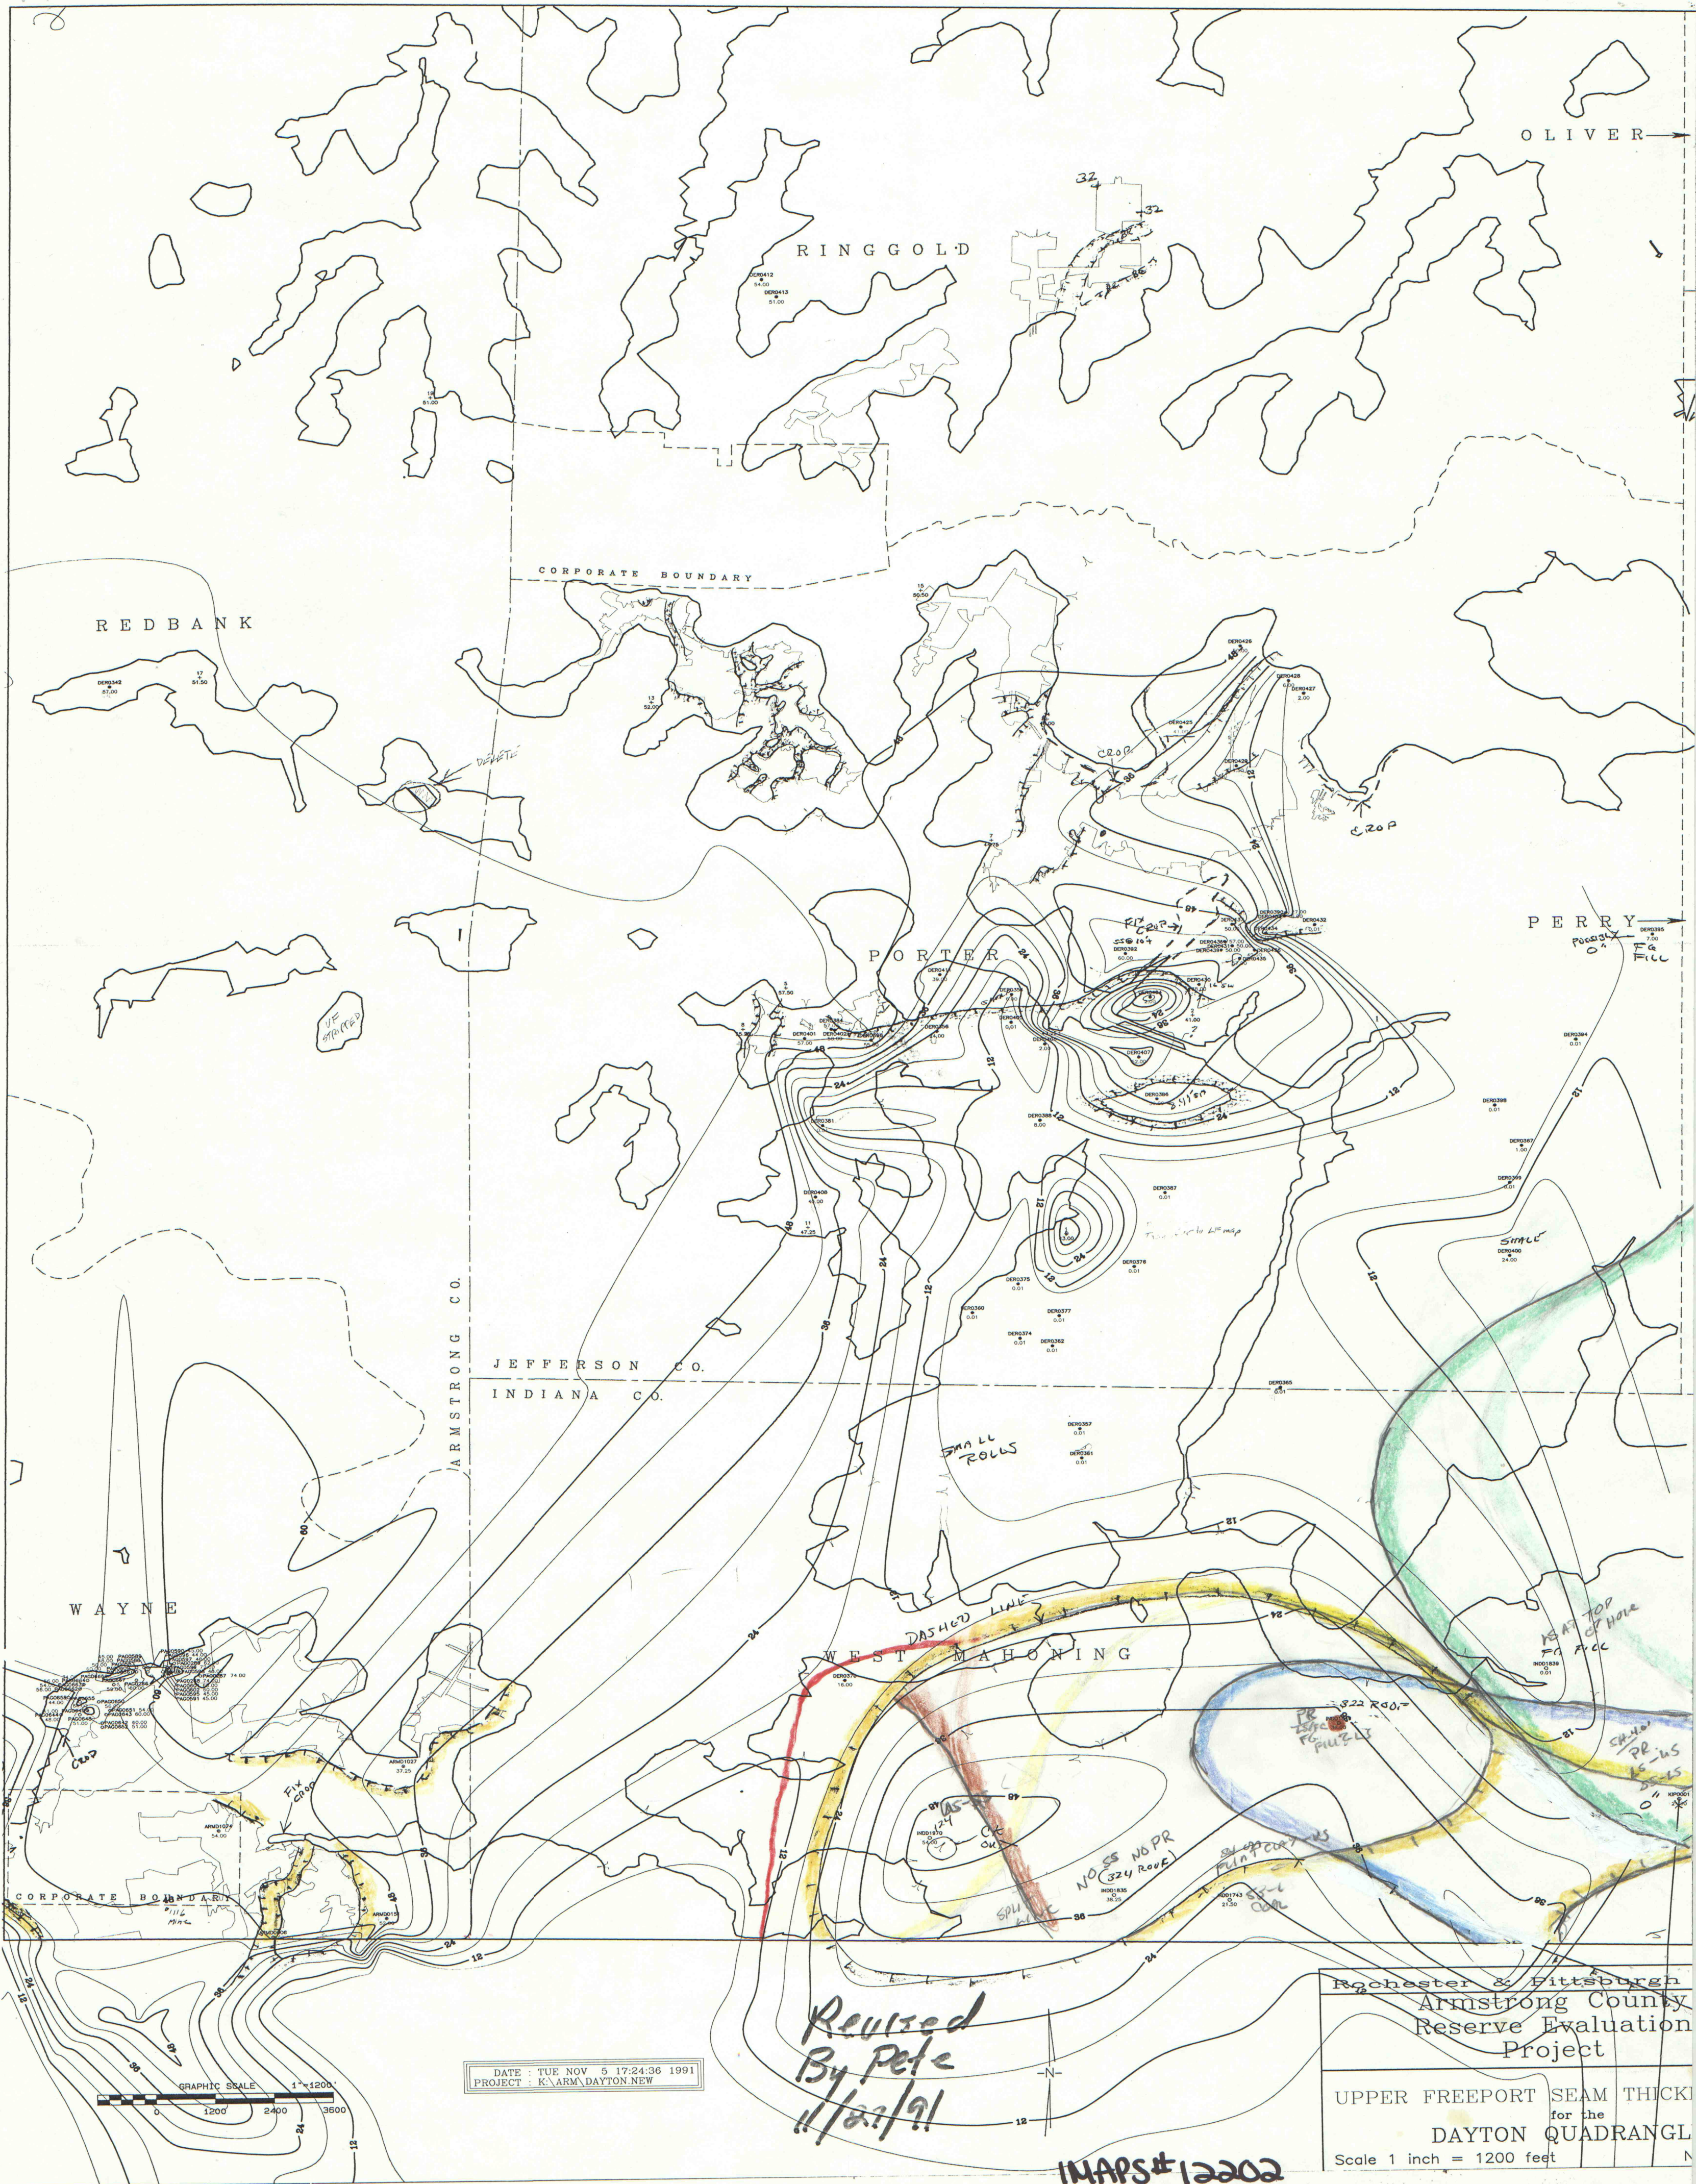

DATE : TUE NOV 5 17:24:36 1991
PROJECT : K\ARM\DAYTON.NEW

Revised
By Pete
11/22/91

INAPS#12202

Rochester & Pittsburgh
Armstrong County
Reserve Evaluation
Project

UPPER FREEPORT SEAM THICK
for the
DAYTON QUADRANGLE
Scale 1 inch = 1200 feet