


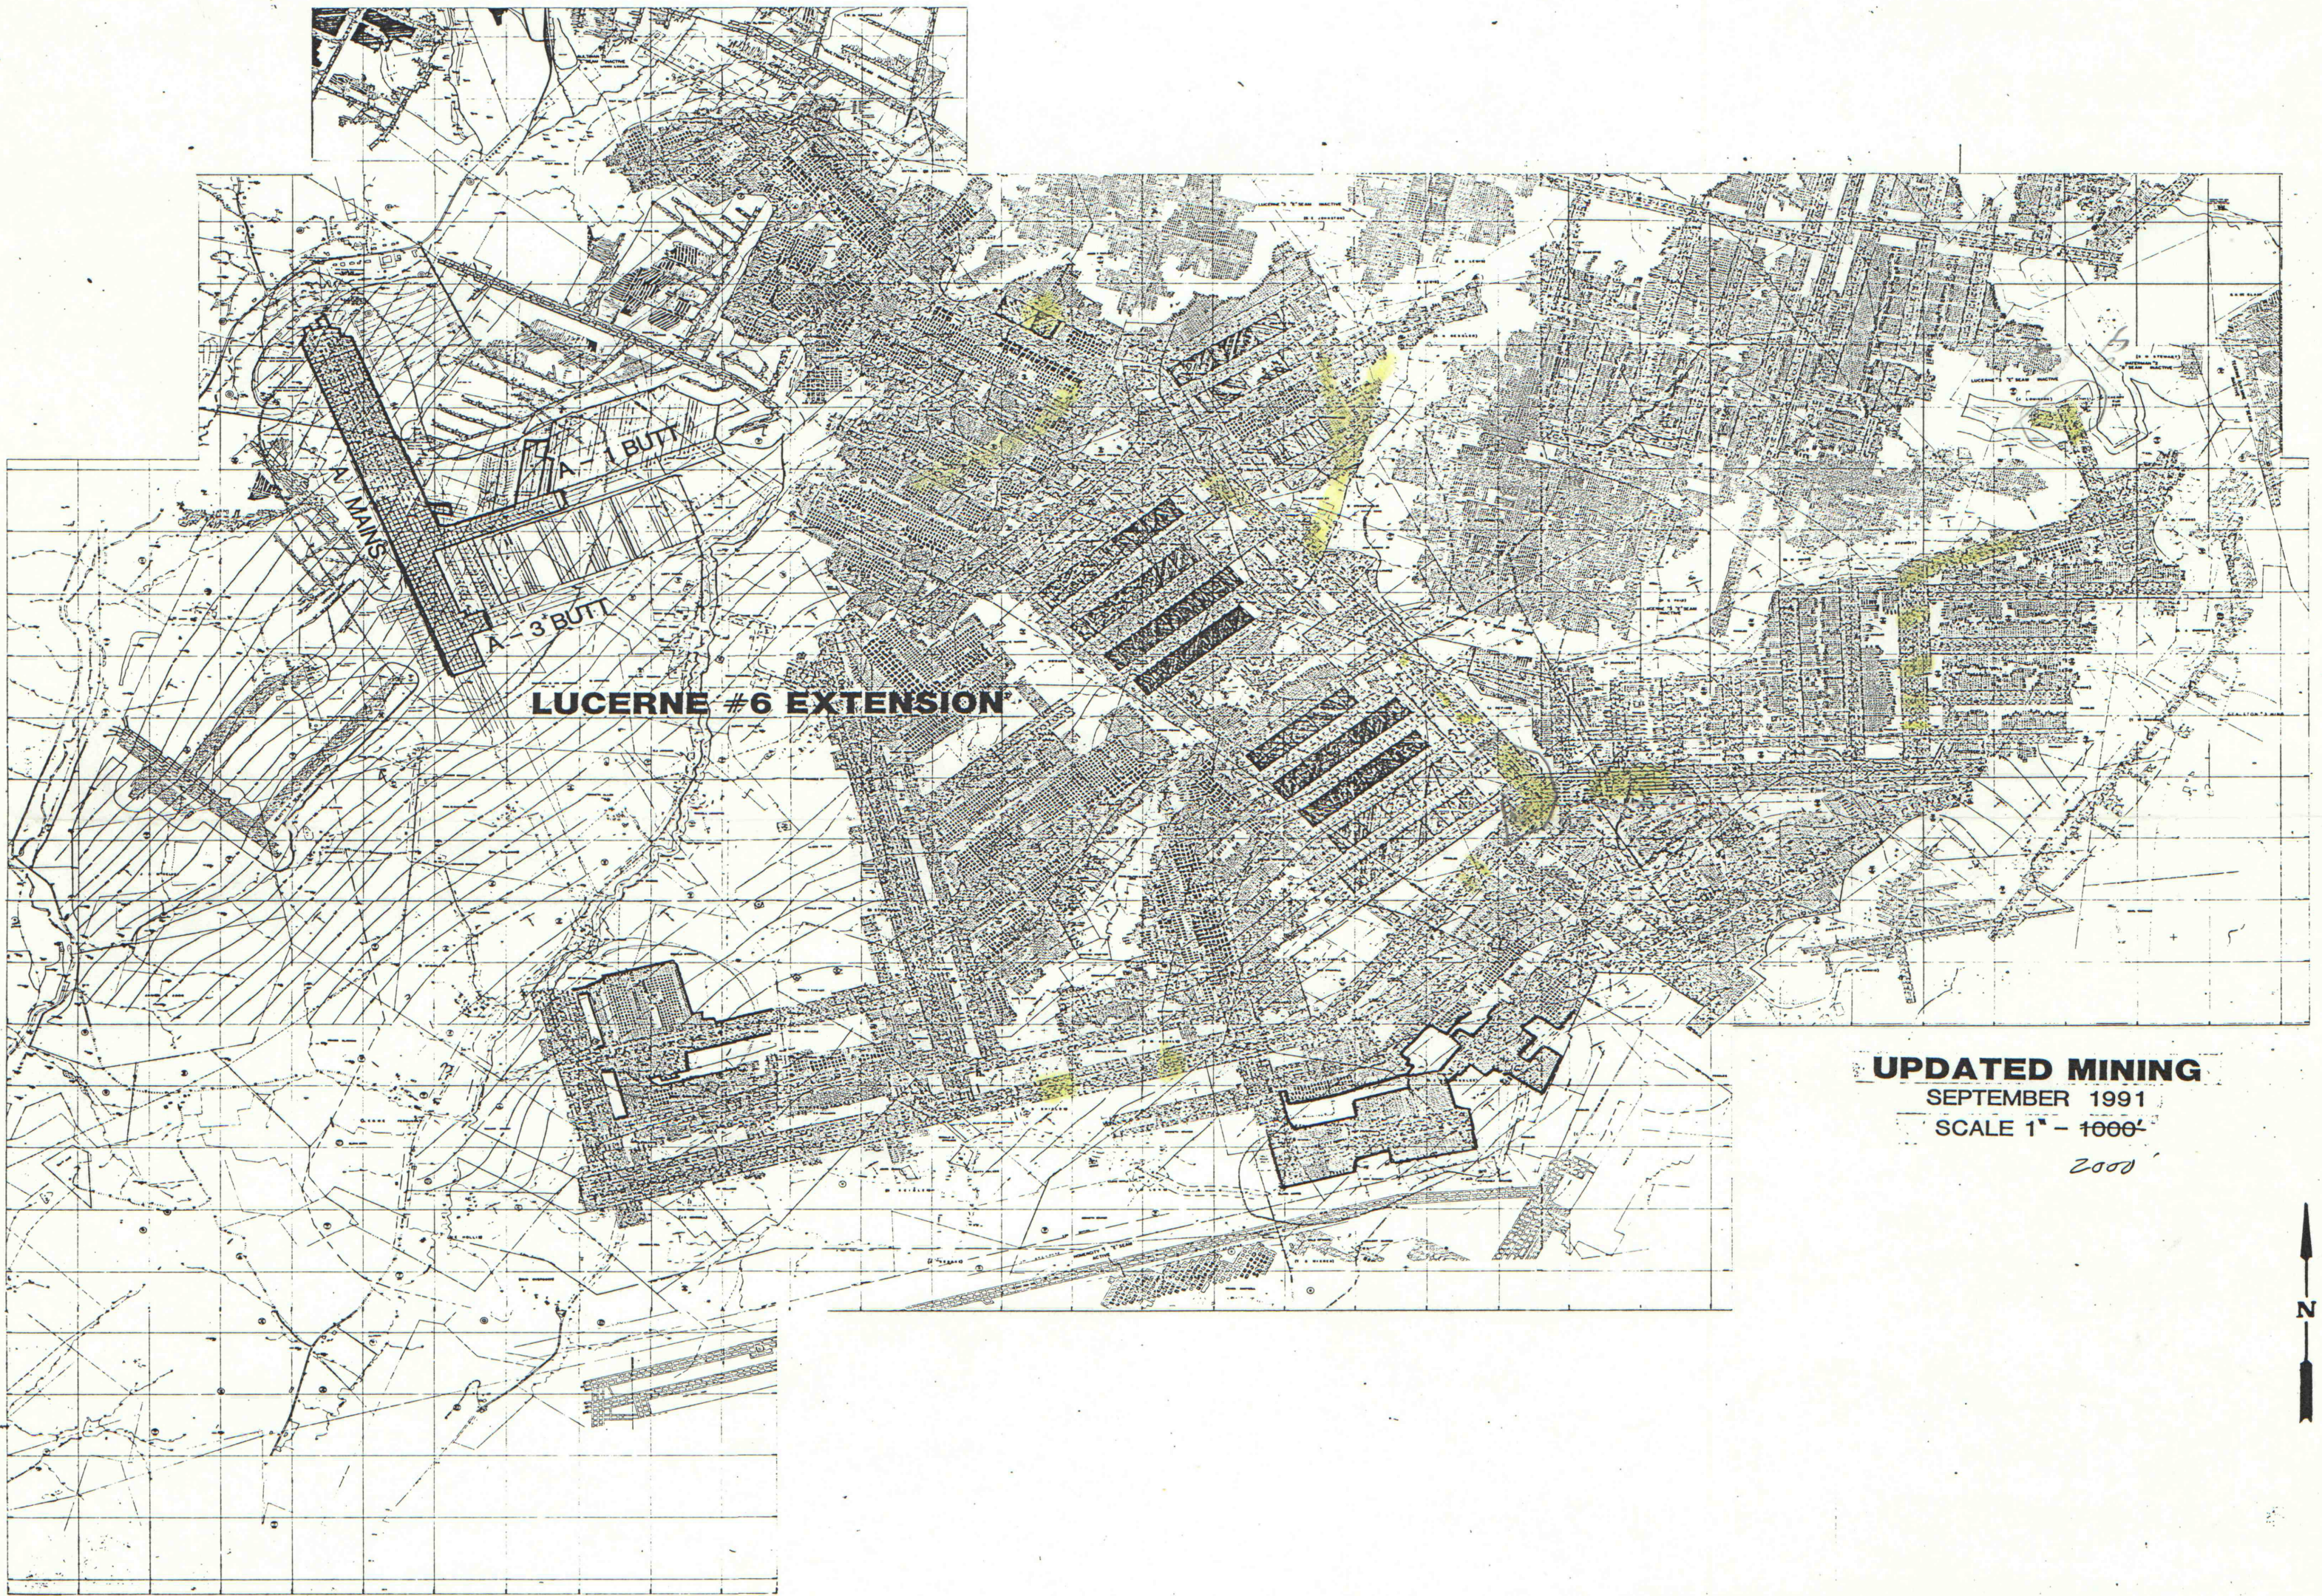

UPDATED MINING
SEPTEMBER 1991
SCALE 1" = 1000'
2000

LUCERNE NO. 6 MINE - HELVETIA COAL CO.
BLACKLICK & CENTER TWPS., INDIANA CO.
SCALE 1" = 1000' DATE: 1-1-91

MAPS# 12205