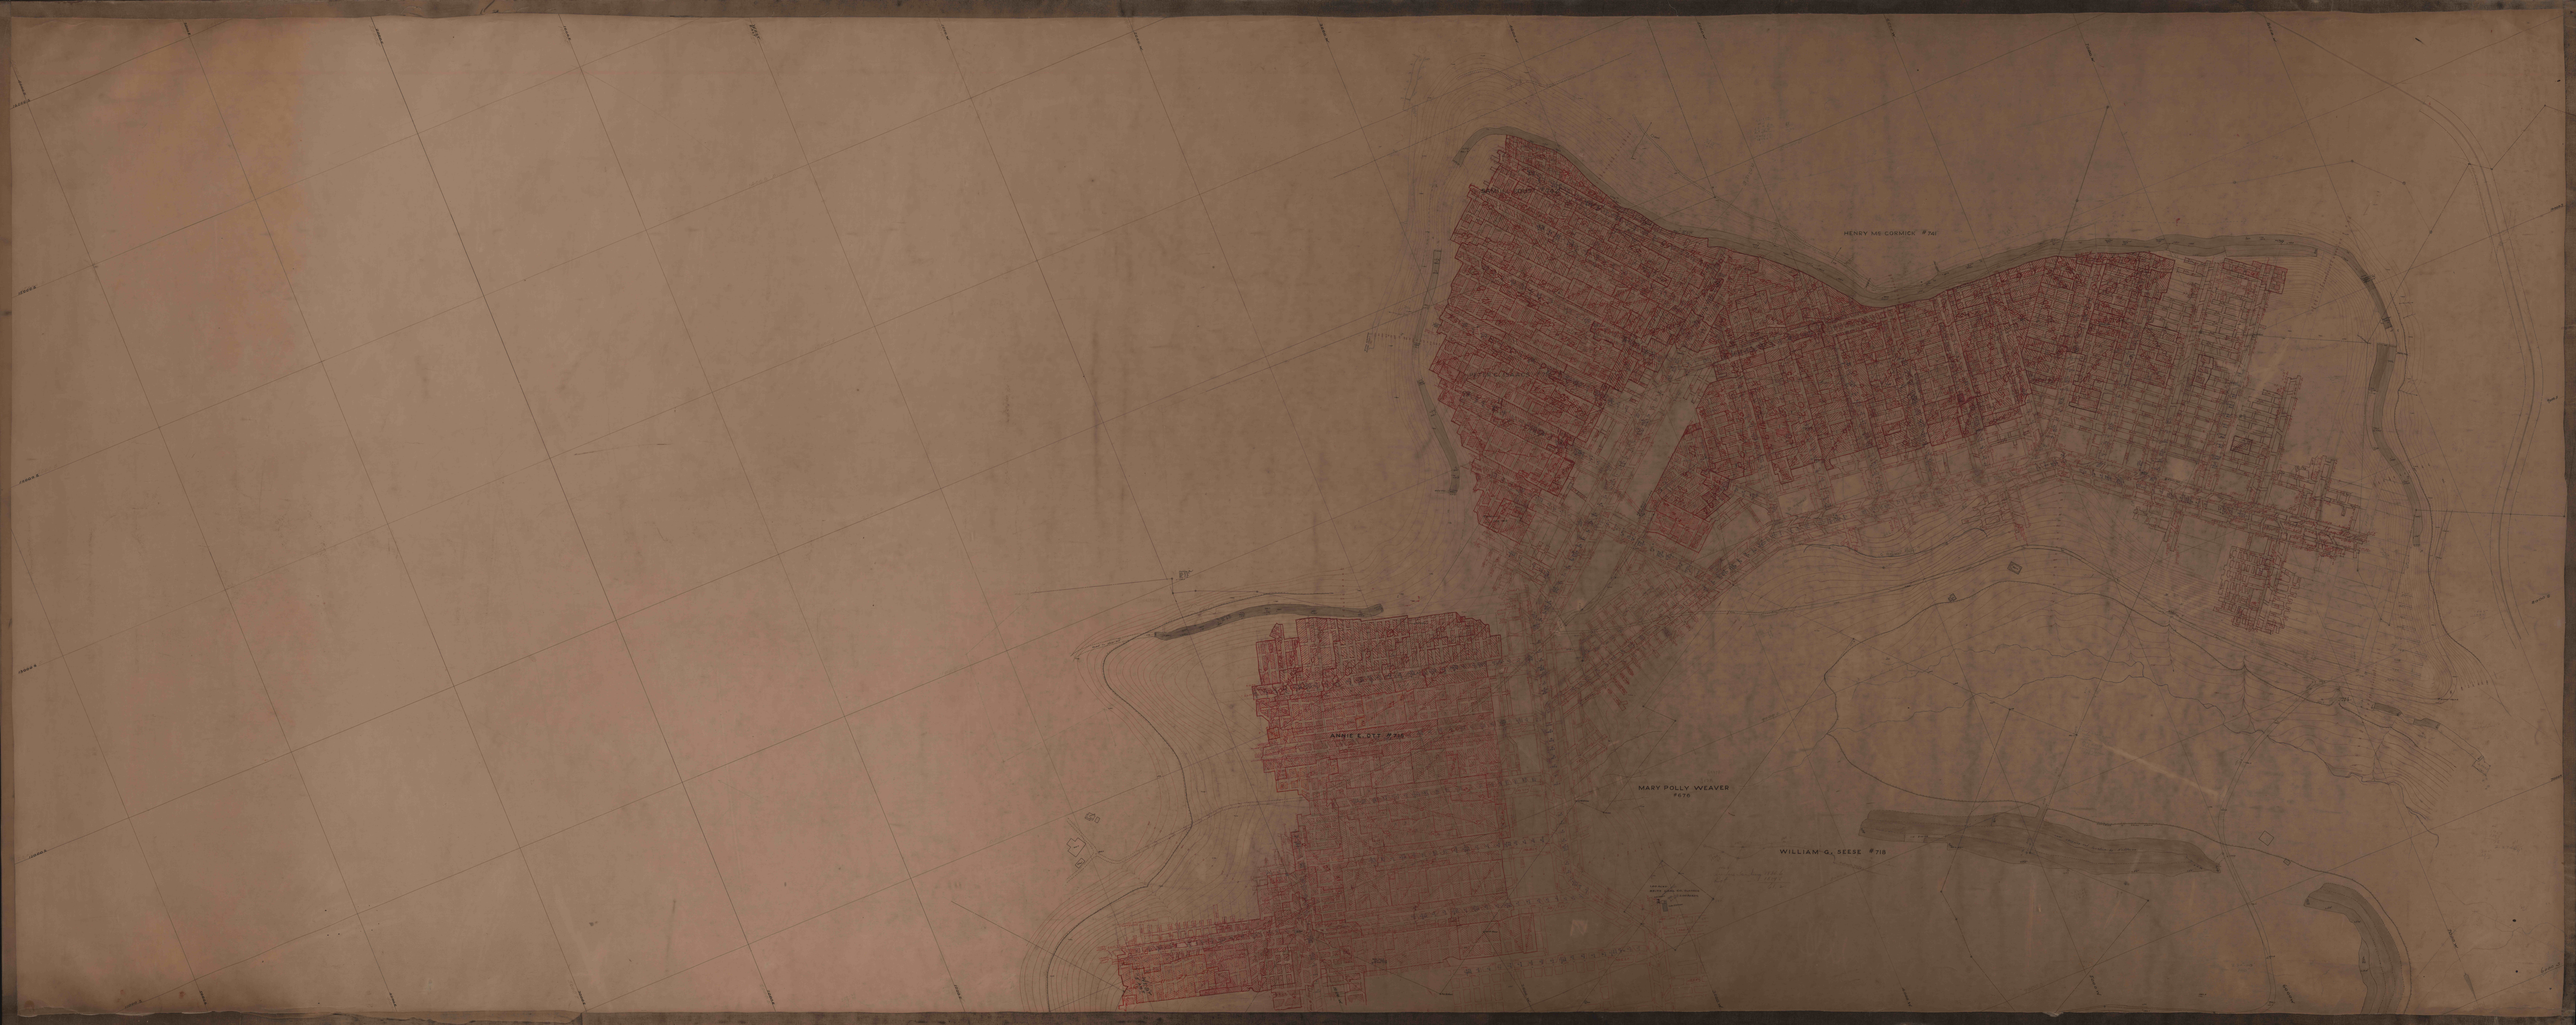
HENRY McCORMICK #741
ANNIE KOTZ #716
MARY POLLY WEAVER
#678
WILLIAM G. SEESE #718