



# STOCKTON MINE SECTION NO. 17.

NORTH  
SCALE 1"=100'

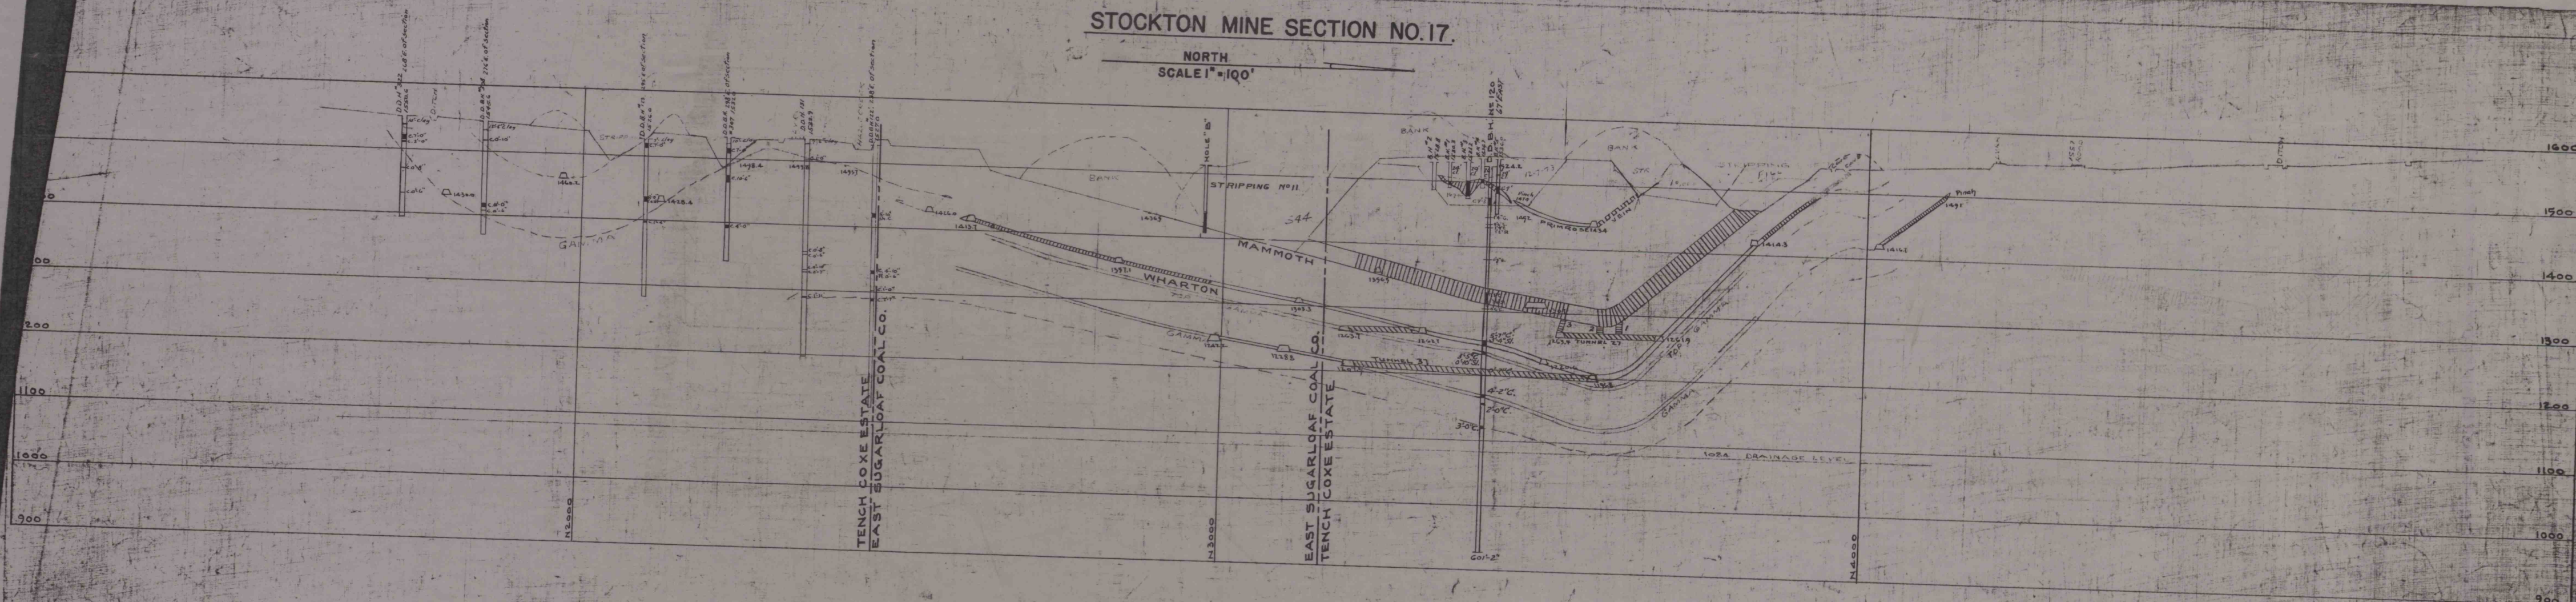

# STOCKTON MINE SECTION NO. 18.

NORTH  
SCALE 1"=100'

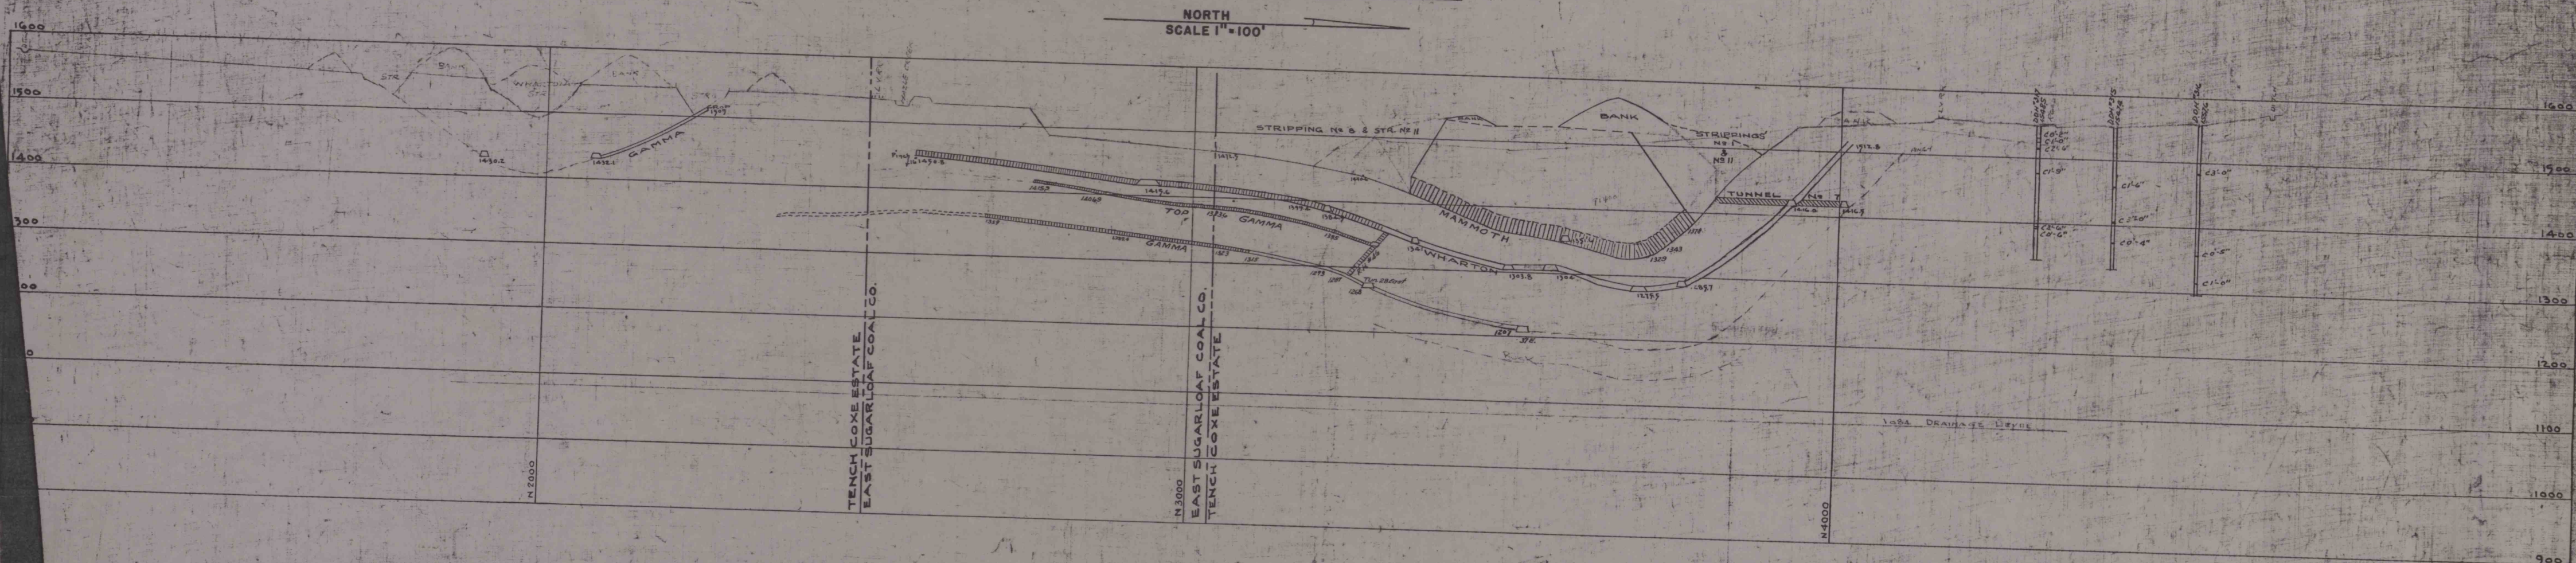

STOCKTON  
MINE  
SECTION  
NO. 17  
EAST  
SUGARLOAF  
COAL CO.  
TENCH  
COKE ESTATE  
6/25/15