


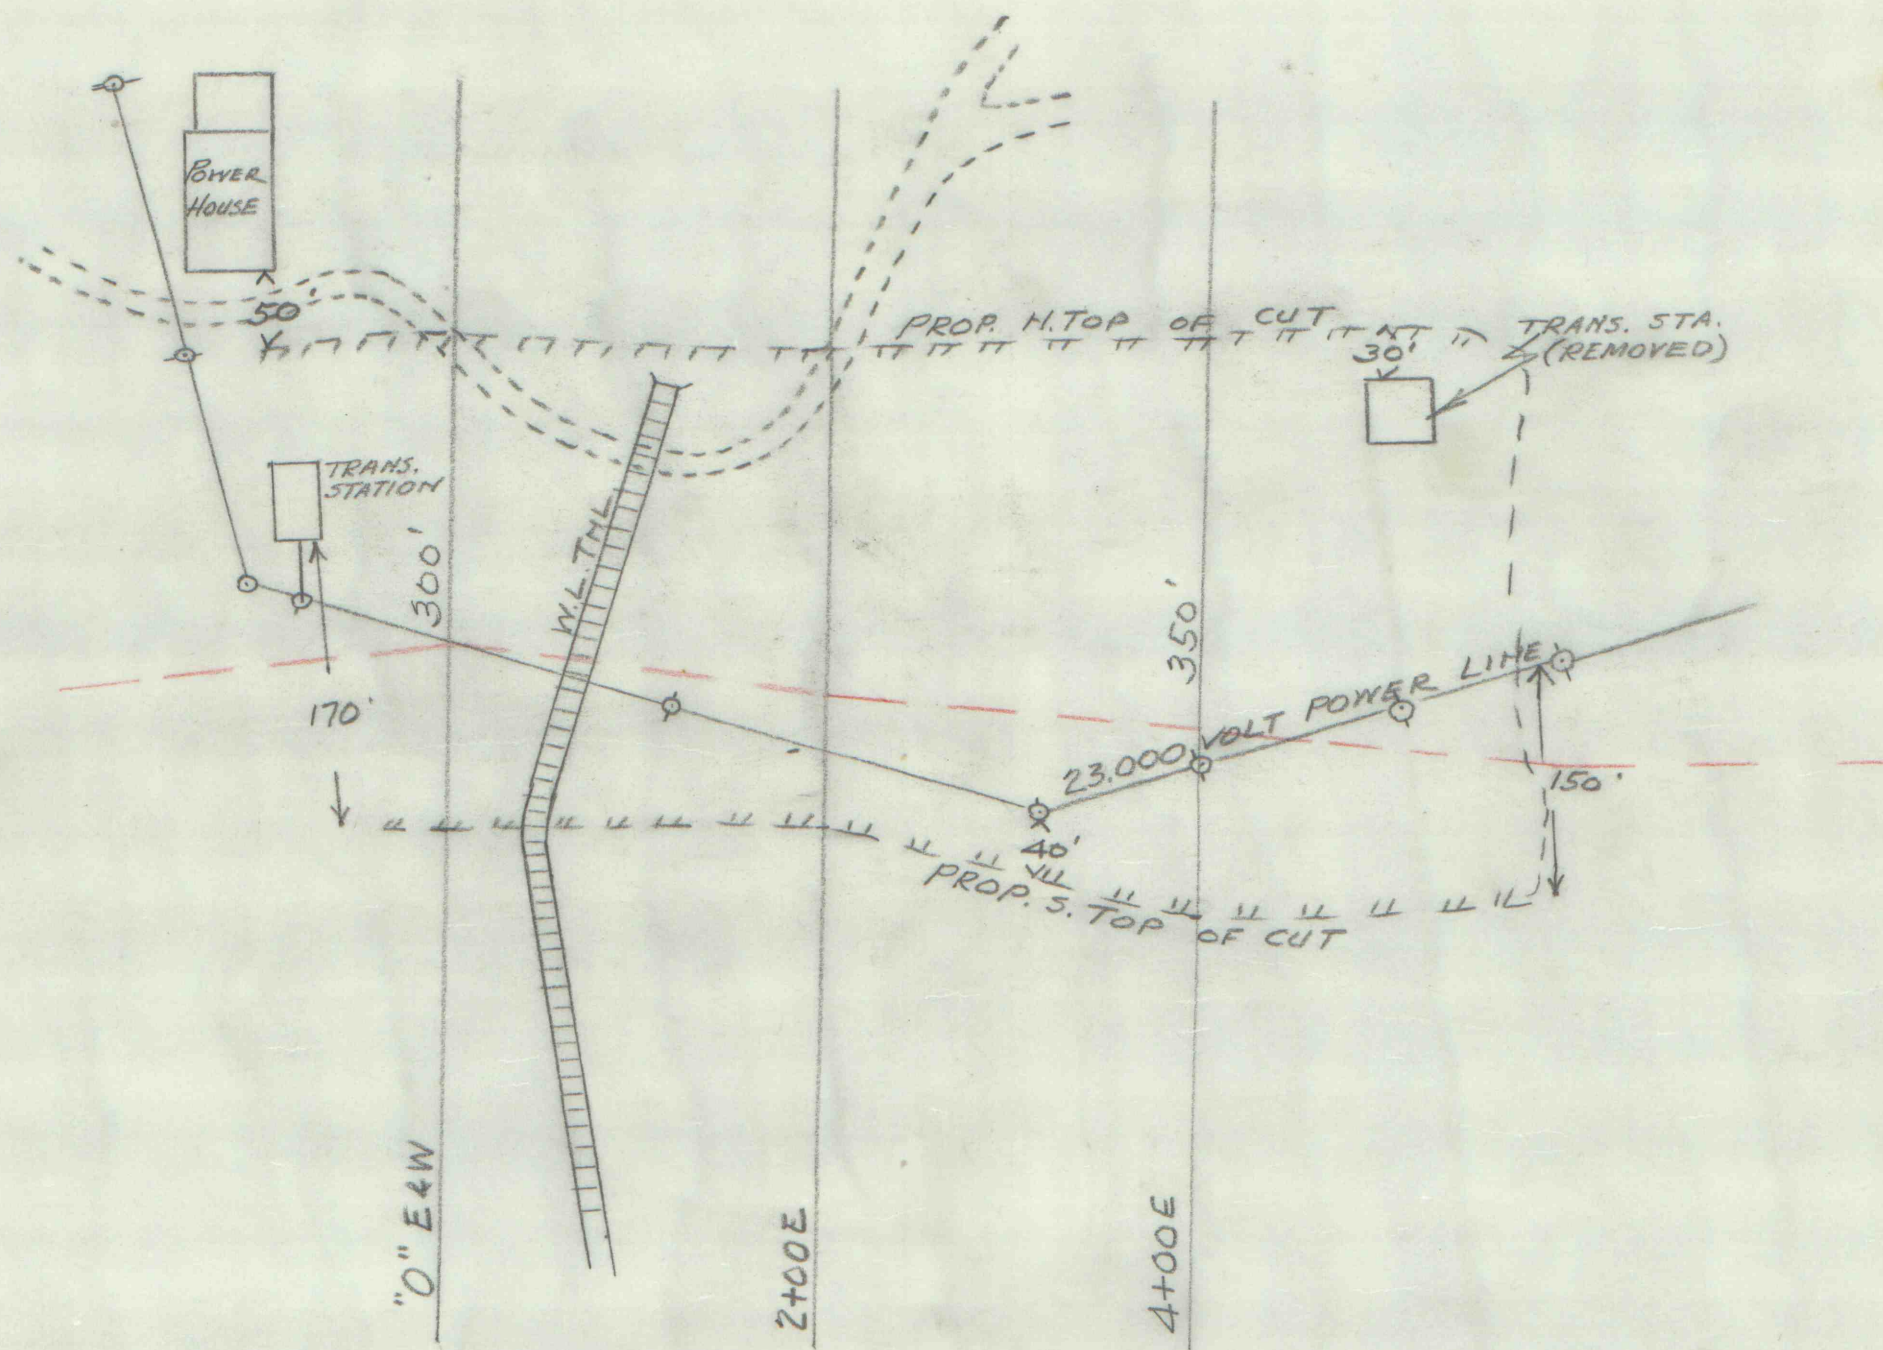

BEAR VALLEY