


BUTTONWOOD COLLIERY  
KIDNEY VEIN

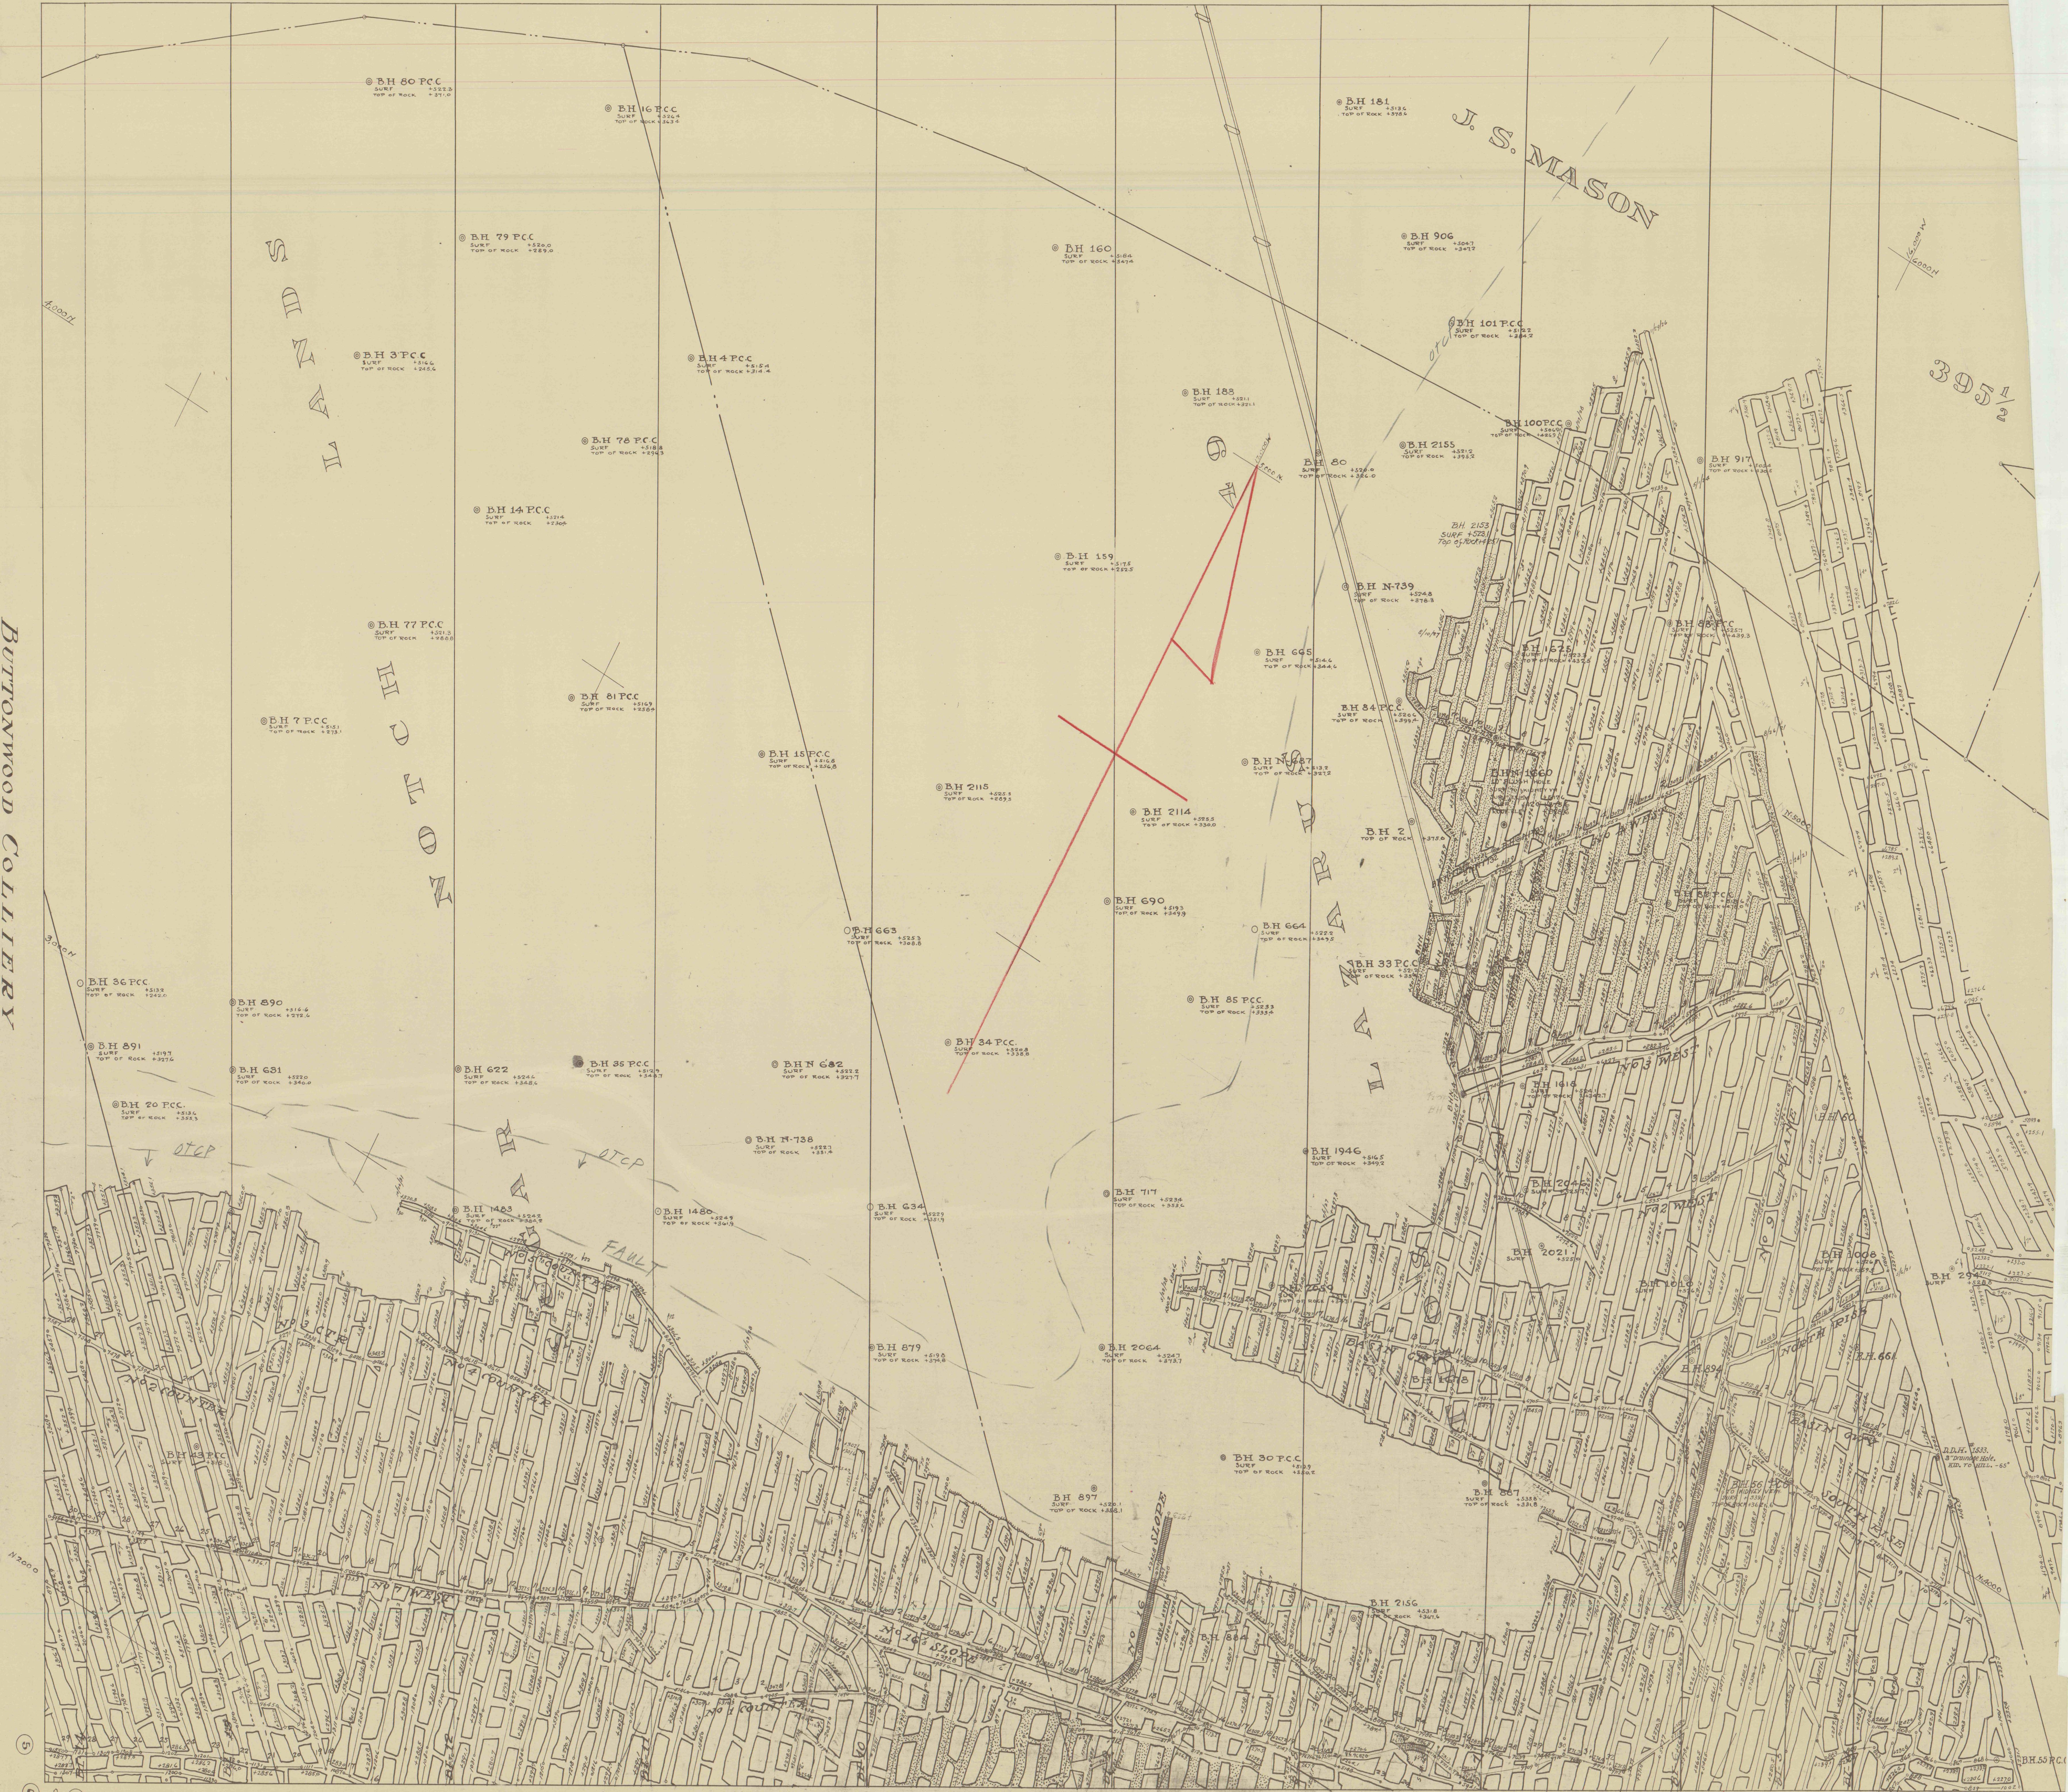

Buttonwood & Inman  
Kidney #1  
Scale 1"=100'