


Section 6

Section 6

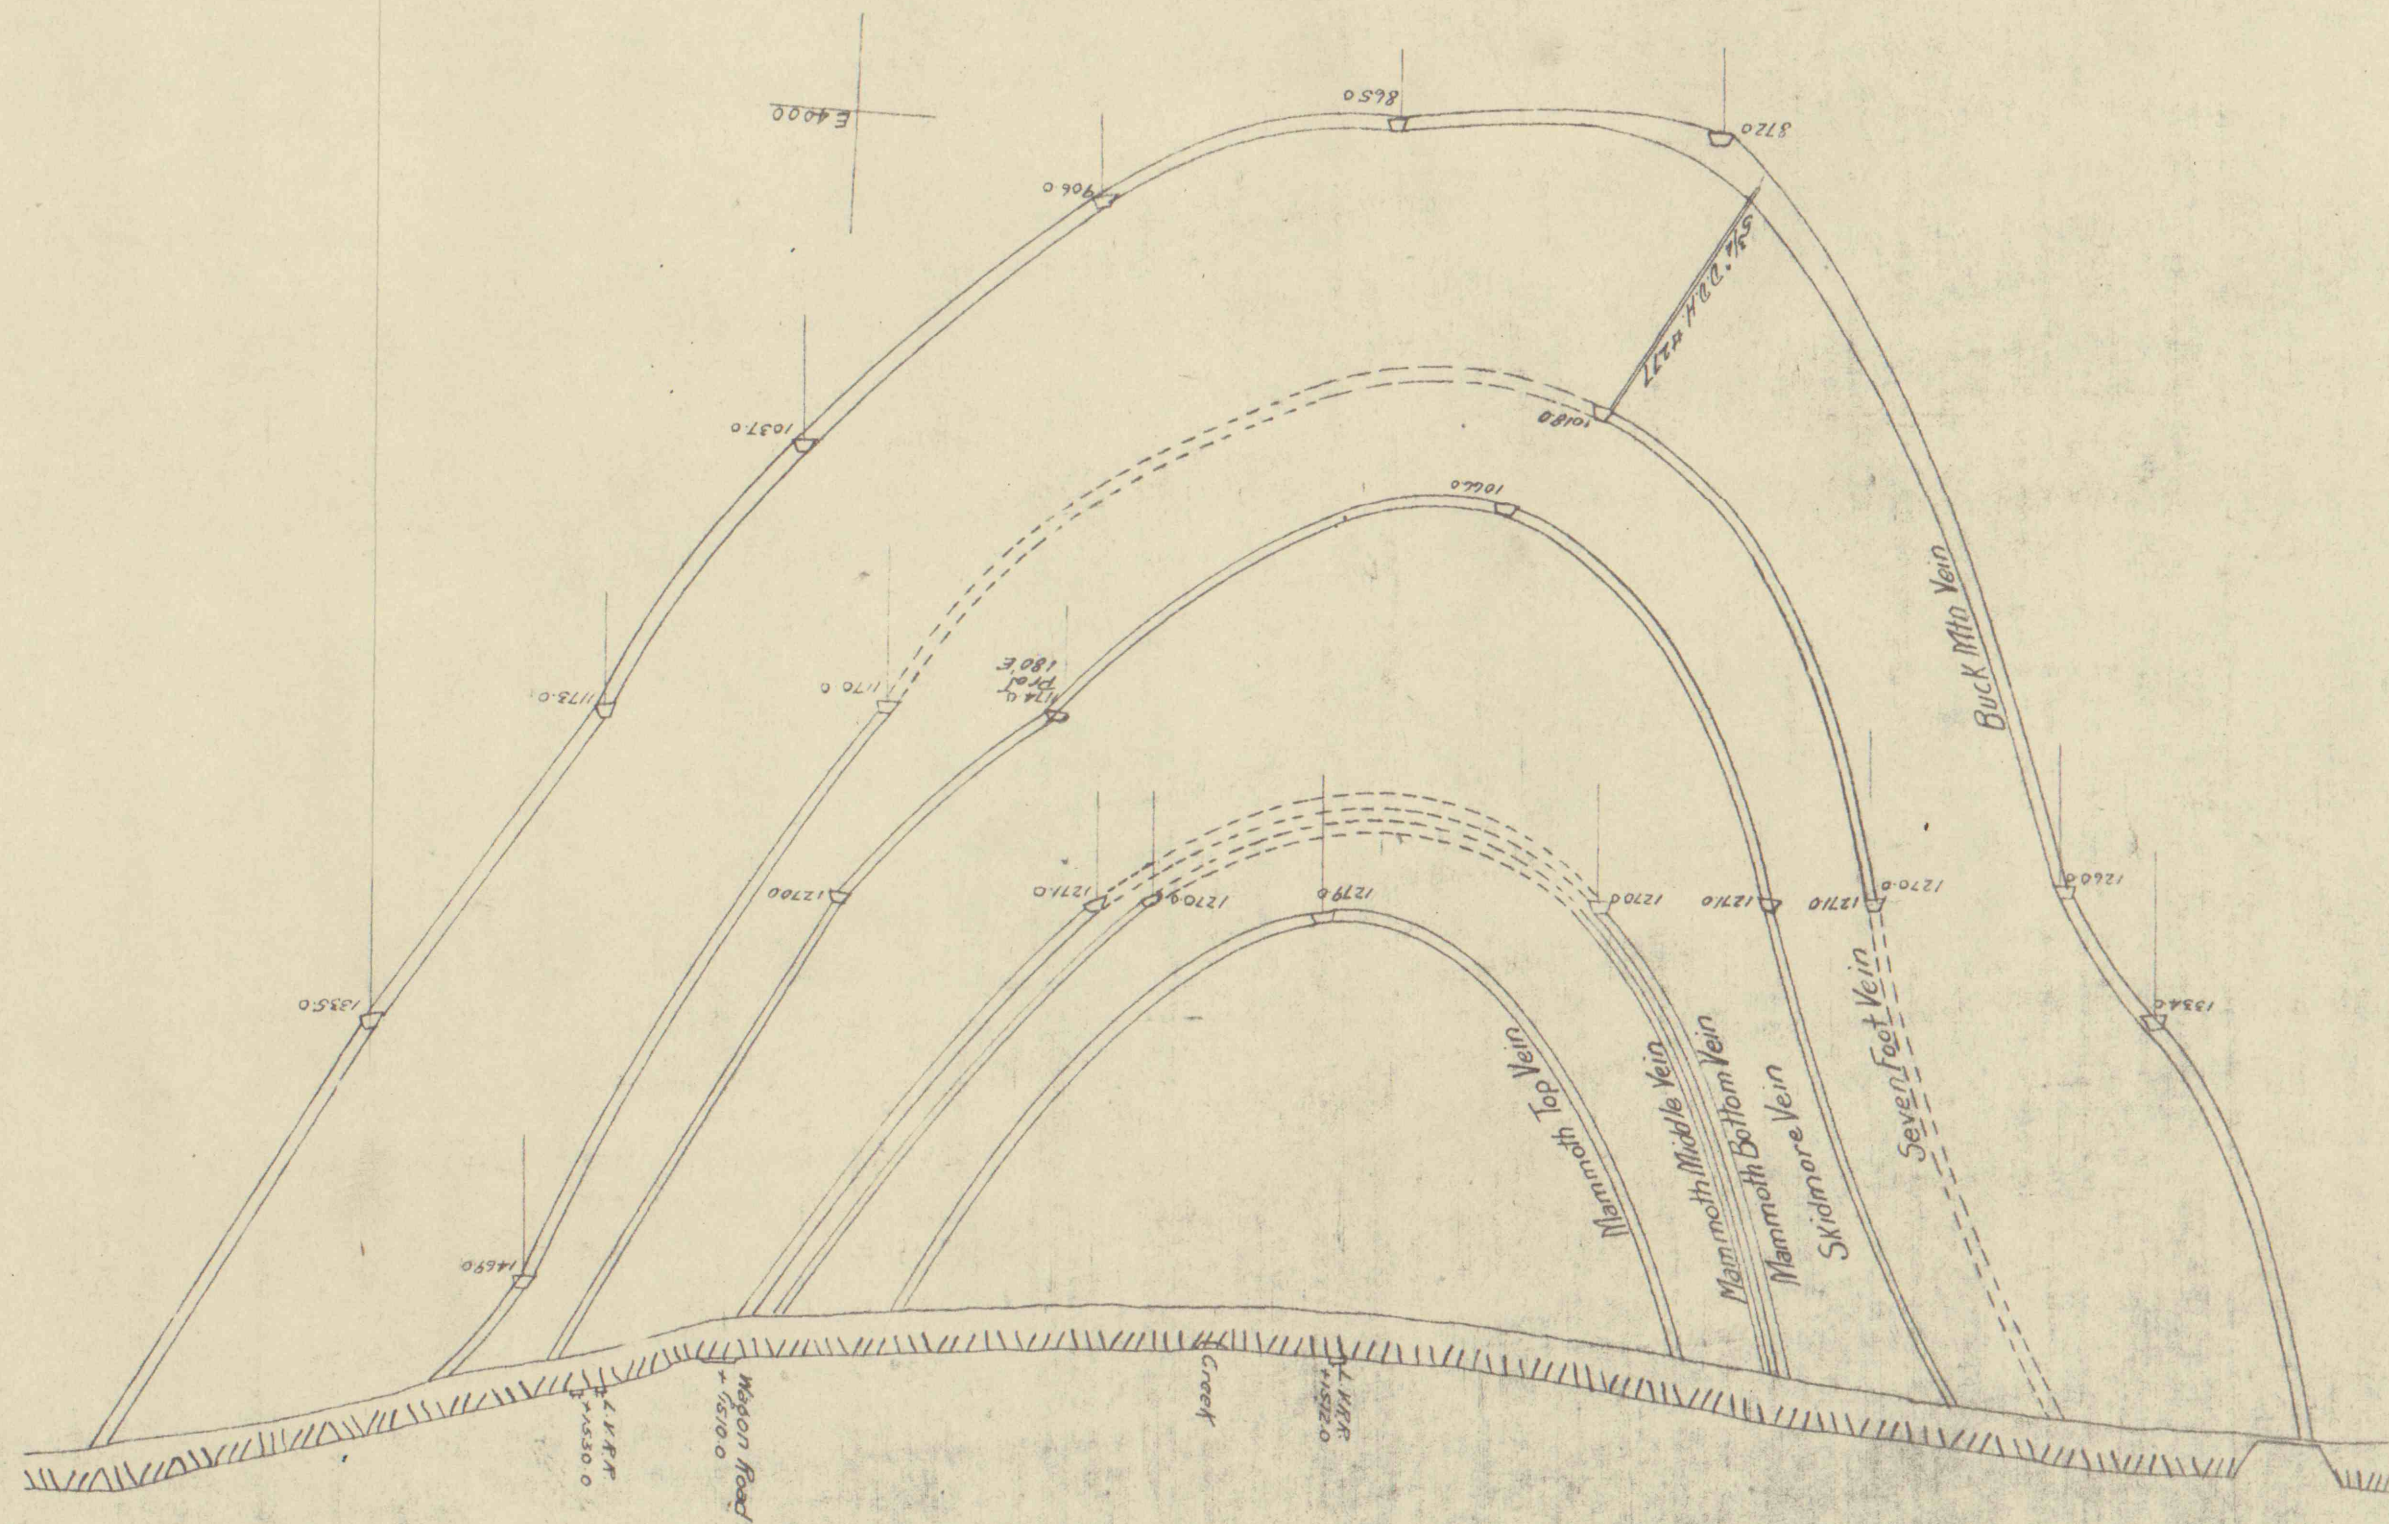

Section 6

Section 6

Section 6