


Bottomwood/Inman Colliery
No. 3 Vein
100' x 100' area
with fault
BMBZ
5454

INMAN COLLIERY
No. 3 VEIN
No. 3

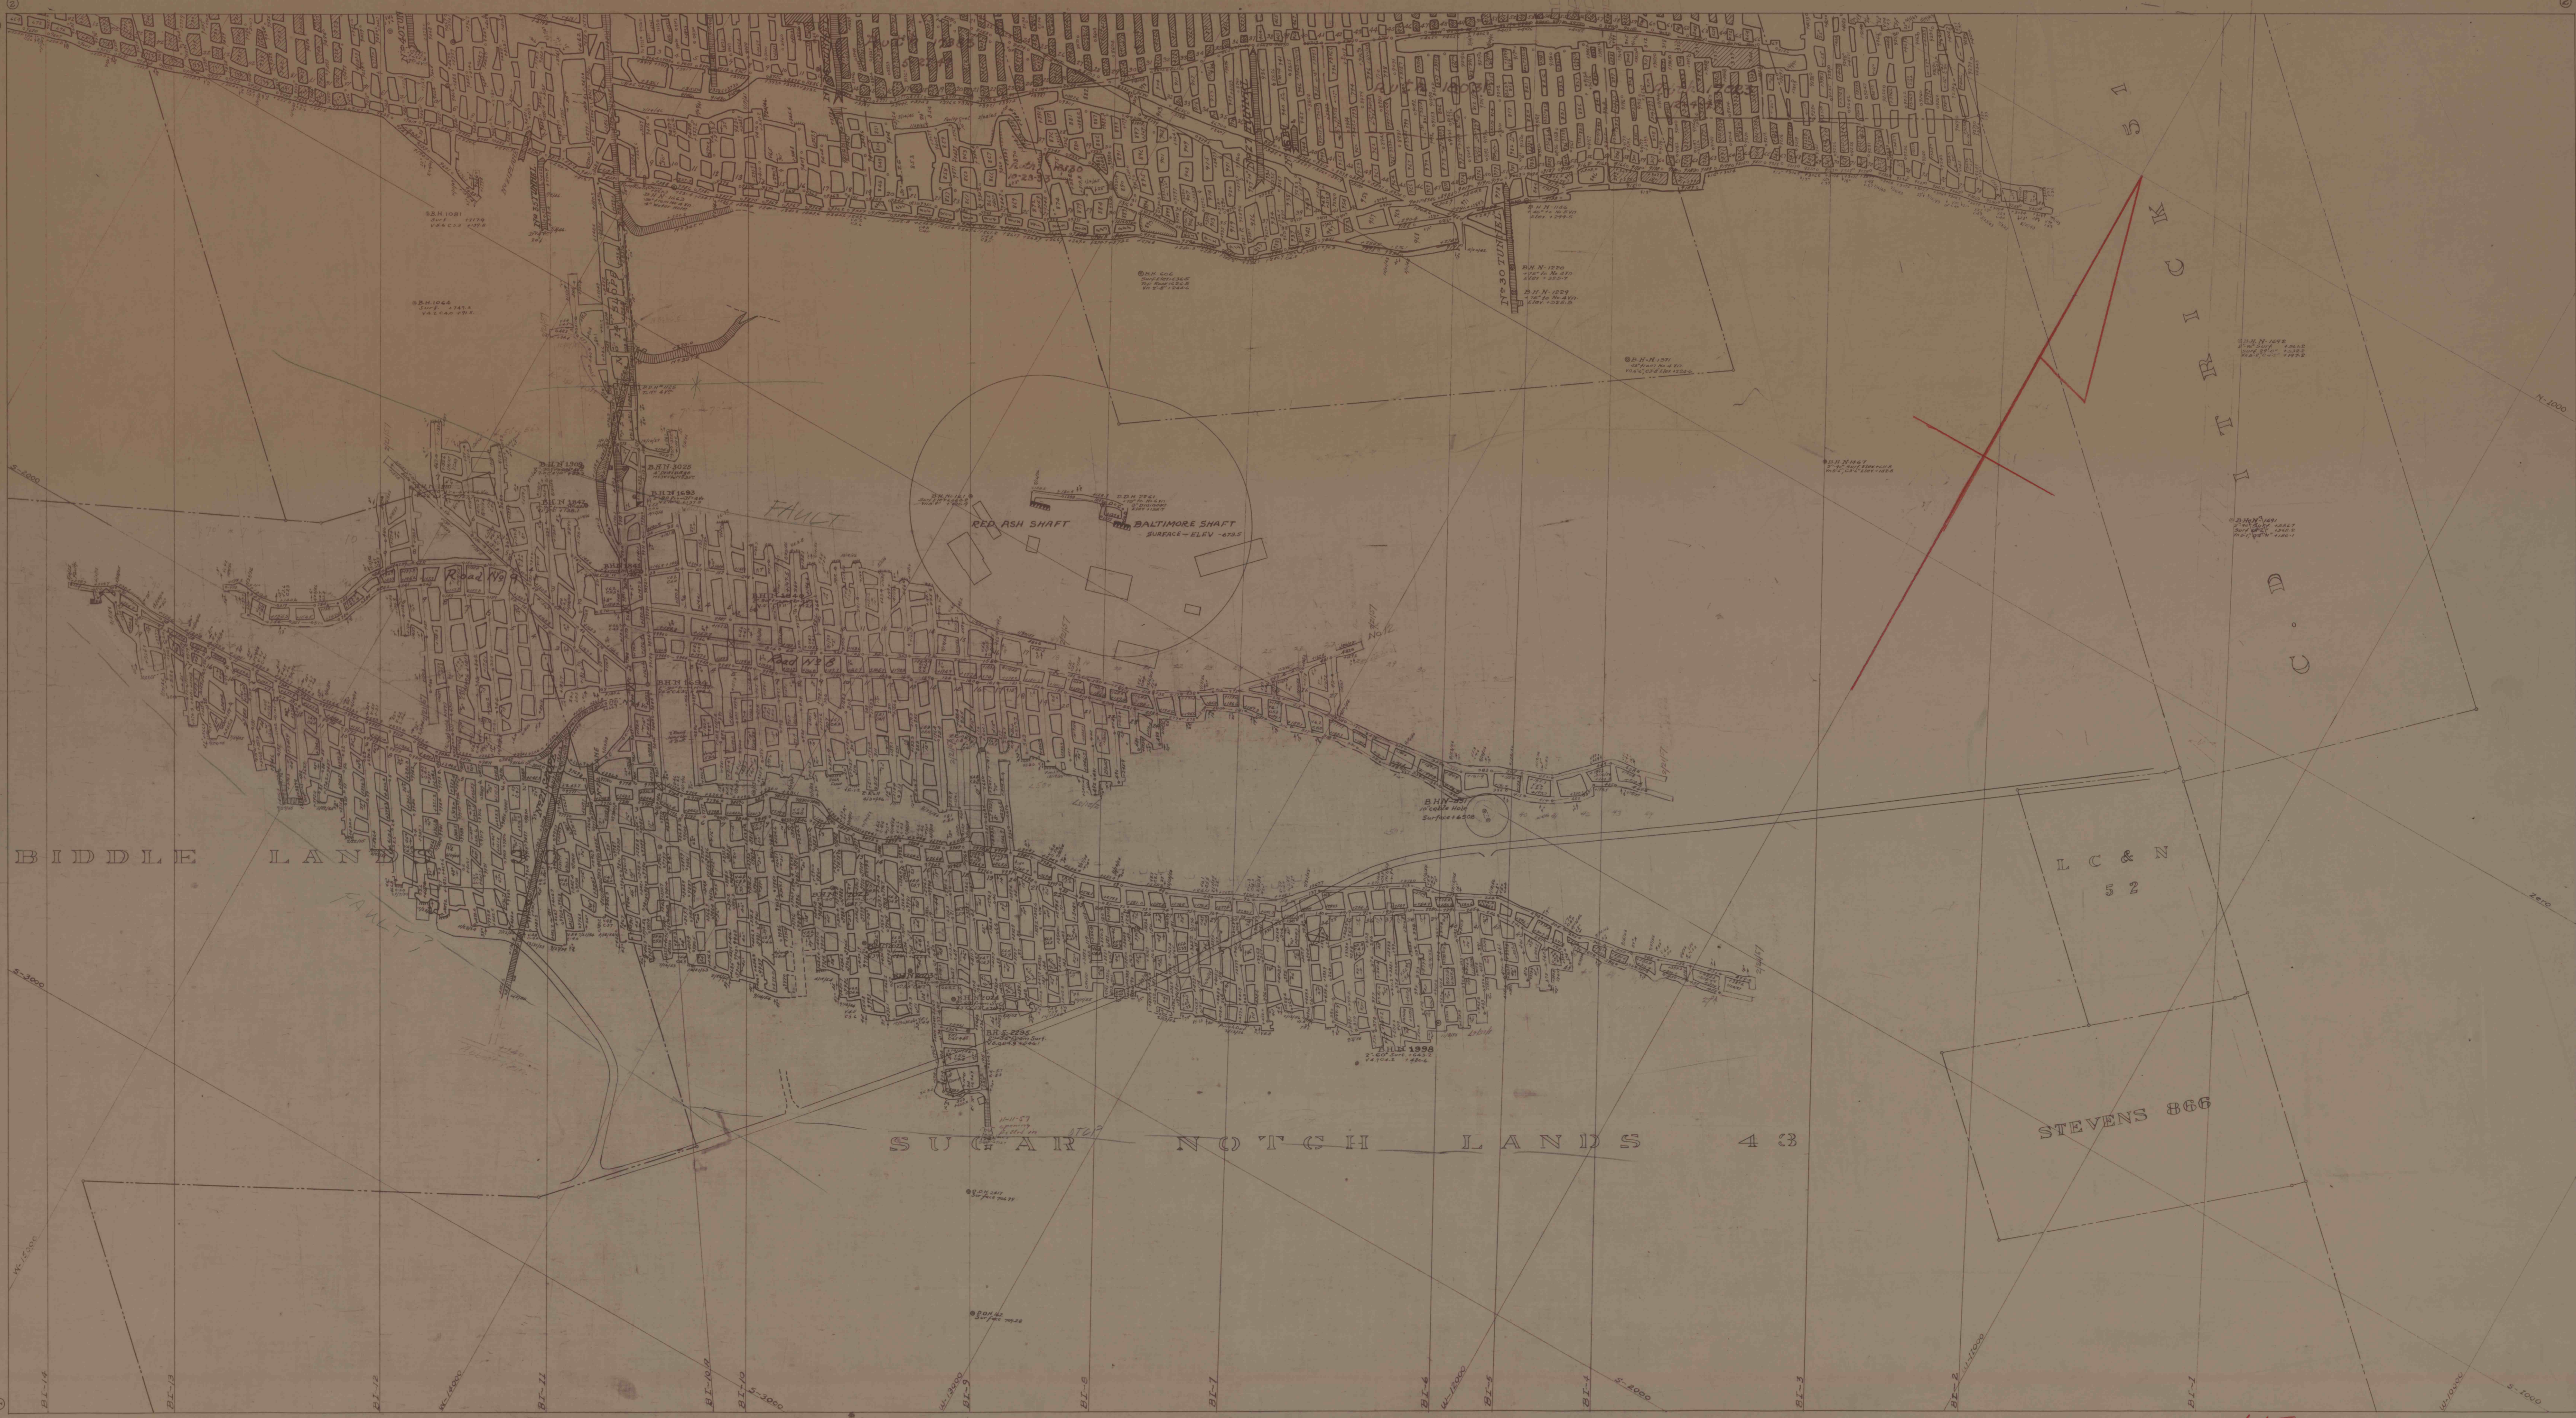

INMAN COLLIERY
No. 3 VEIN
No. 3

Bottomwood & Inman
No. 3 Vein #3
Scale 1" = 100'