


No 3 VEIN

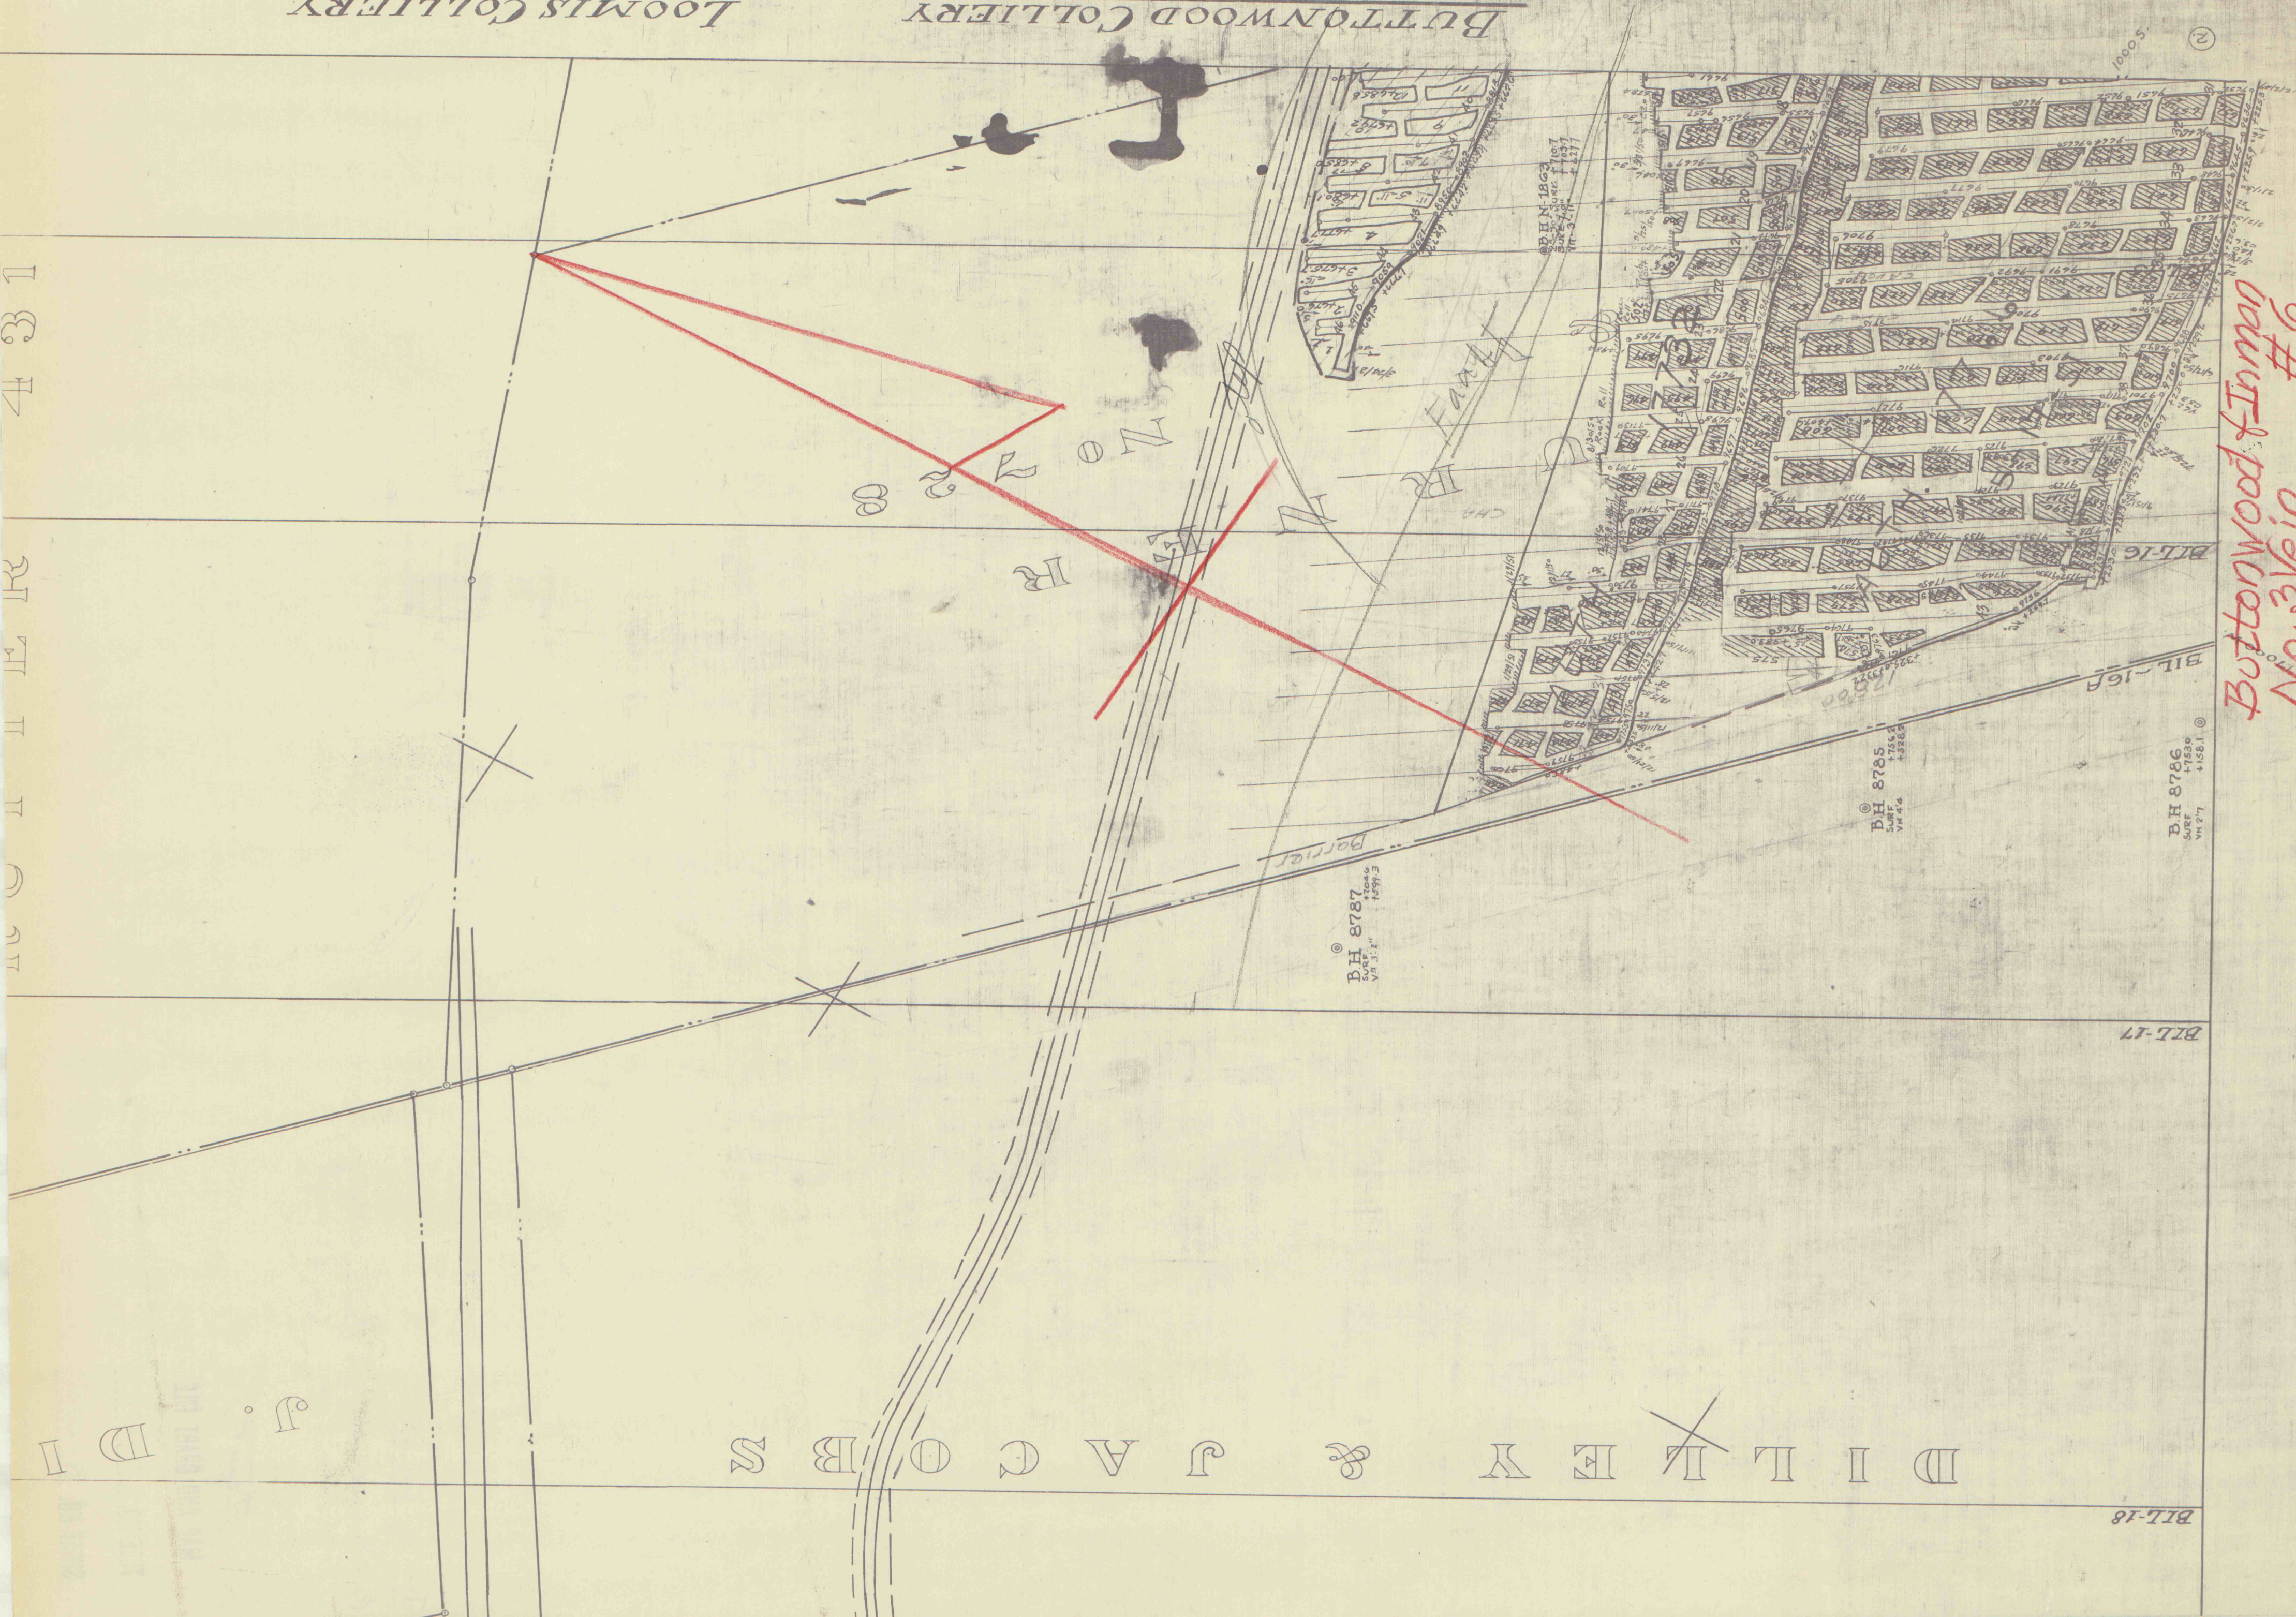

Buttonwood Innman
No. 3 Vein #6
Scale 1" = 100'