


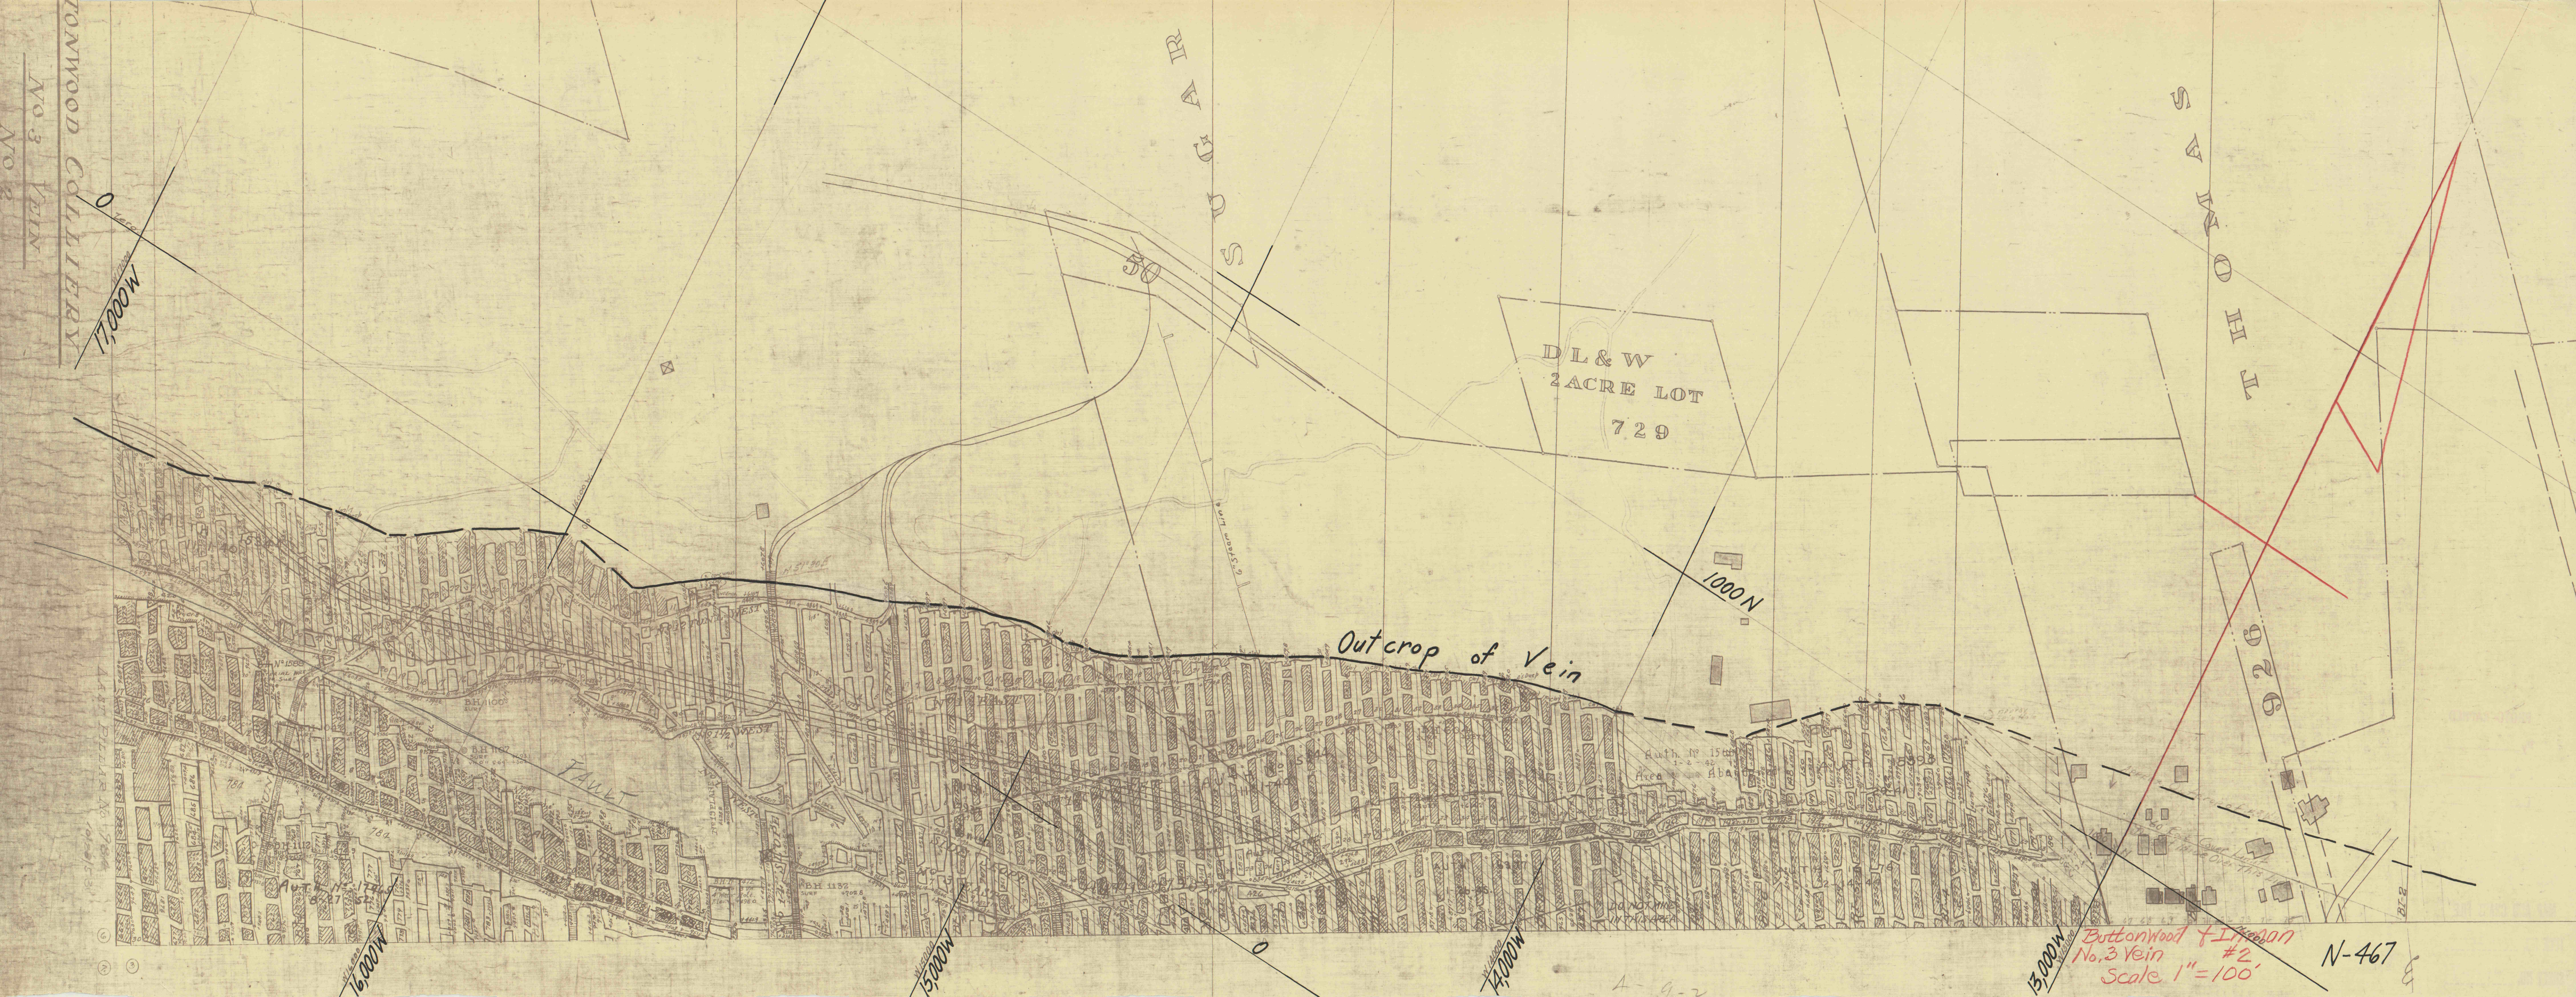

No. 3 Vein

17,000W

D L & W
2 ACRE LOT
729

1000N

Outcrop of Vein

920

No. 3 Vein #2
Scale 1"=100'

N-467

16,000W

15,000W

14,000W

13,000W

A-9-2