


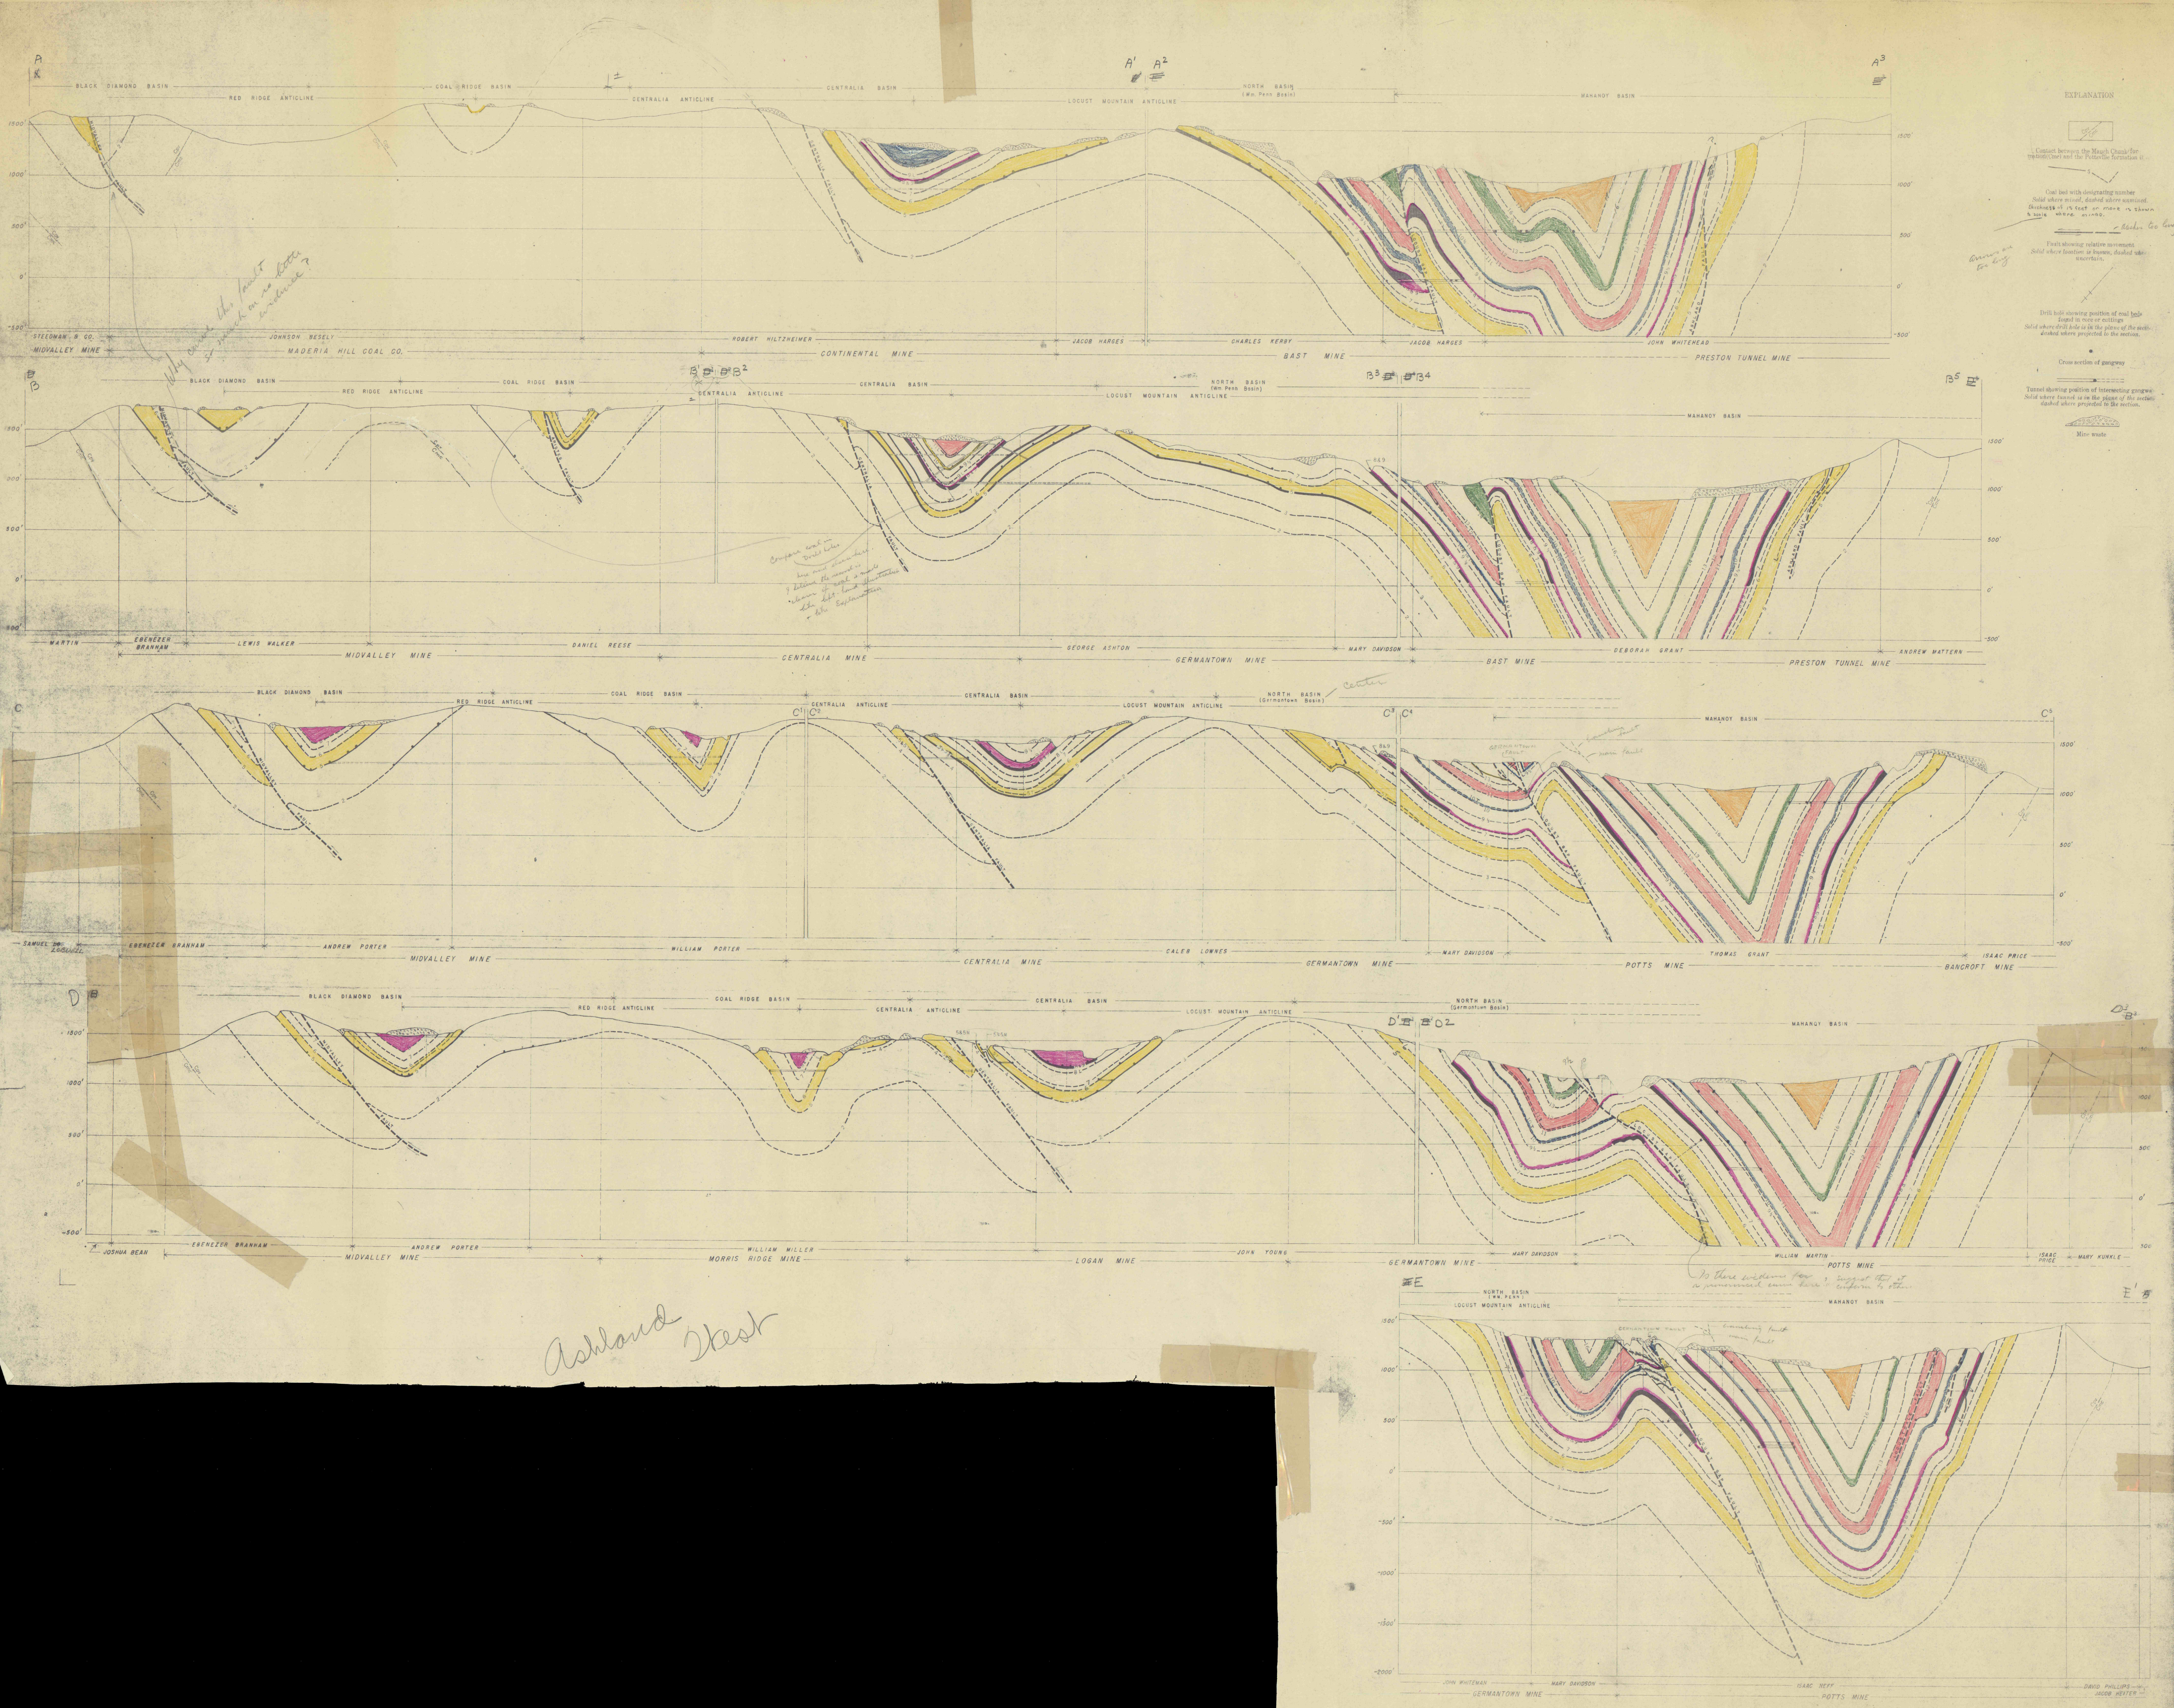

Ashtland West



Ashtland West