

RECEIVED
FEB 18 1894
U.S. GEOLOGICAL SURVEY

EXPLANATION




Note -
These sections have
been changed at the
top and bottom.

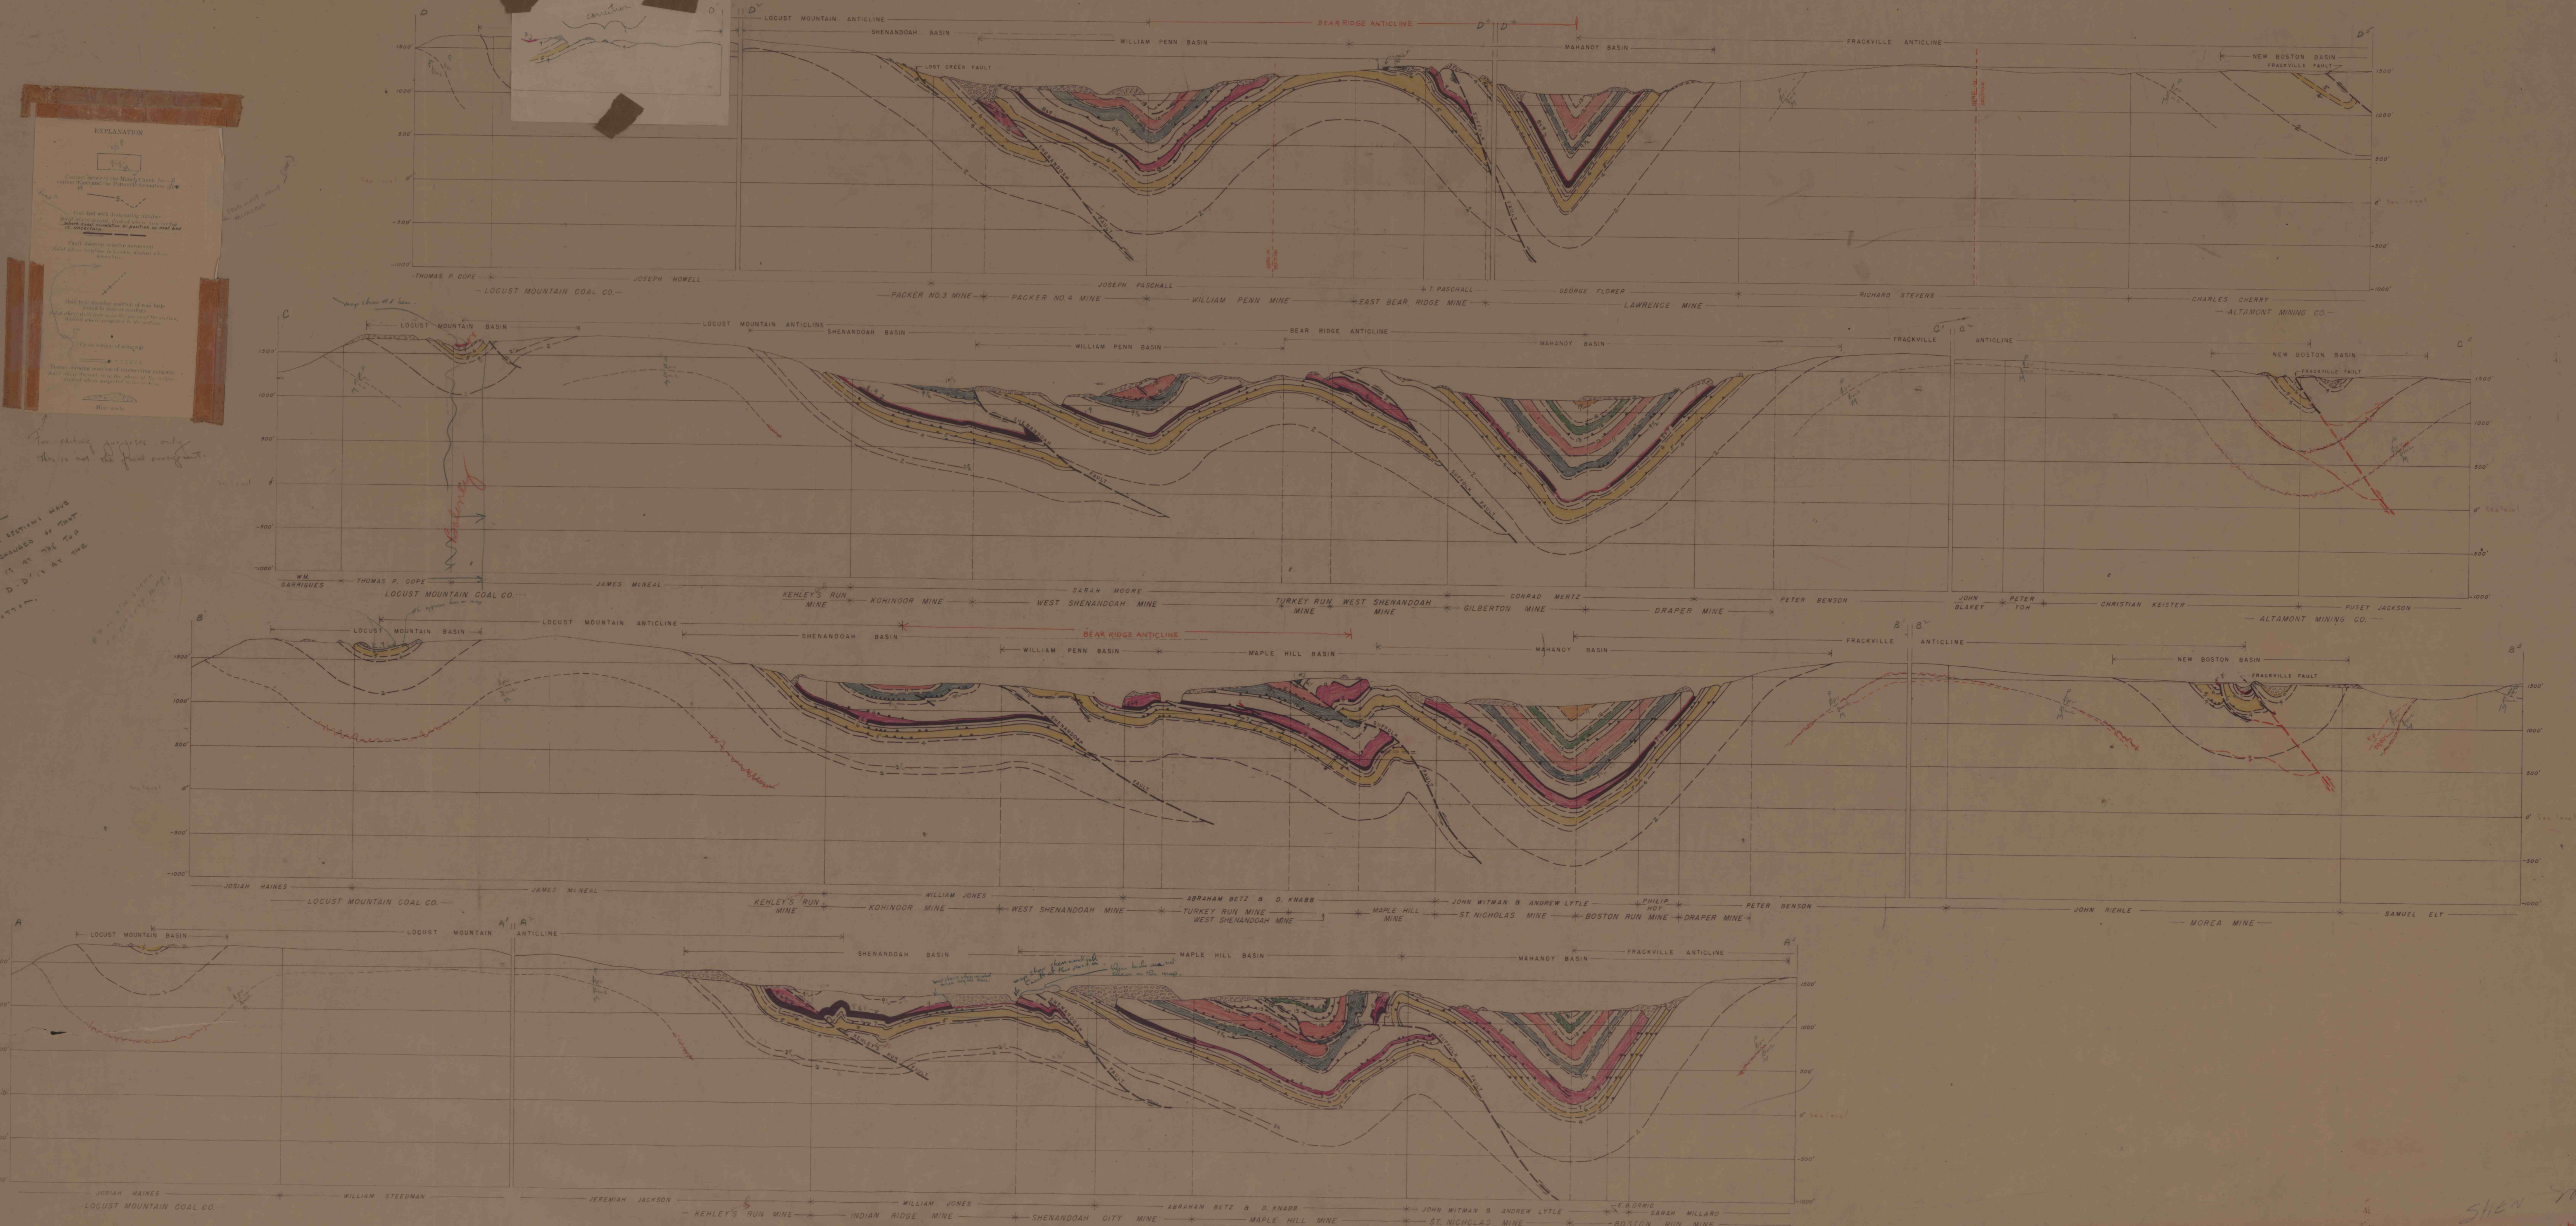

STRUCTURAL CROSS SECTIONS

SCALE 1:2000

0 100 200 300 400 500 600 700 800 900 1000

Shen. V.
fasten
copy to map reproduction
as of August 30, 1954.