
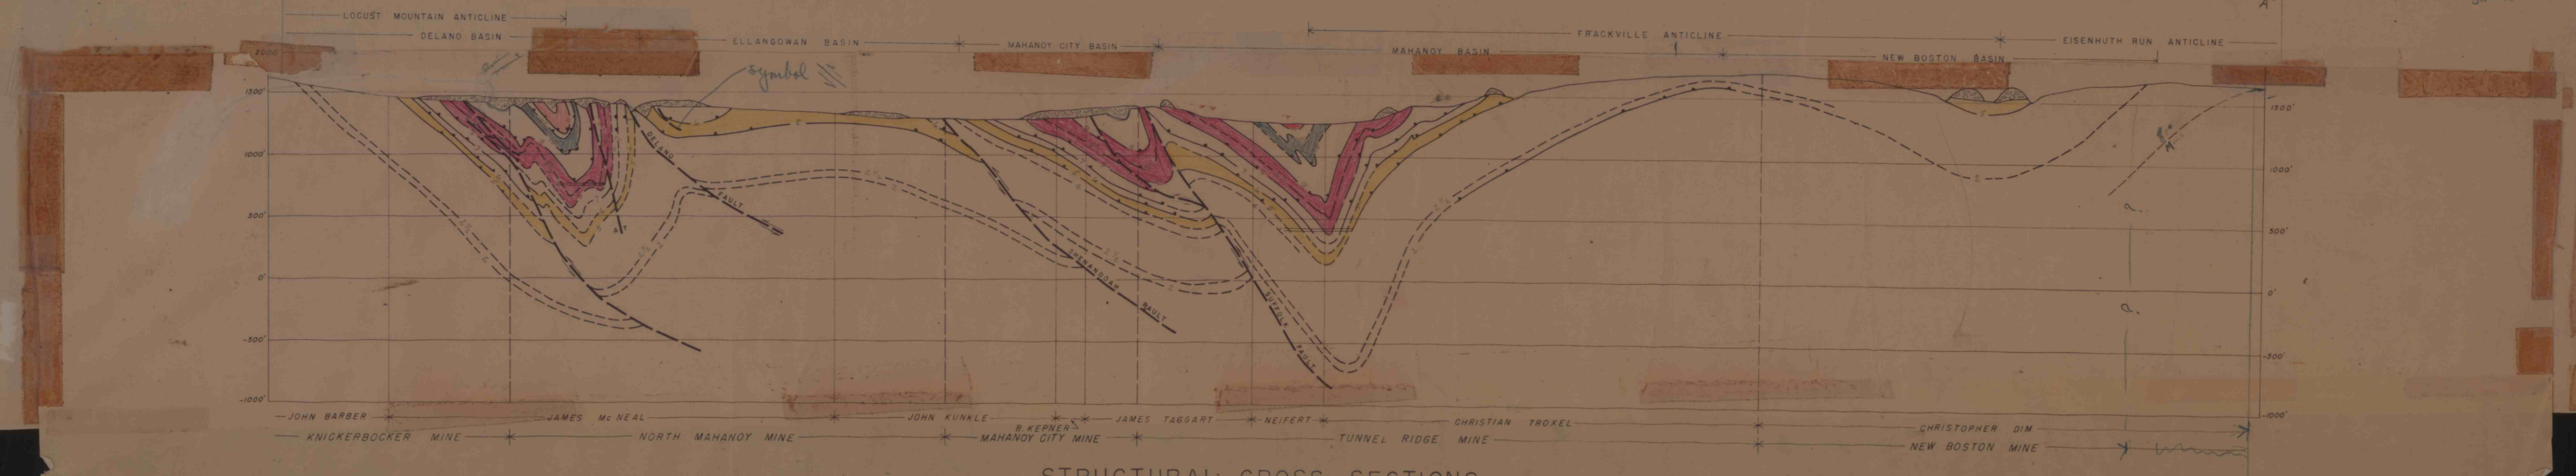
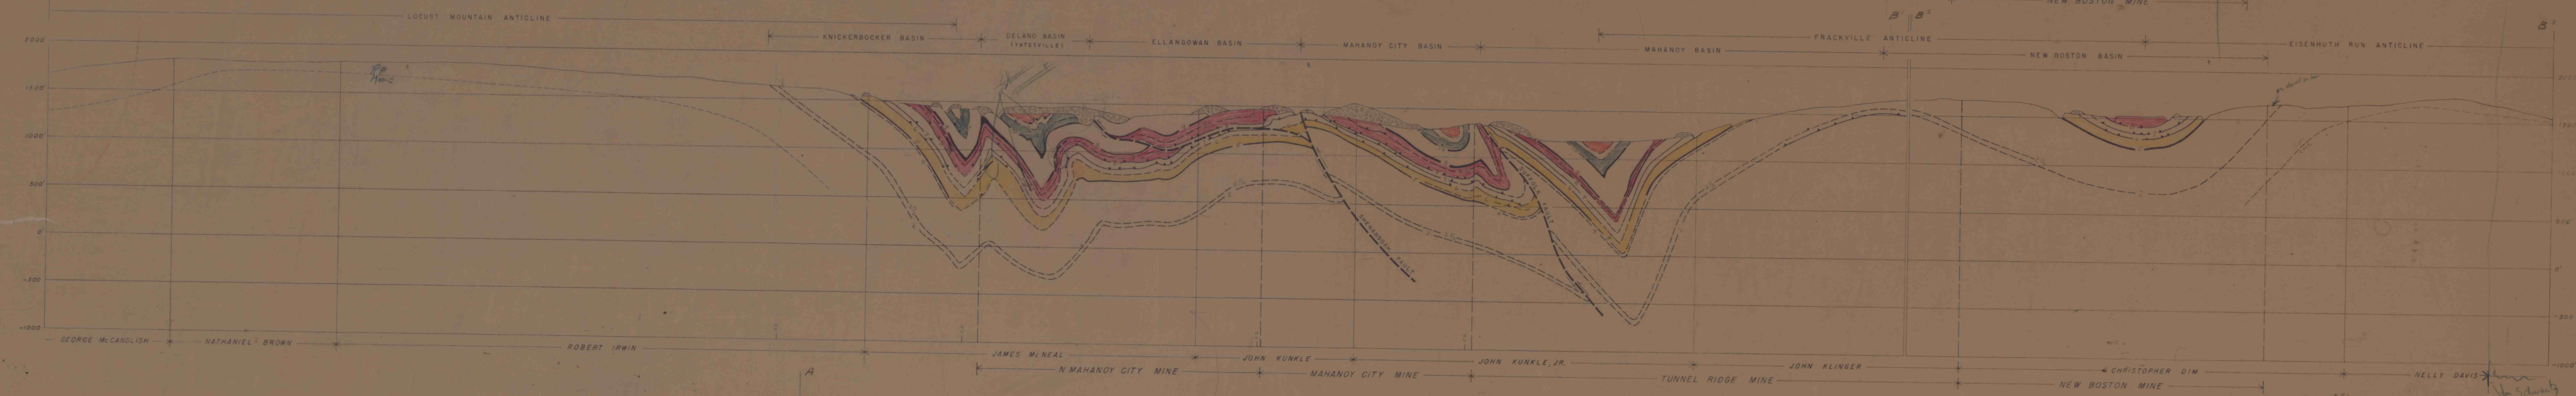
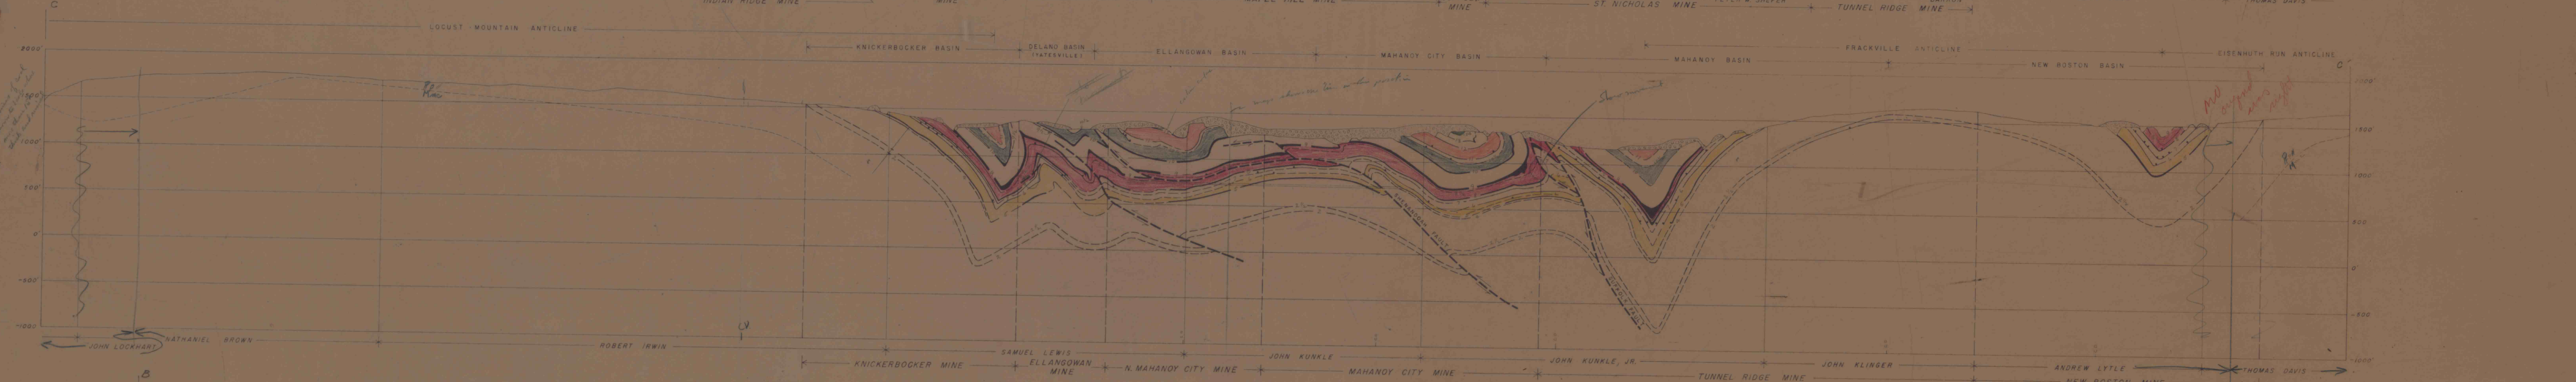


The following is a list of the names of the mines and basins shown on the map, in the order in which they appear from west to east:  
 Locust Mountain Basin, Locust Mountain Anticline, Knickerbocker Basin, Hill Basin, Mahand City Basin, Mahand Basin, Frackville Anticline, New Boston Basin, Eisenhuth Run Anticline.  
 The names of the mines are given in the order in which they appear from west to east:  
 John Lockhart, Josiah Haines, Daniel Brorst, William Steedman, Kehley's Run Mine, Indian Ridge Mine, Evan Owens, Shenandoah City Mine, Ellangowan Mine, John Kunkle, Maple Hill Mine, Suffolk Mine, John Witman & Andrew Lytle, St. Nicholas Mine, Peter W. Sheffer, Tunnel Ridge Mine, John Barron, John Cole, Thomas Davis.

Note -  
 These & other mines  
 have been located by map  
 A-A' is at the top  
 and B-B' is at the bottom.

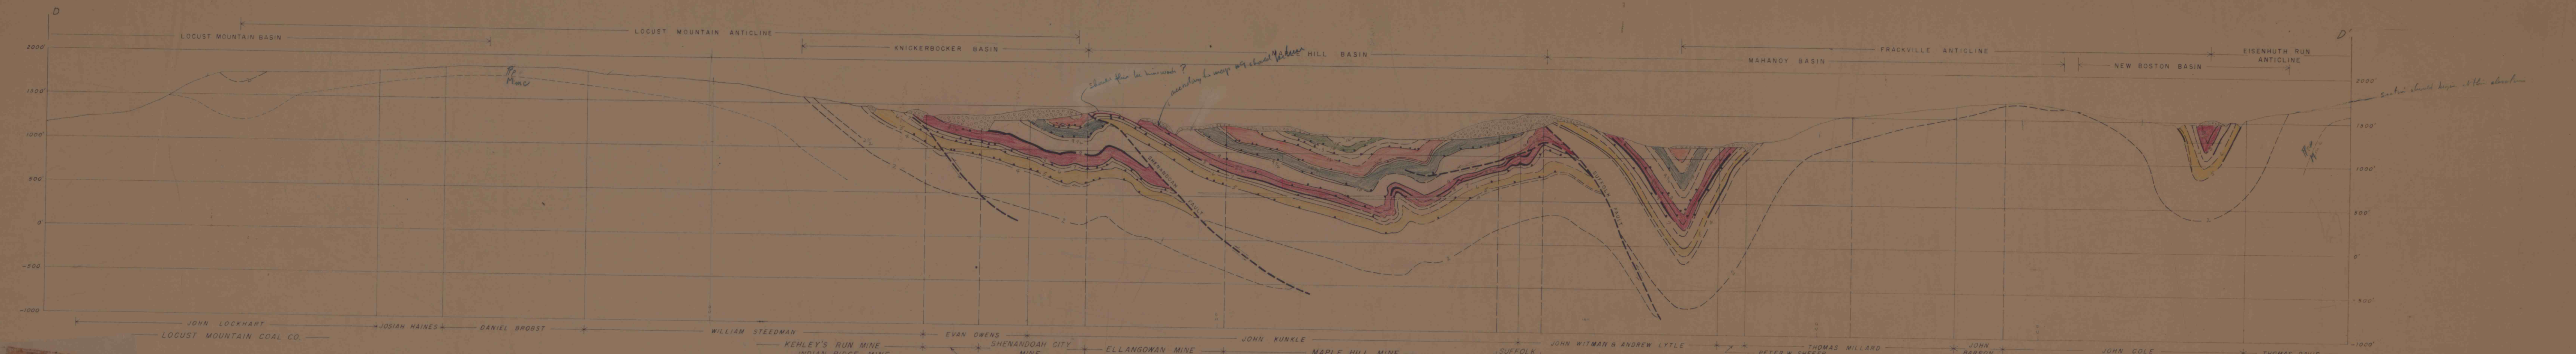

STRUCTURAL CROSS SECTIONS

SCALE 1:20,000

RECEIVED  
 FEB 19 1904  
 GEOLOGICAL SURVEY

W 679