


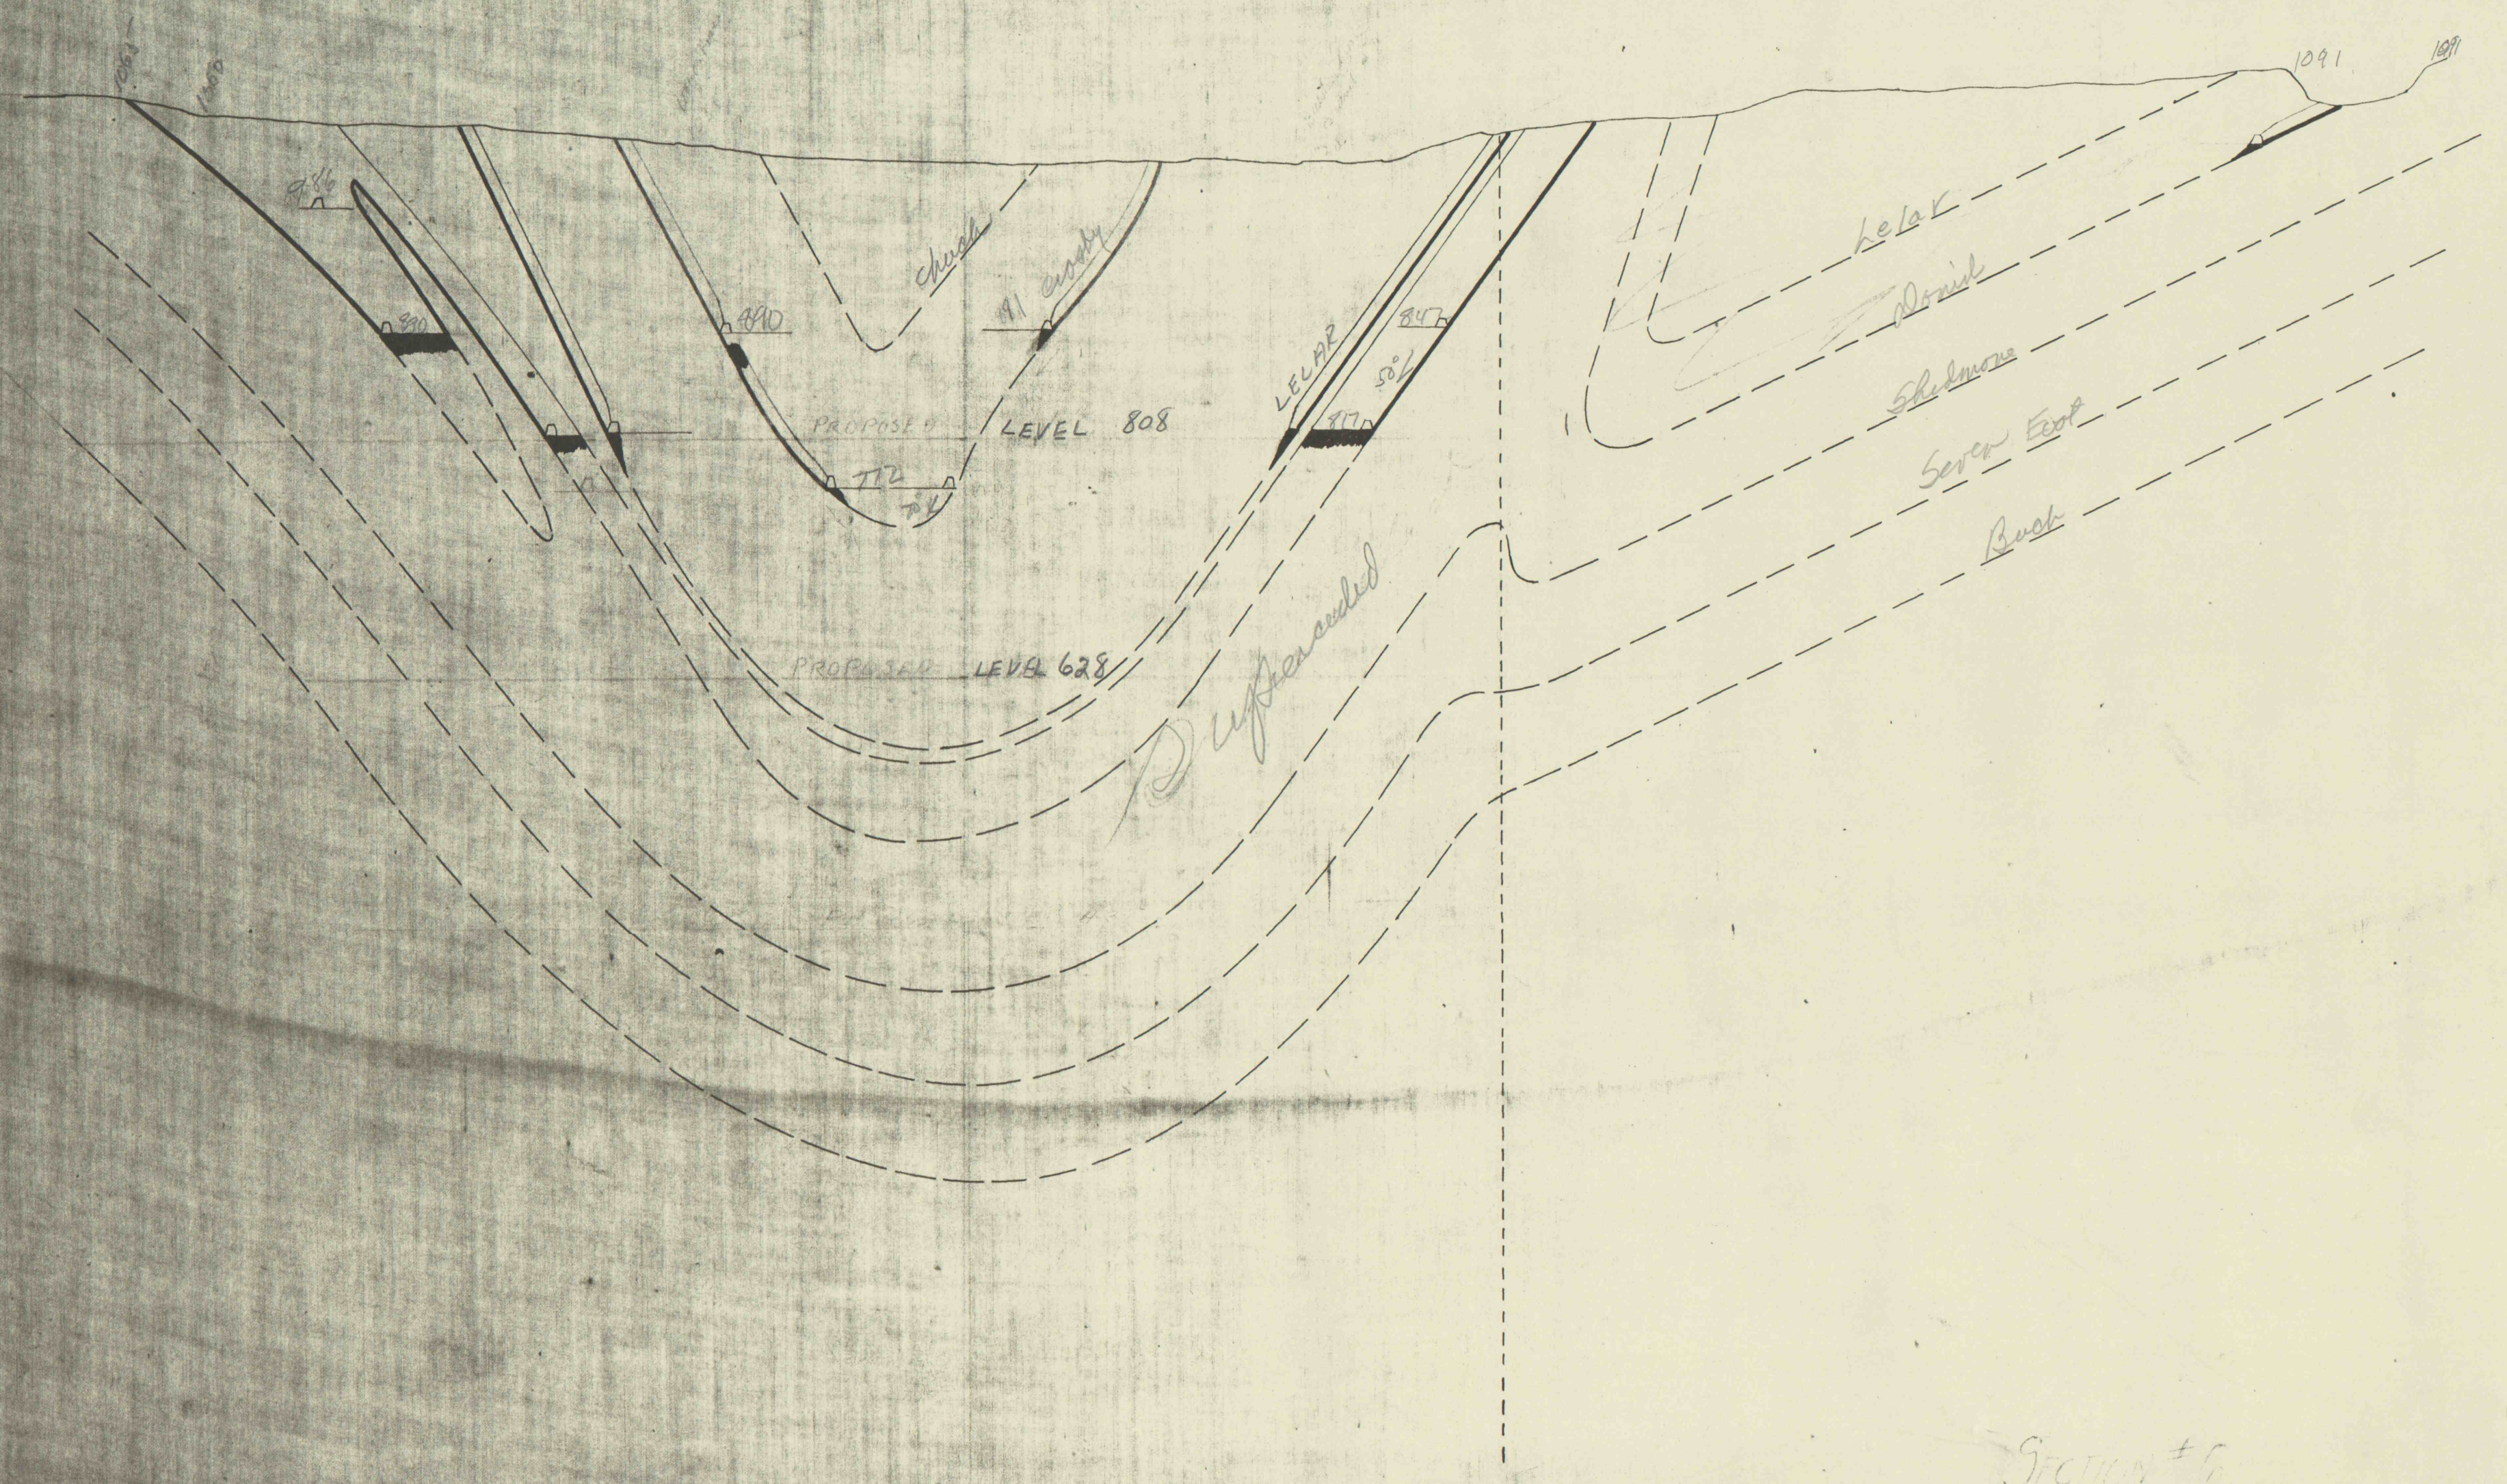

SECTION #6

Pine Knot 6 #6