#11

PINE KNOT COLLIERY.

SECTION #11

SECTION 7800' EAST OF NO.1 SHAFT.

SECTION LOOKING WEST

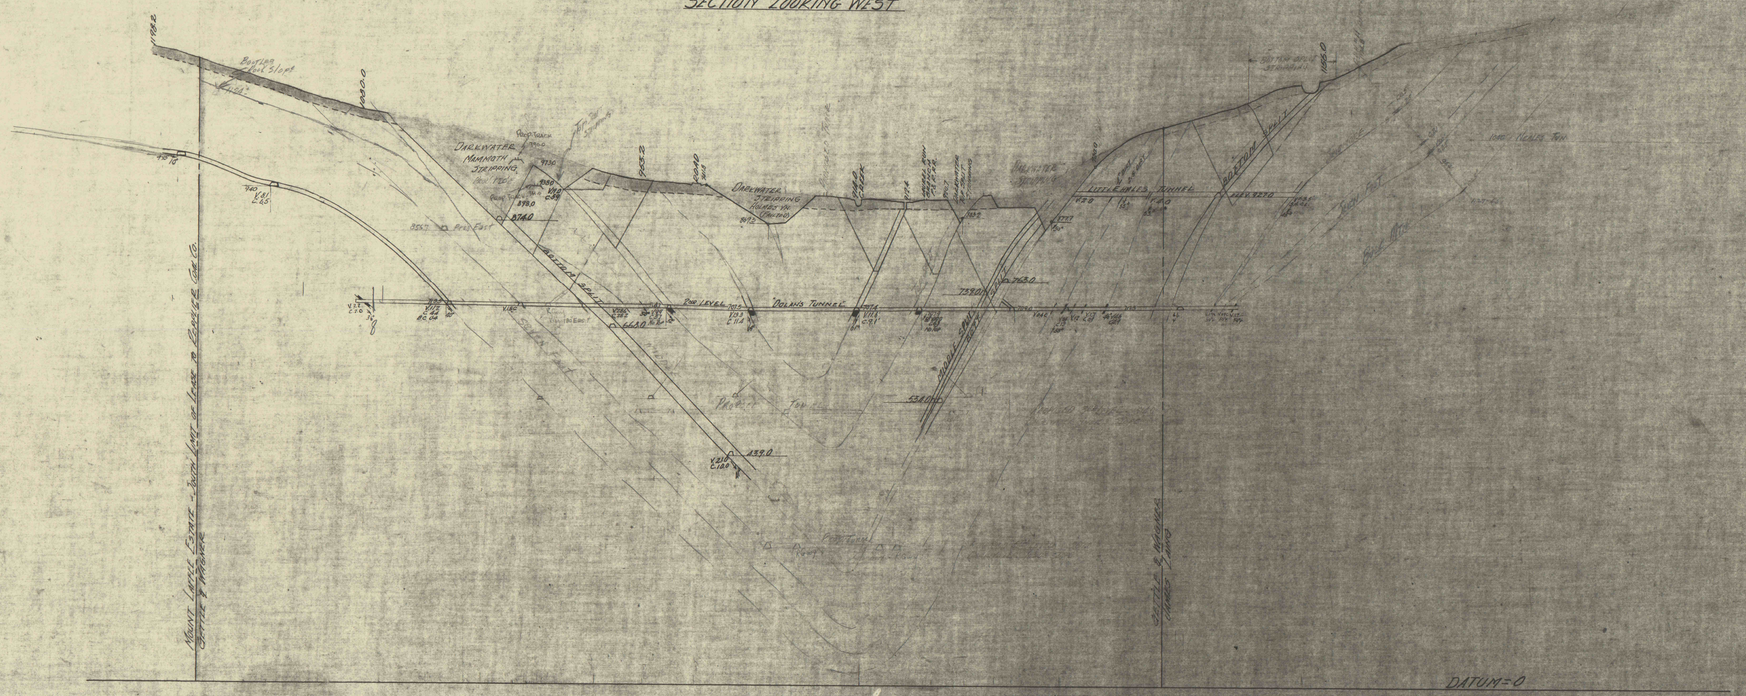

Pine Knot #1