


Rocky #6

1-671

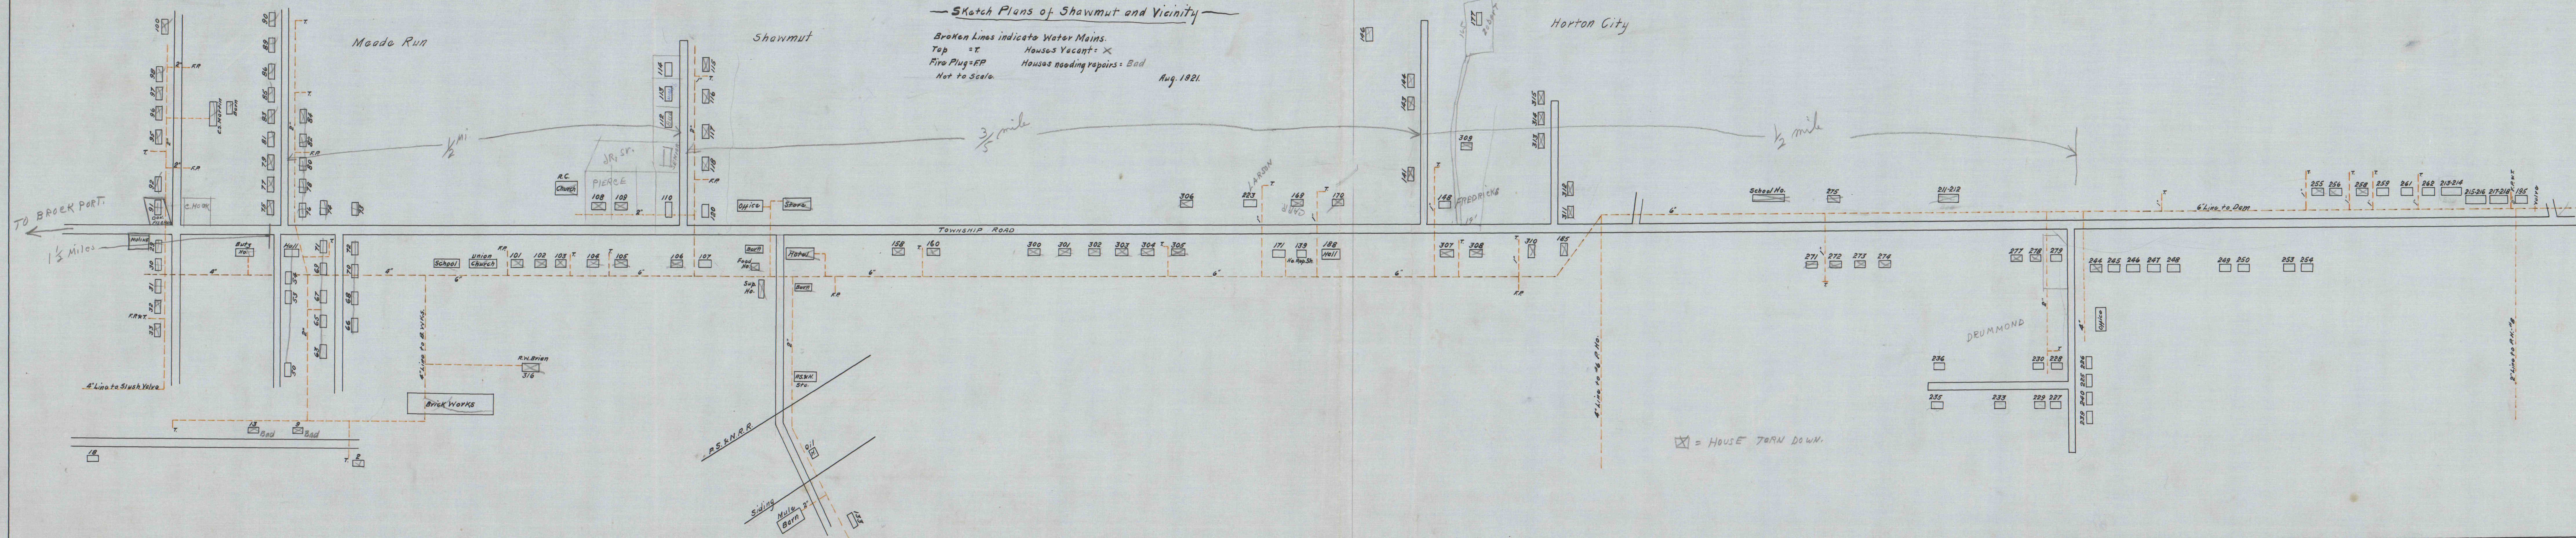

Sketch Plans of Shawmut and Vicinity
Broken Lines indicate Water Mains.
Top = T. Houses Vacant = X
Fire Plug = FP. Houses needing repairs = Bad
Not to Scale.
Aug. 1921.

☒ = HOUSE TORN DOWN.