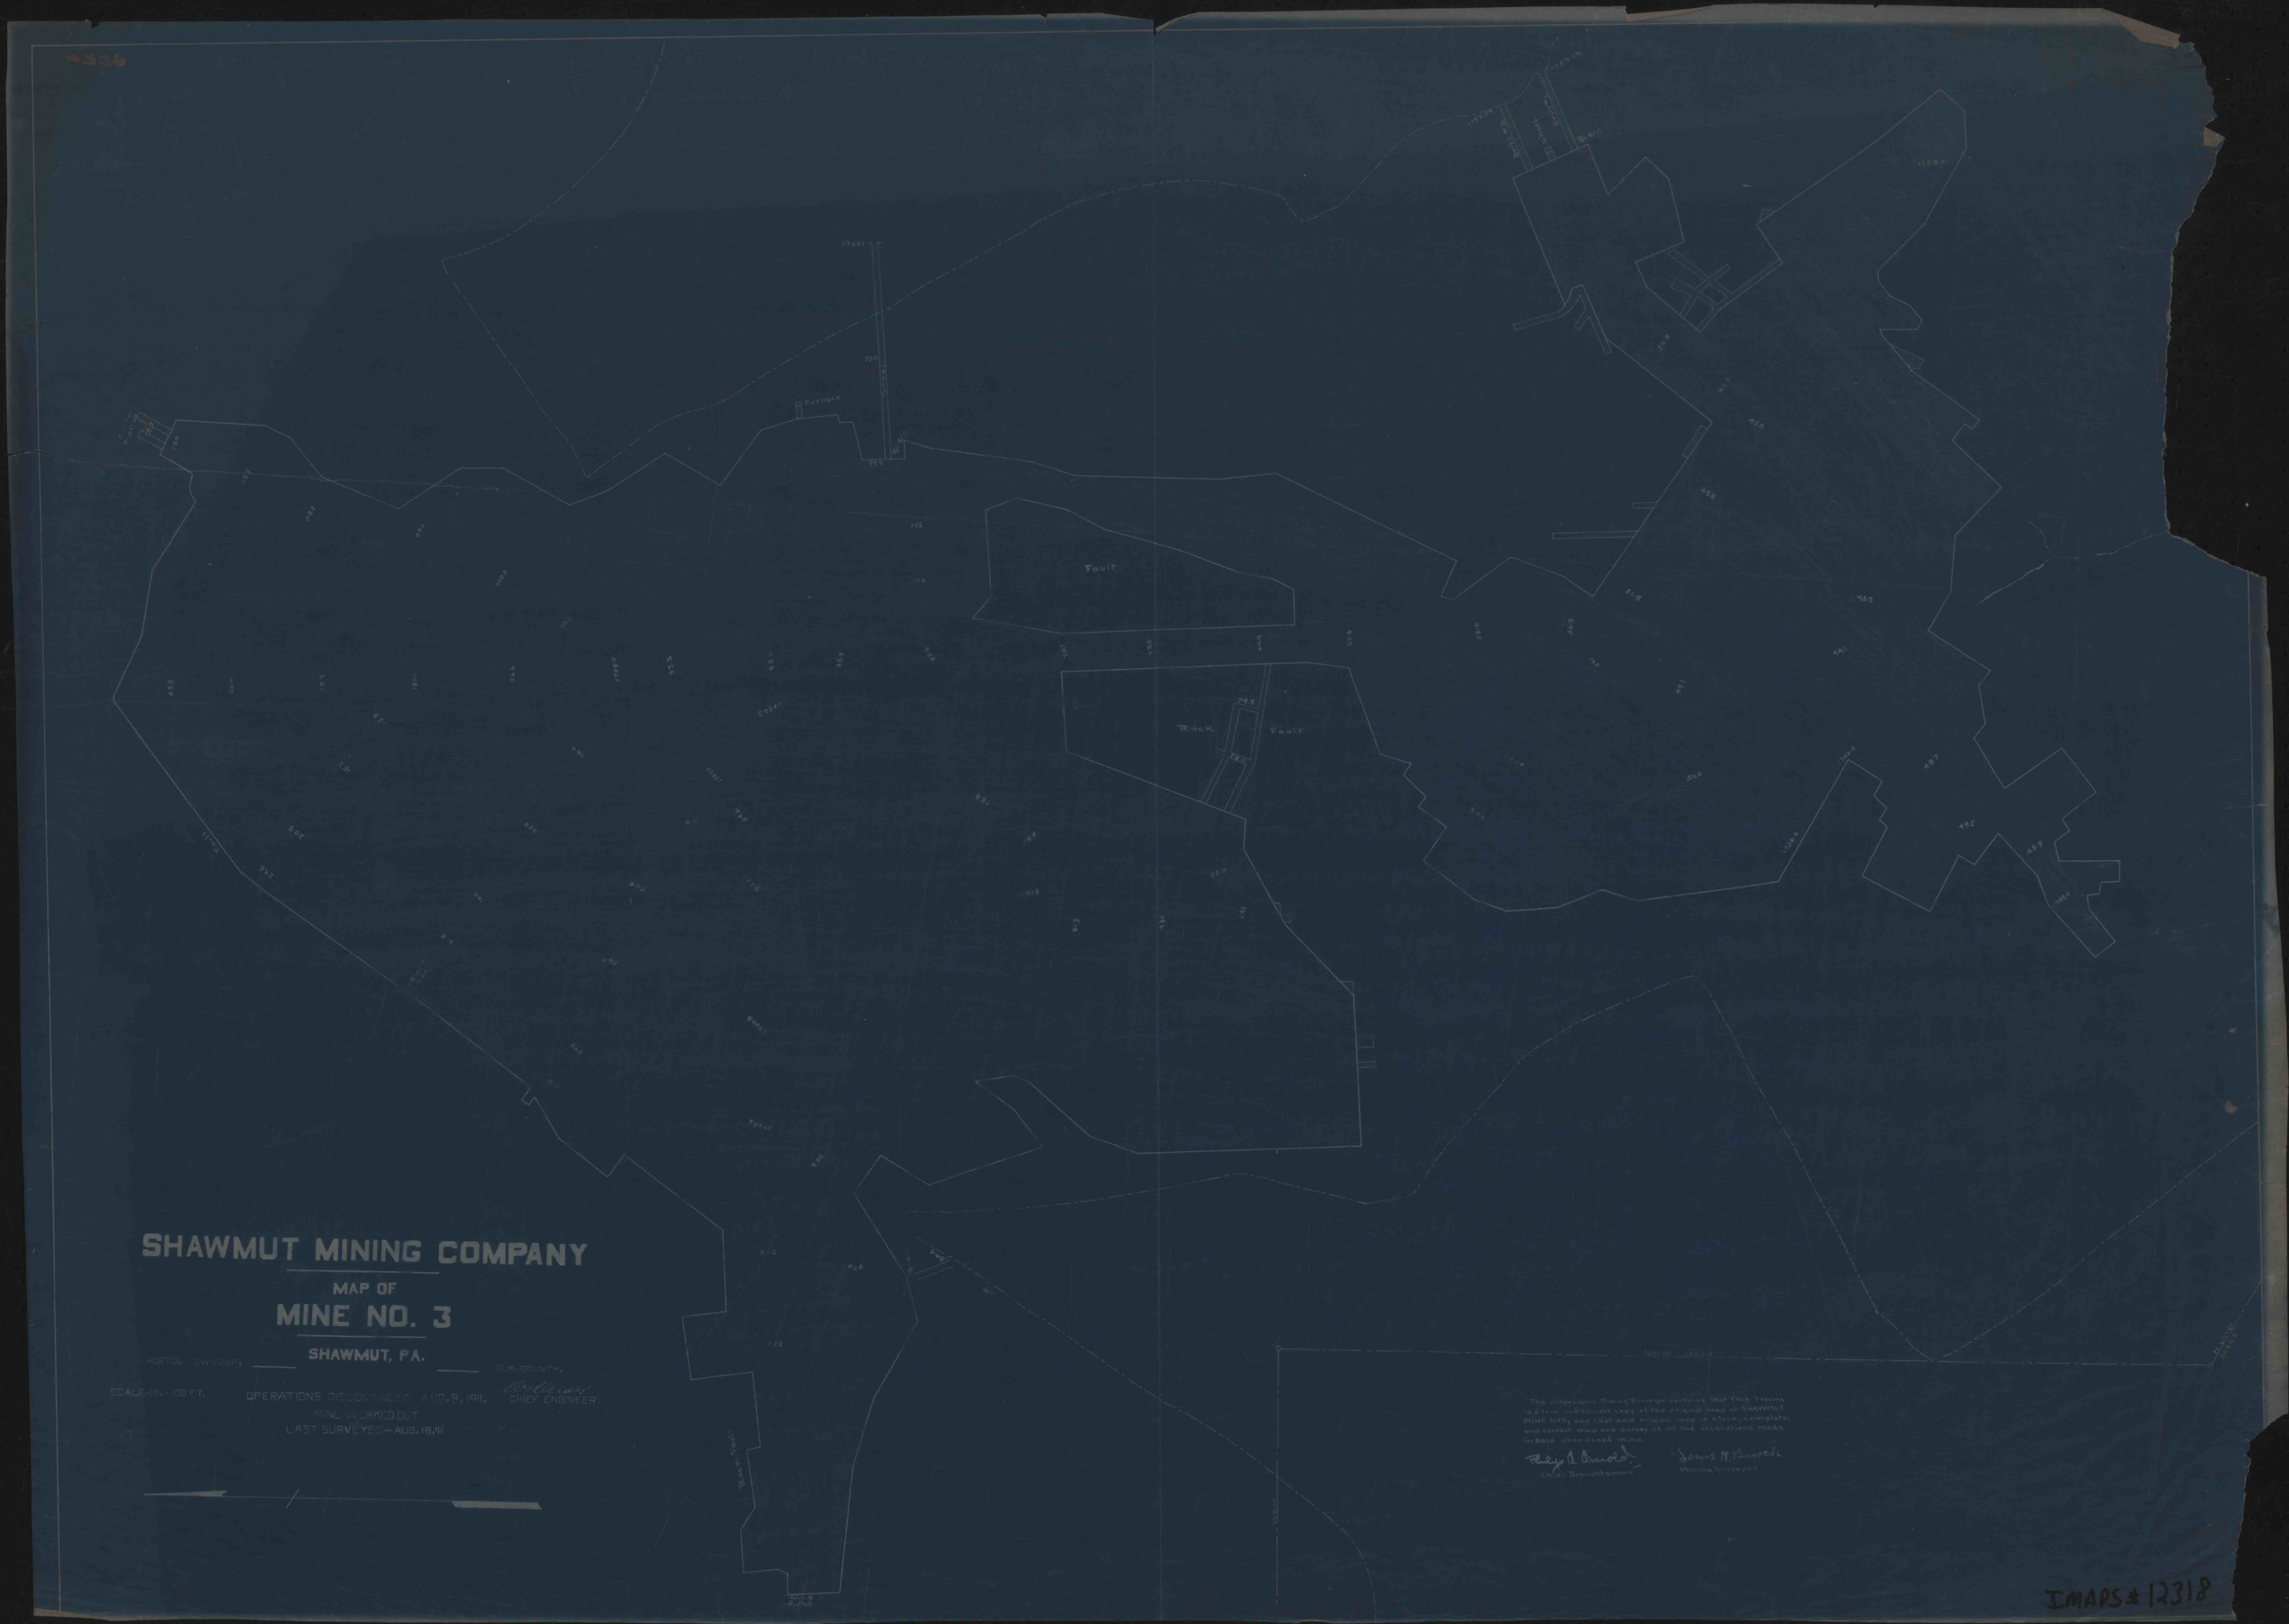
Furnace
Fault
Rock
Fault
SHAWMUT MINING COMPANY
MAP OF
MINE NO. 3
SHAWMUT, PA.
HORTON TOWNSHIP, ELK COUNTY,
SCALE-1IN=100 FT.
OPERATIONS DISCONTINUED AUG. 8, 1911,
MINE WORKED OUT
LAST SURVEYED—AUG. 18, 11
CHIEF ENGINEER.
The undersigned Mining Surveyor certifies that this tracing is a true and correct copy of the original map of SHAWMUT MINE No 3 and that said original map is a true, complete, and correct map and survey of all the excavations made in said abandoned mine.
Chief Draughtsman
Mining Surveyor

IMAPS # 12318