


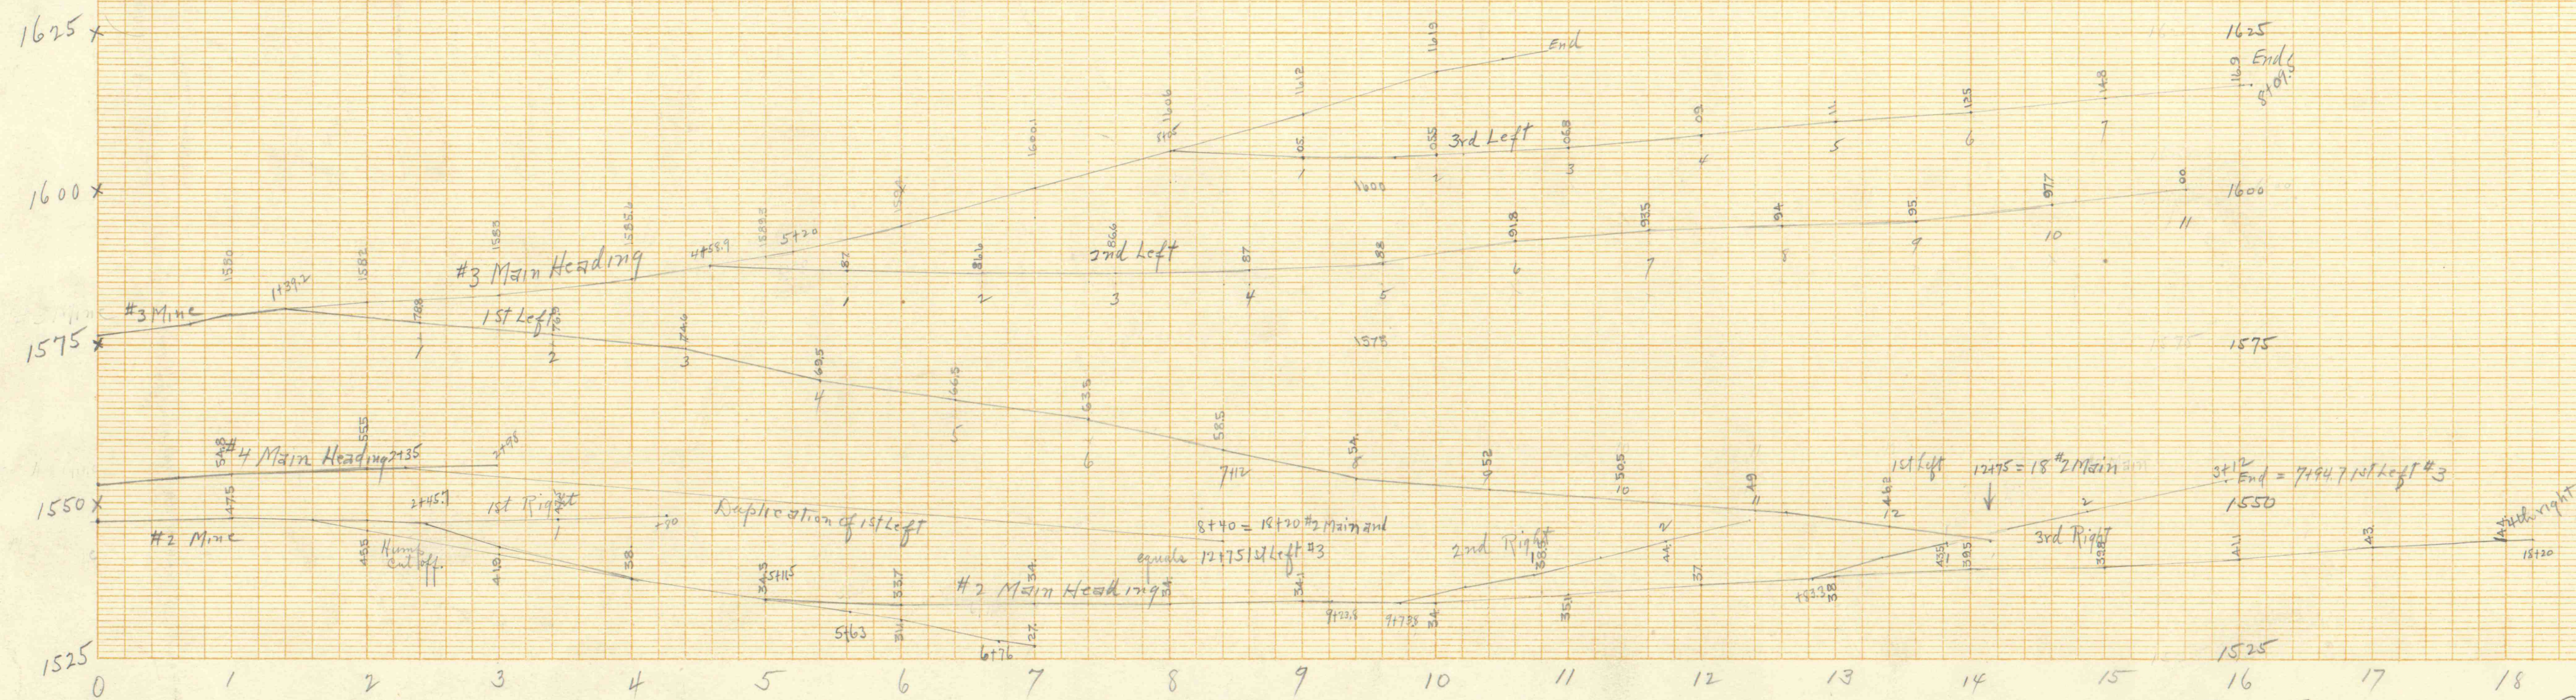

IMAPS# 12320

Toby Coal Mining Co. Brockwayville Pa
 Profile Sheet Five Points Mine
 Scale Vertical Each line 1' Horizontal " " 20'
 Drawn by Milton Groves
 Jan 20 1921