


143-12
N 13-15
30-07

IMAPS#12321

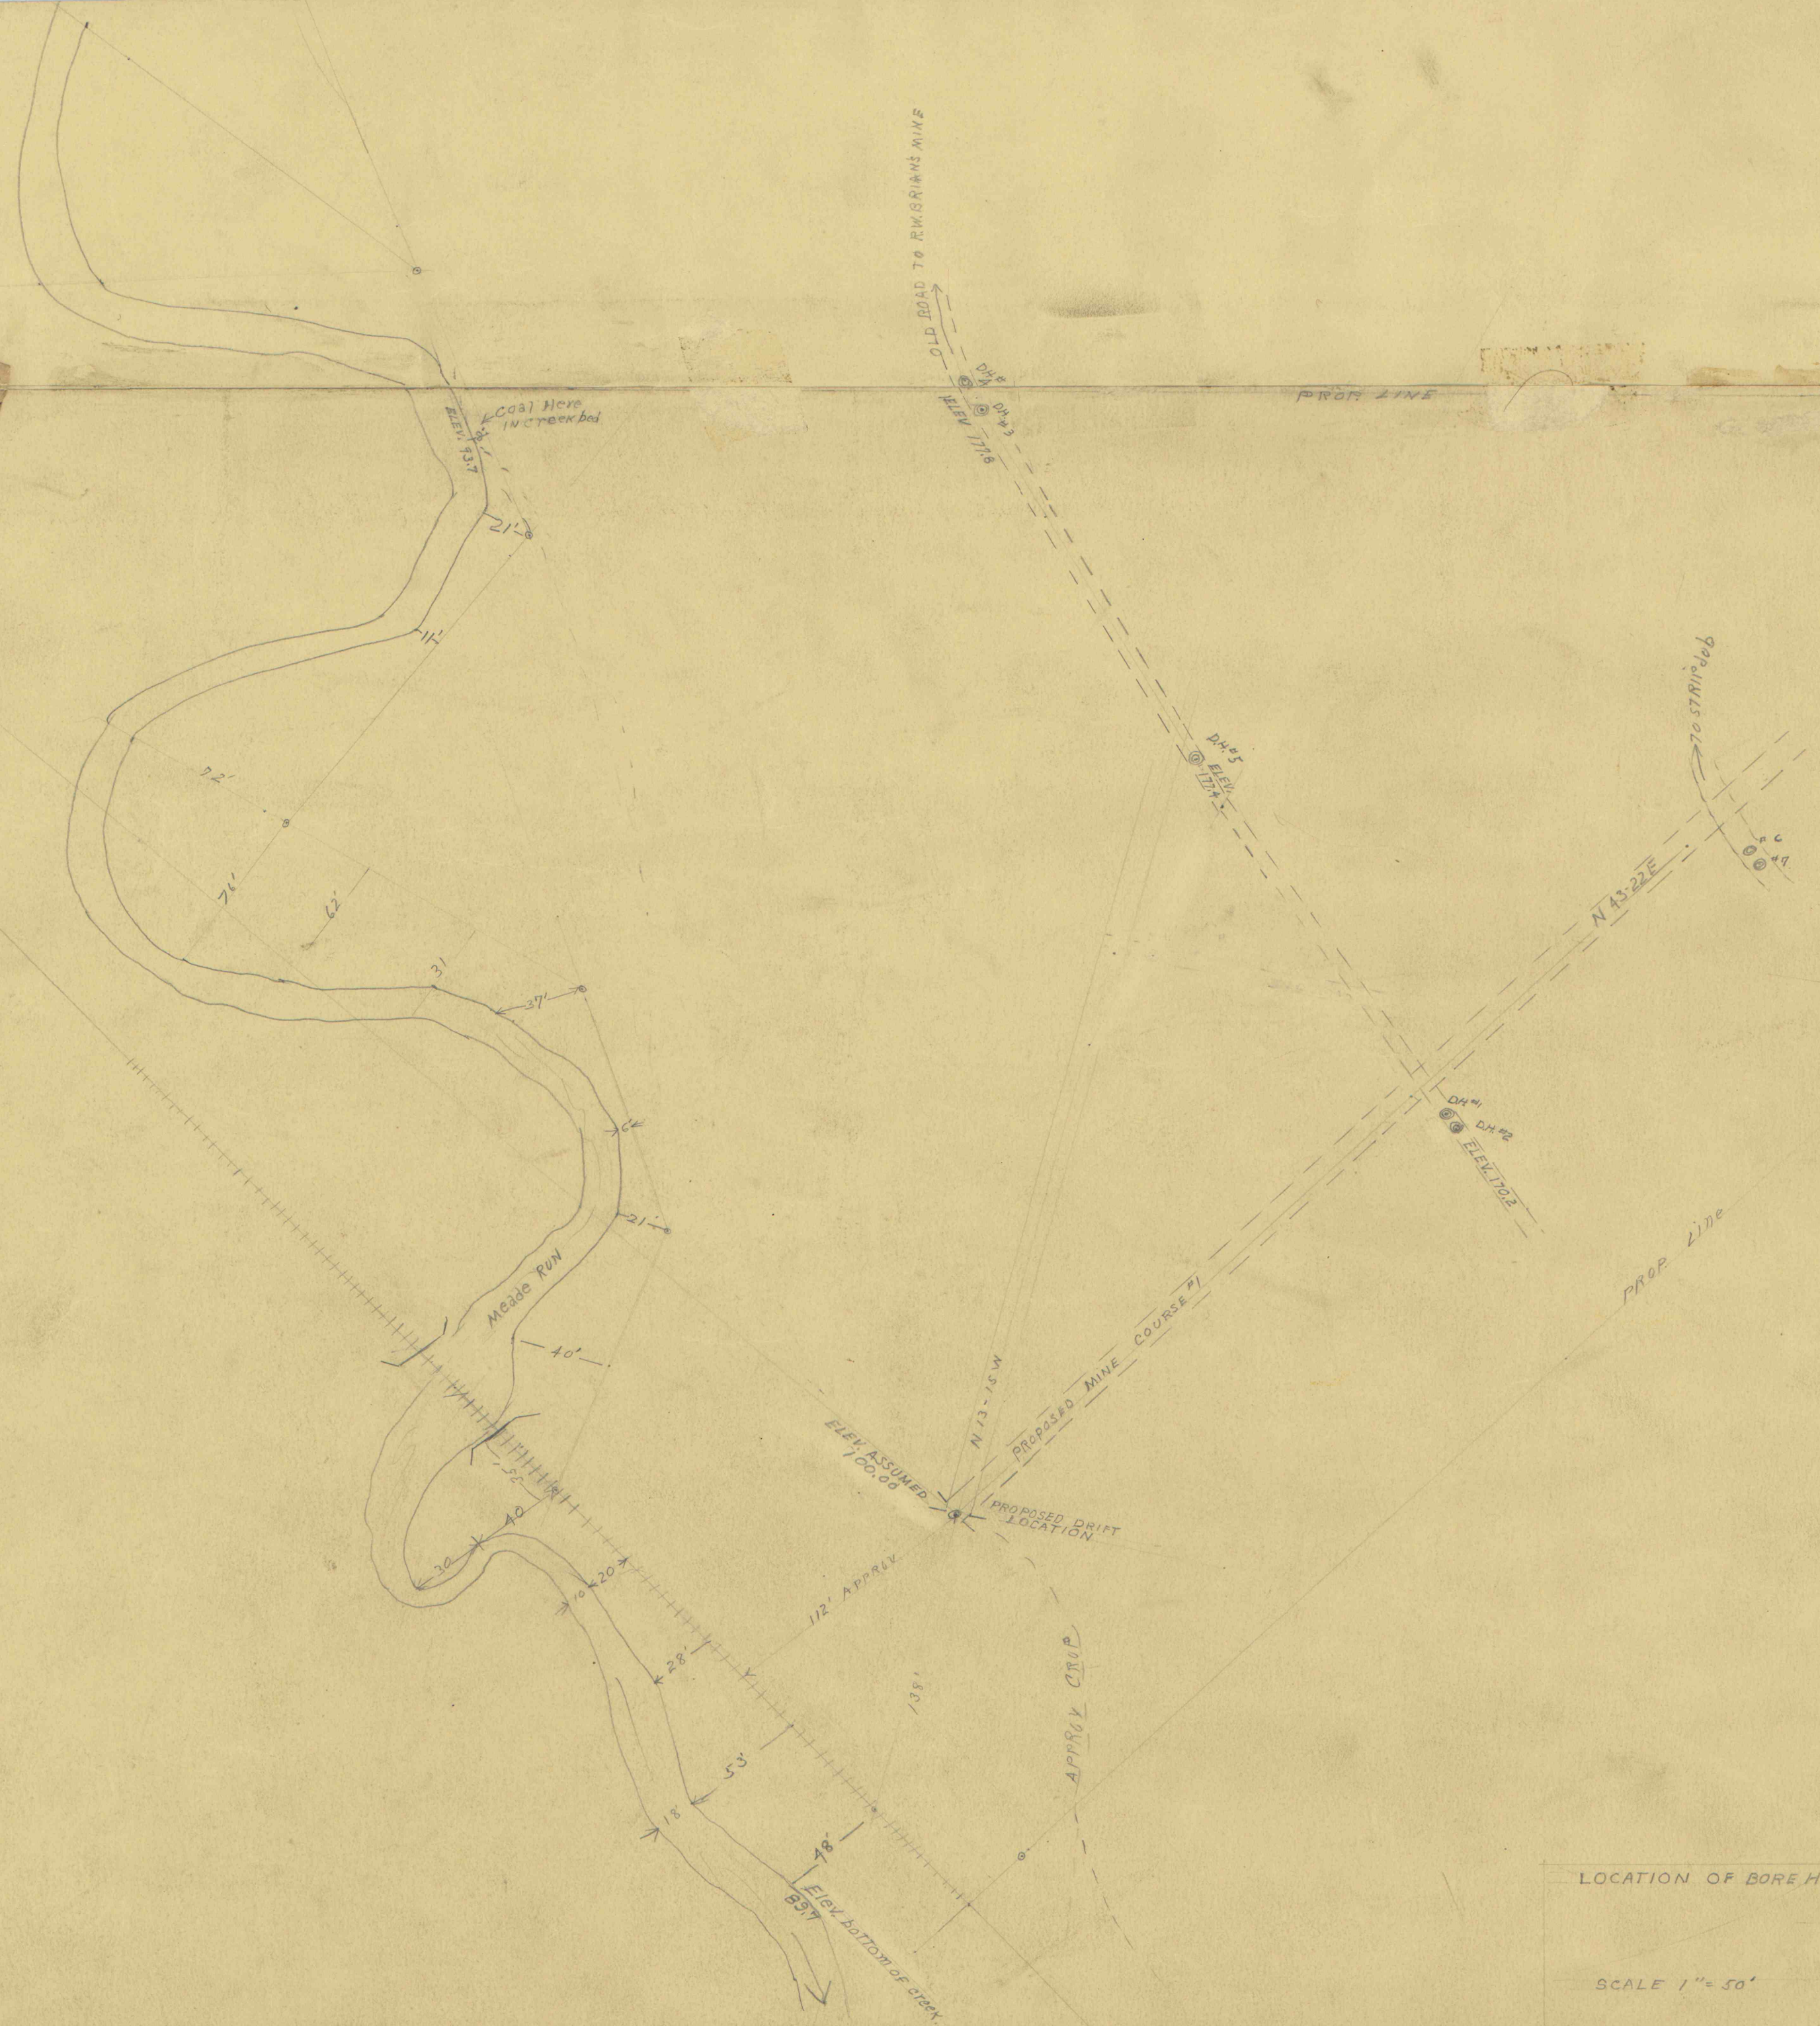

LOCATION OF BORE HOLES & PROPOSED DRIFT

SCALE 1" = 50'