
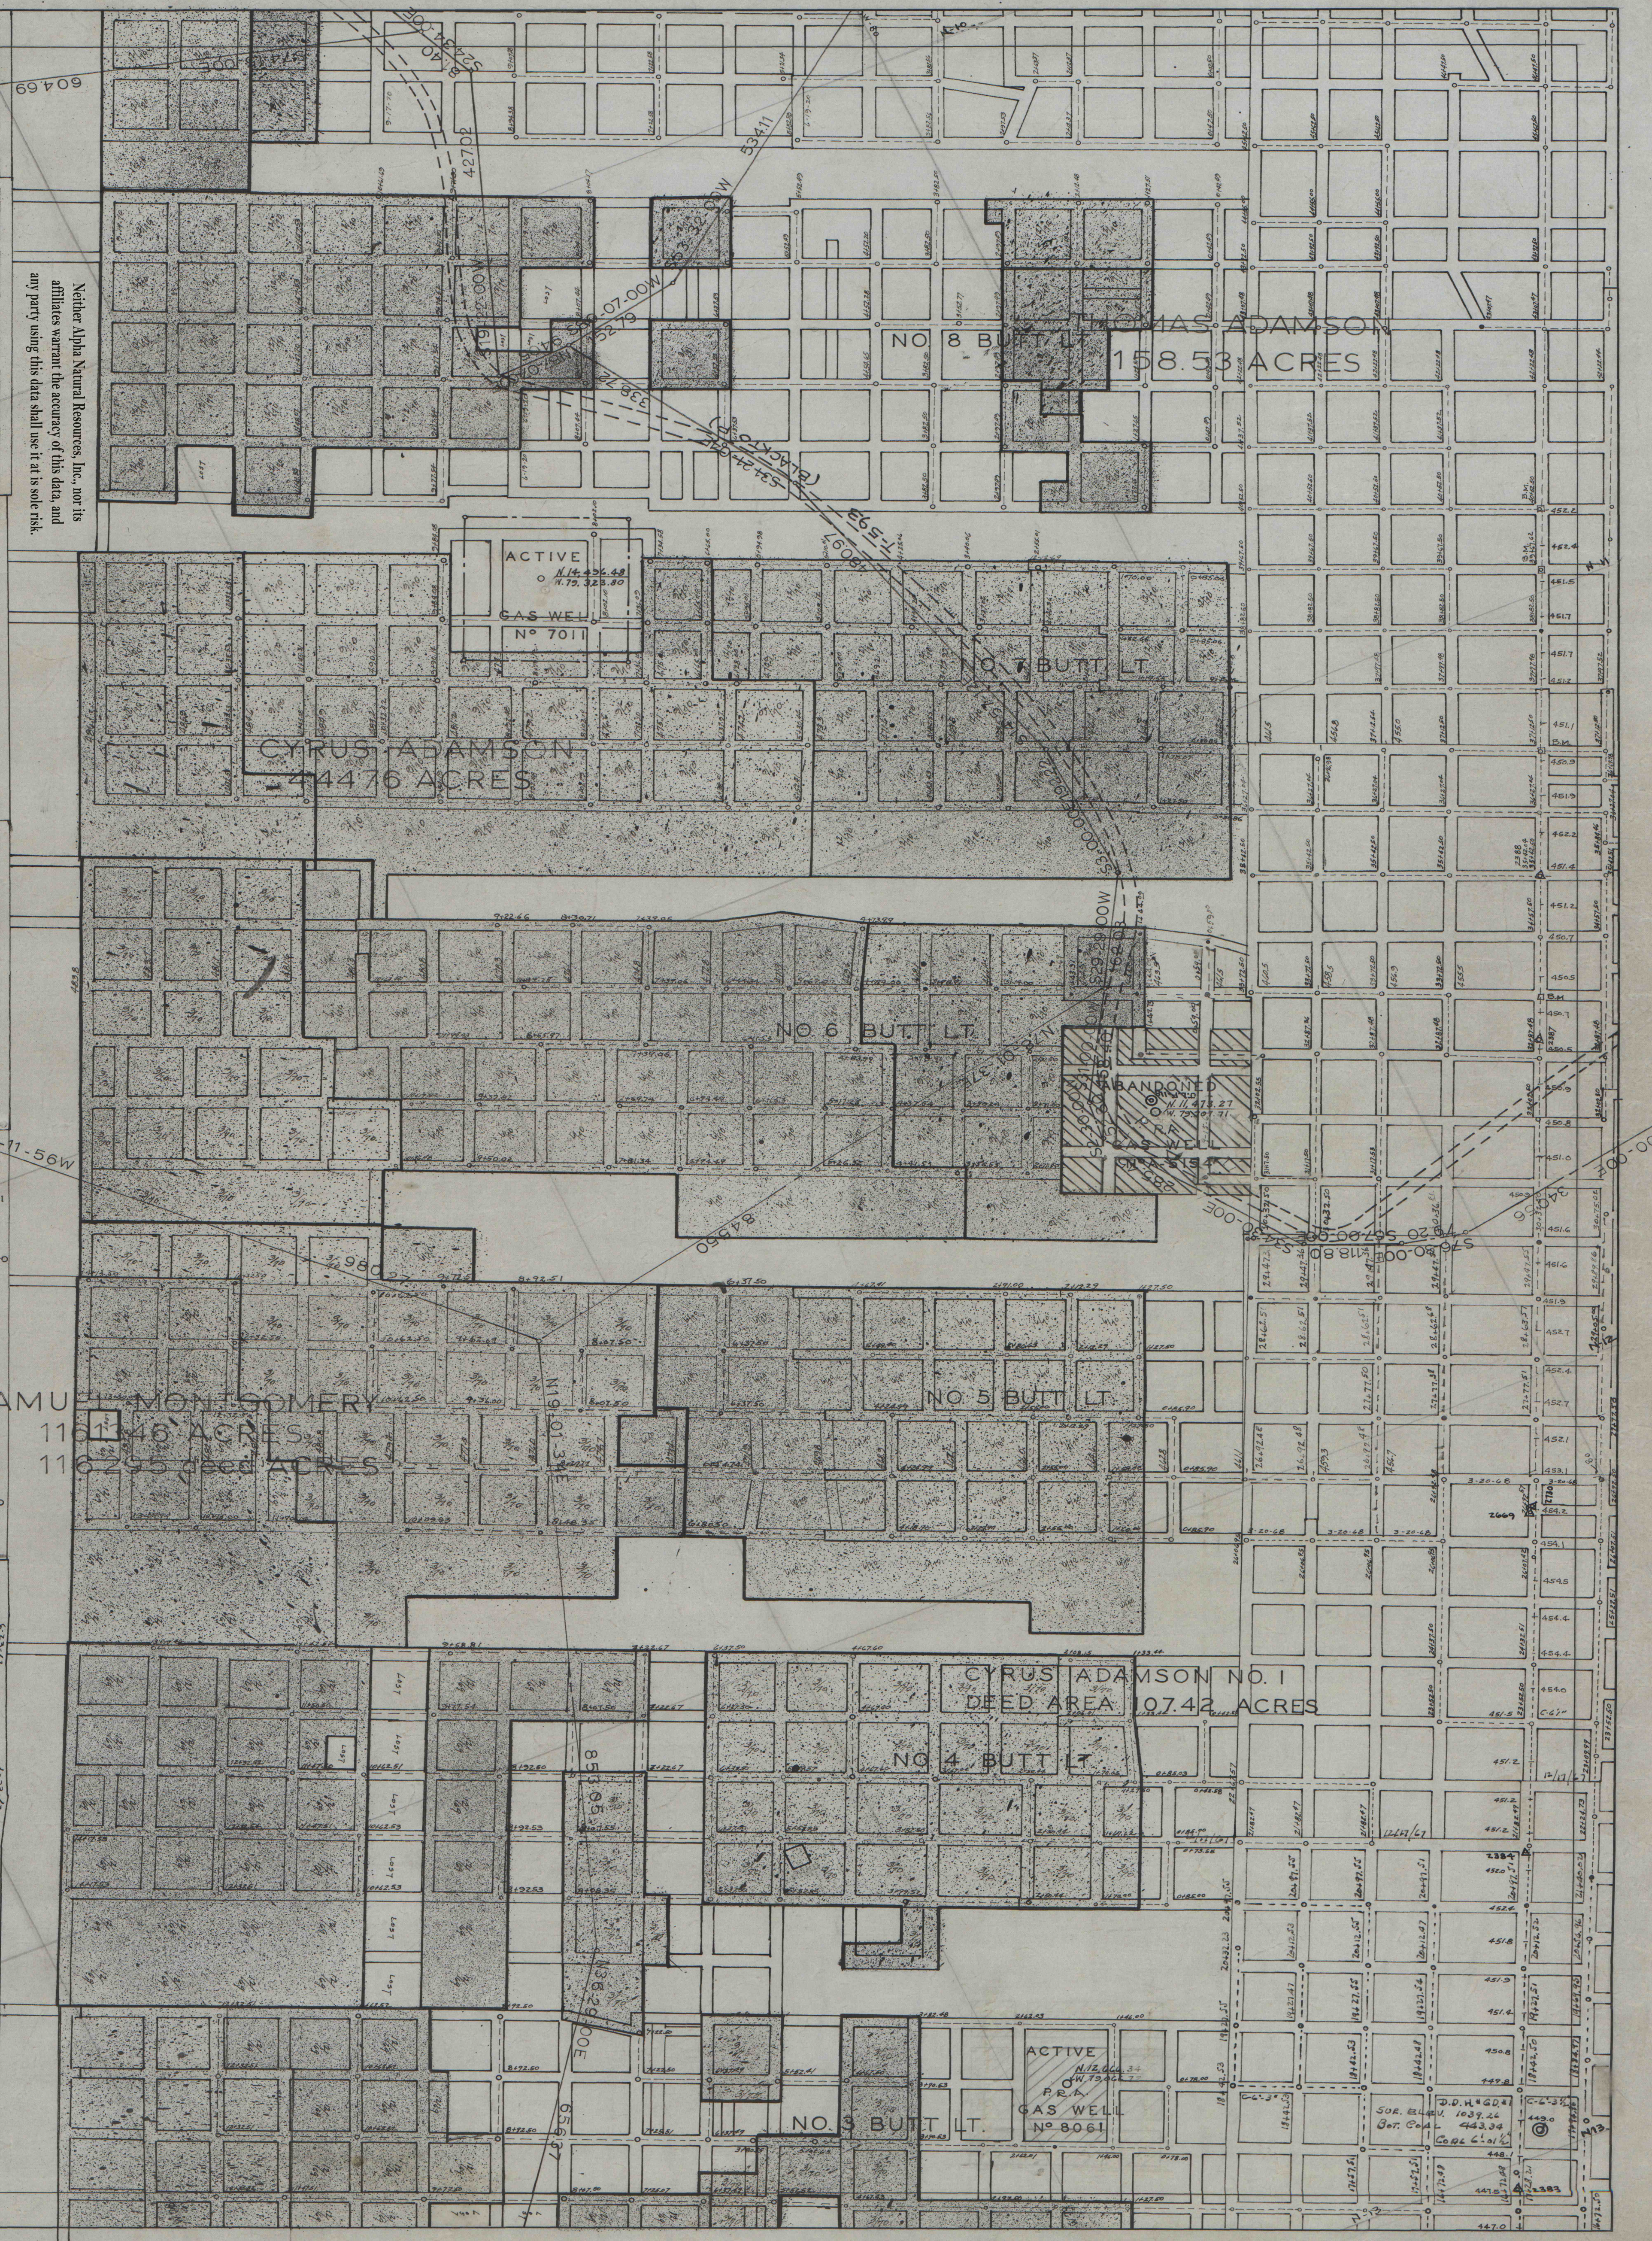


FITS TO SHEET No. 22

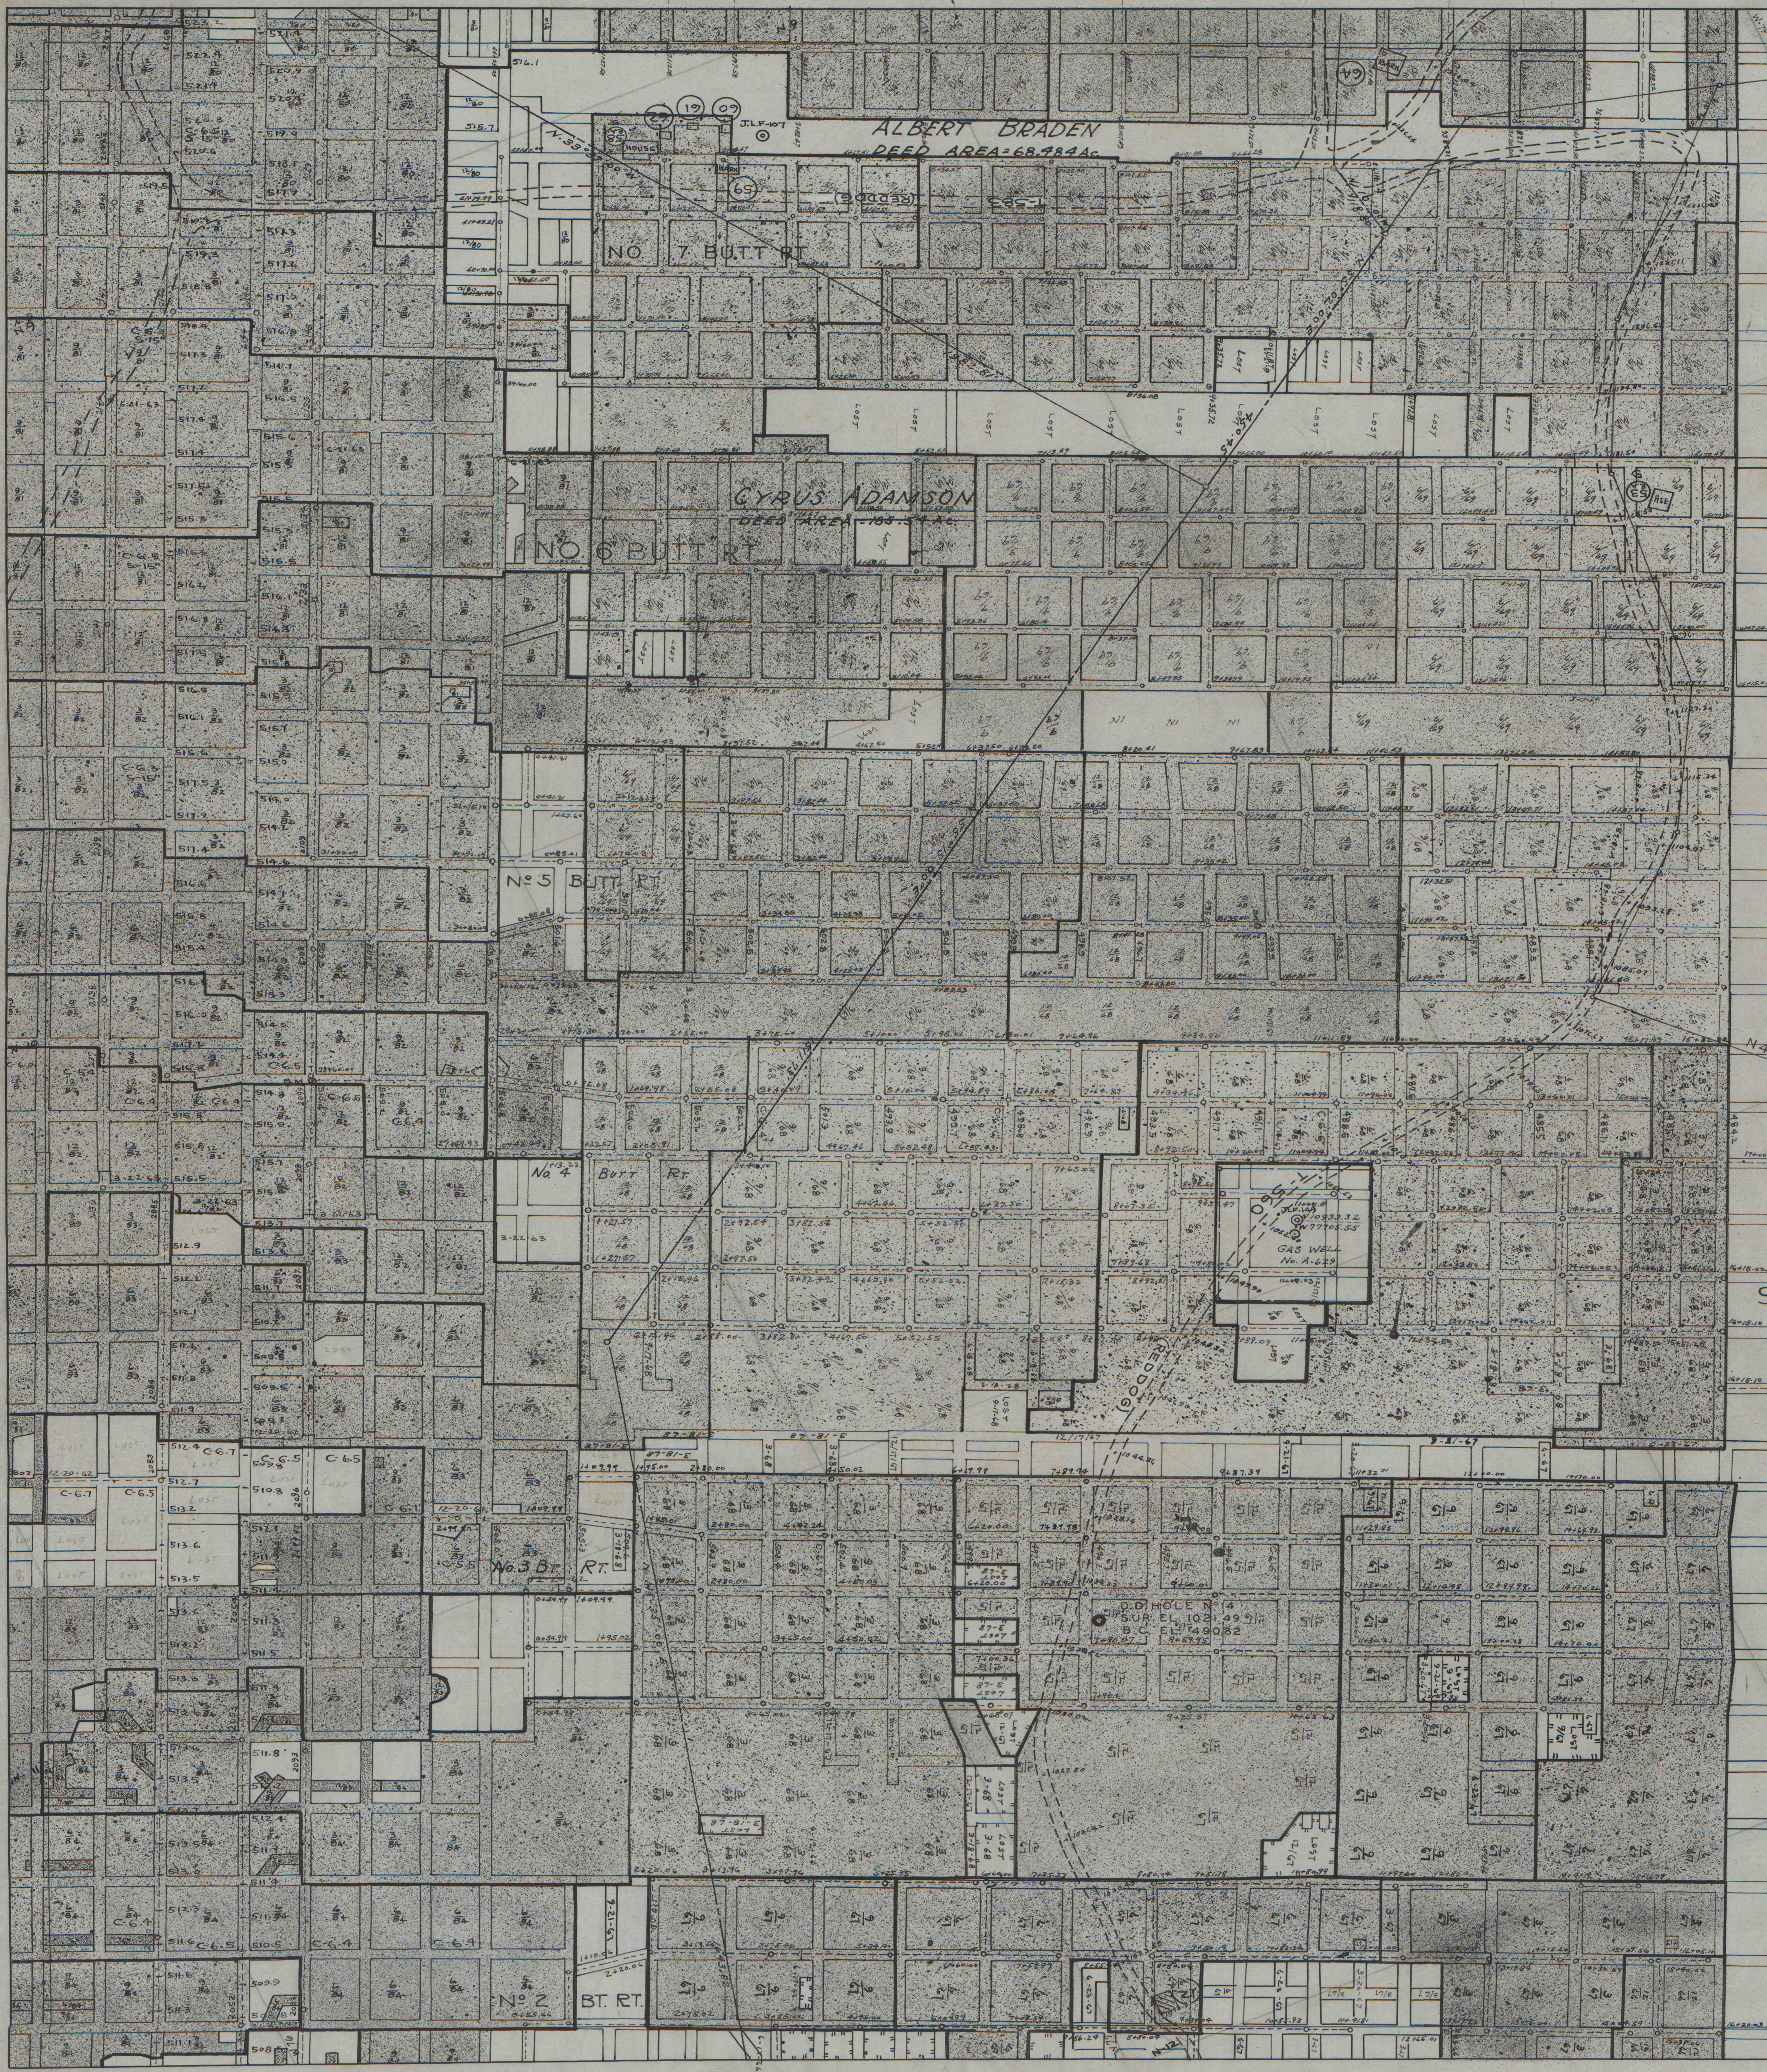

Neither Alpha Natural Resources, Inc. nor its affiliates warrant the accuracy of this data, and any party using this data shall use it at its sole risk.

FITS TO SHEET 40