


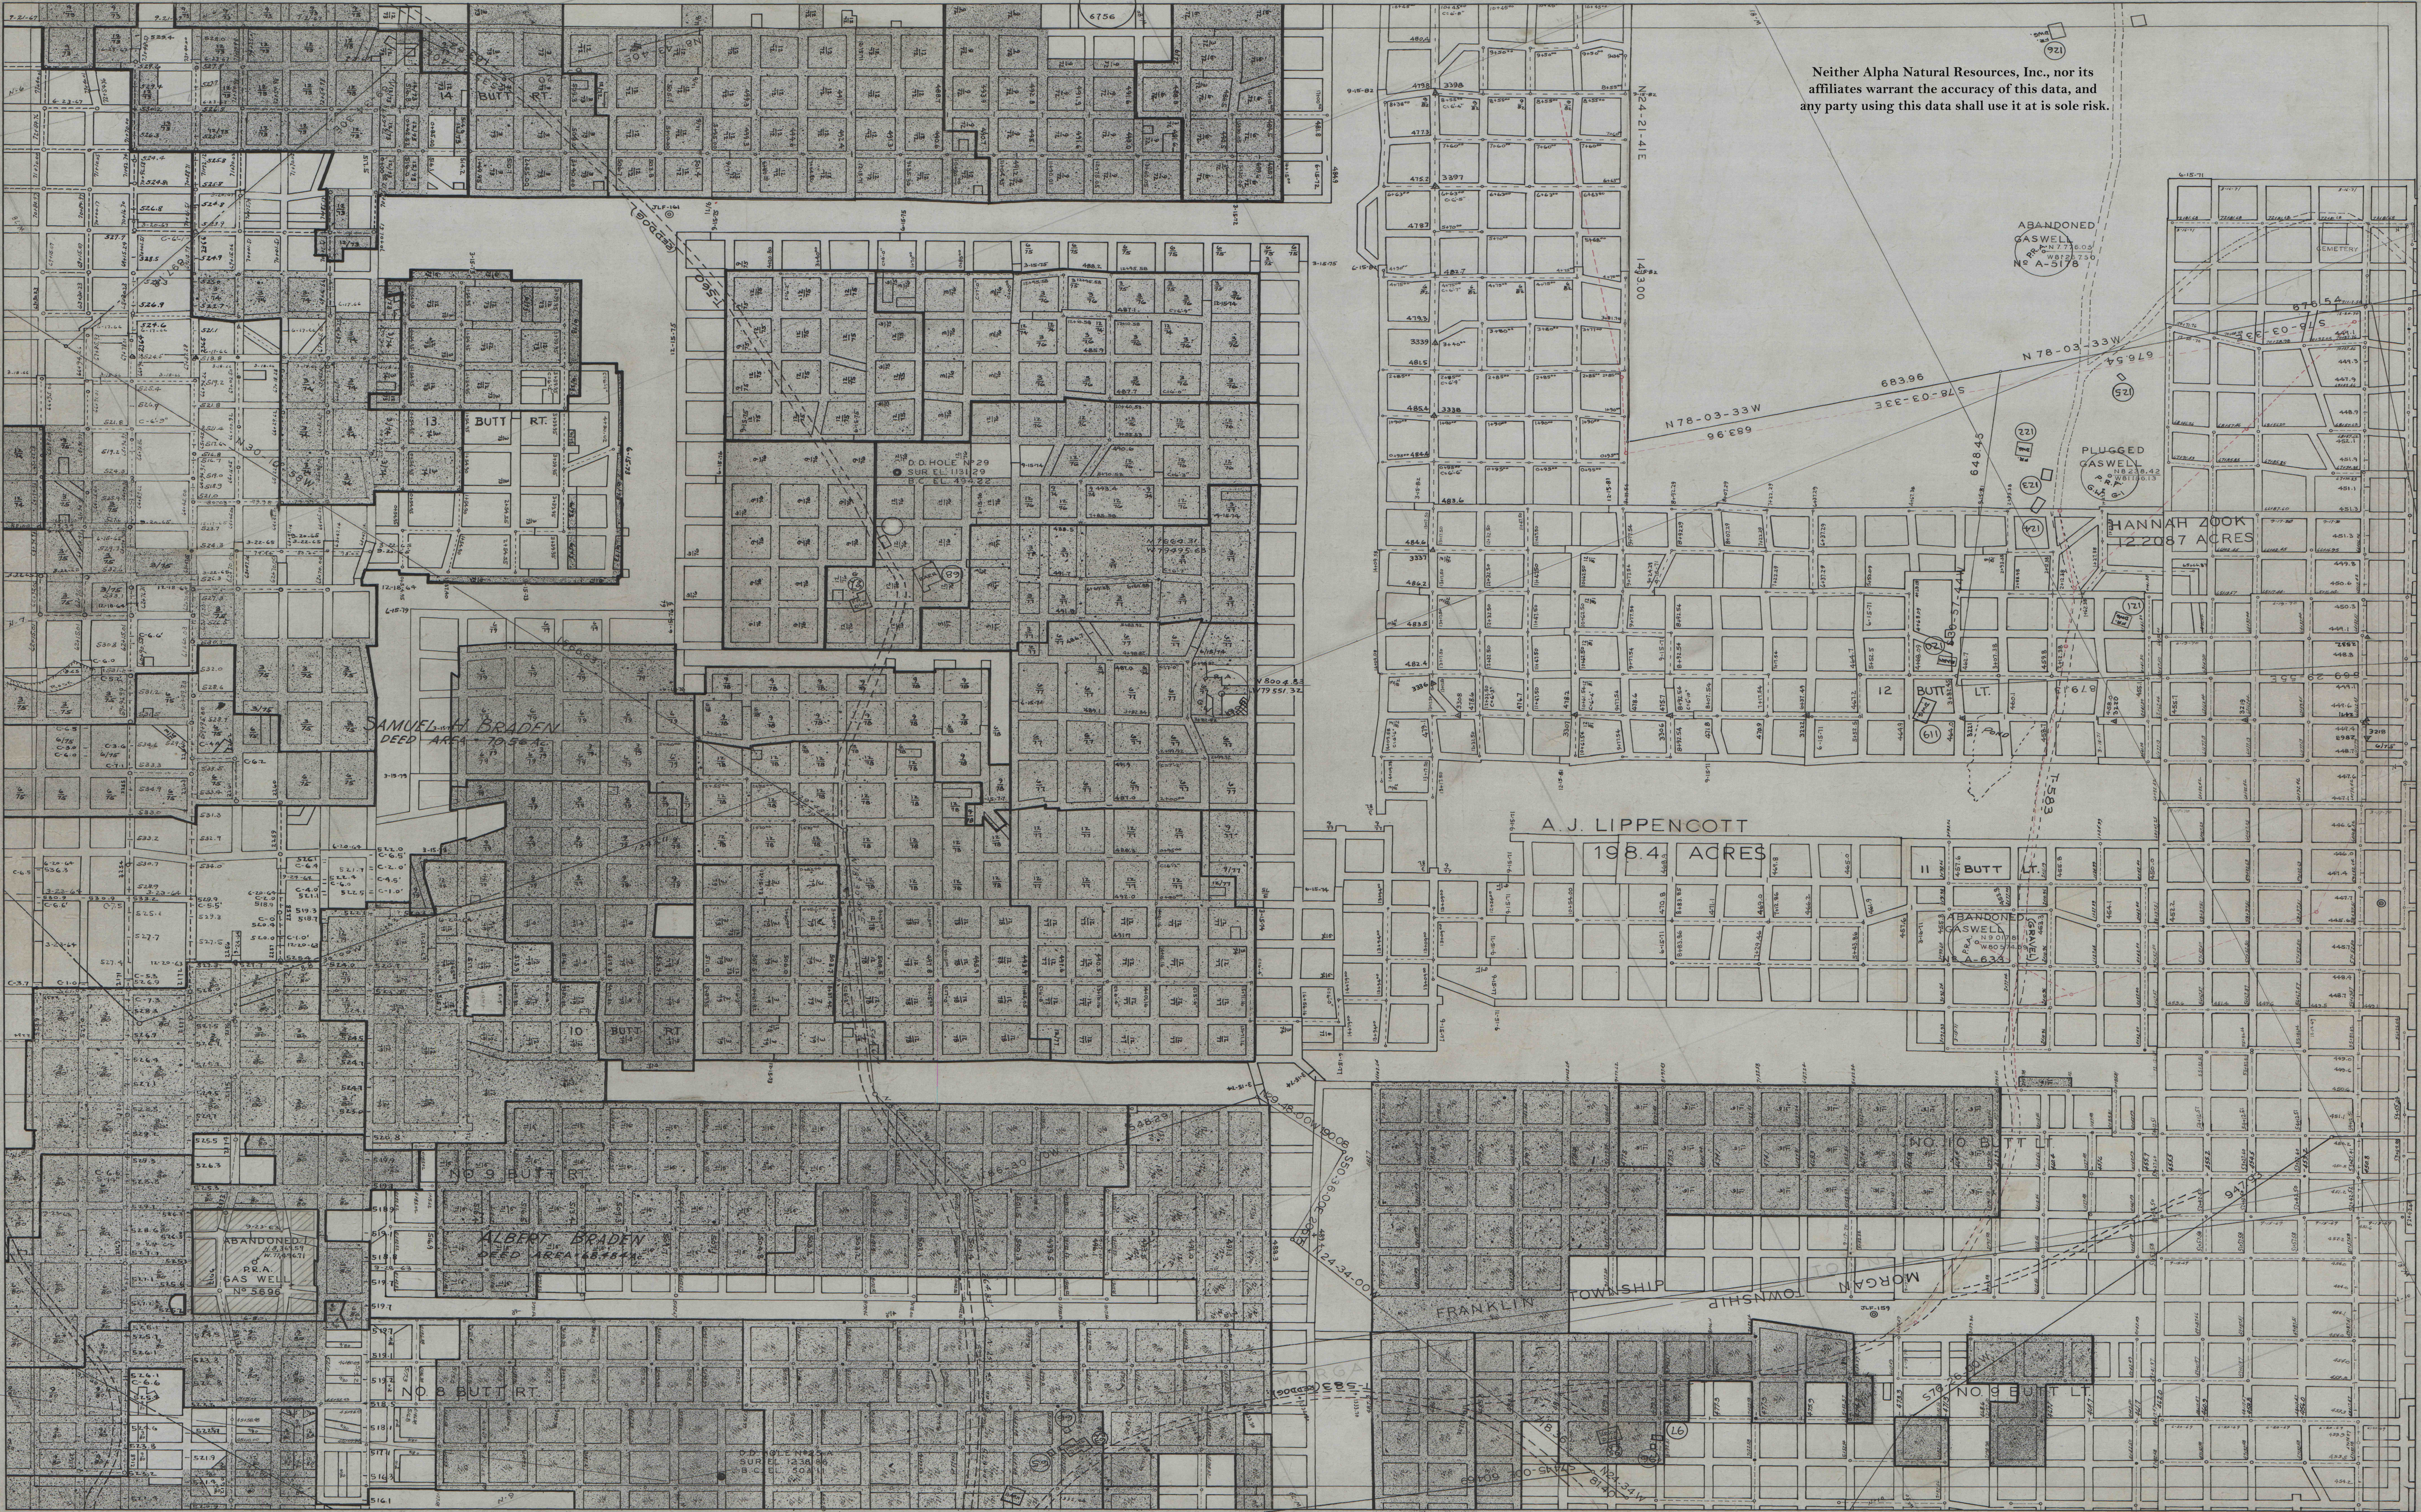

Neither Alpha Natural Resources, Inc., nor its affiliates warrant the accuracy of this data, and any party using this data shall use it at its sole risk.