


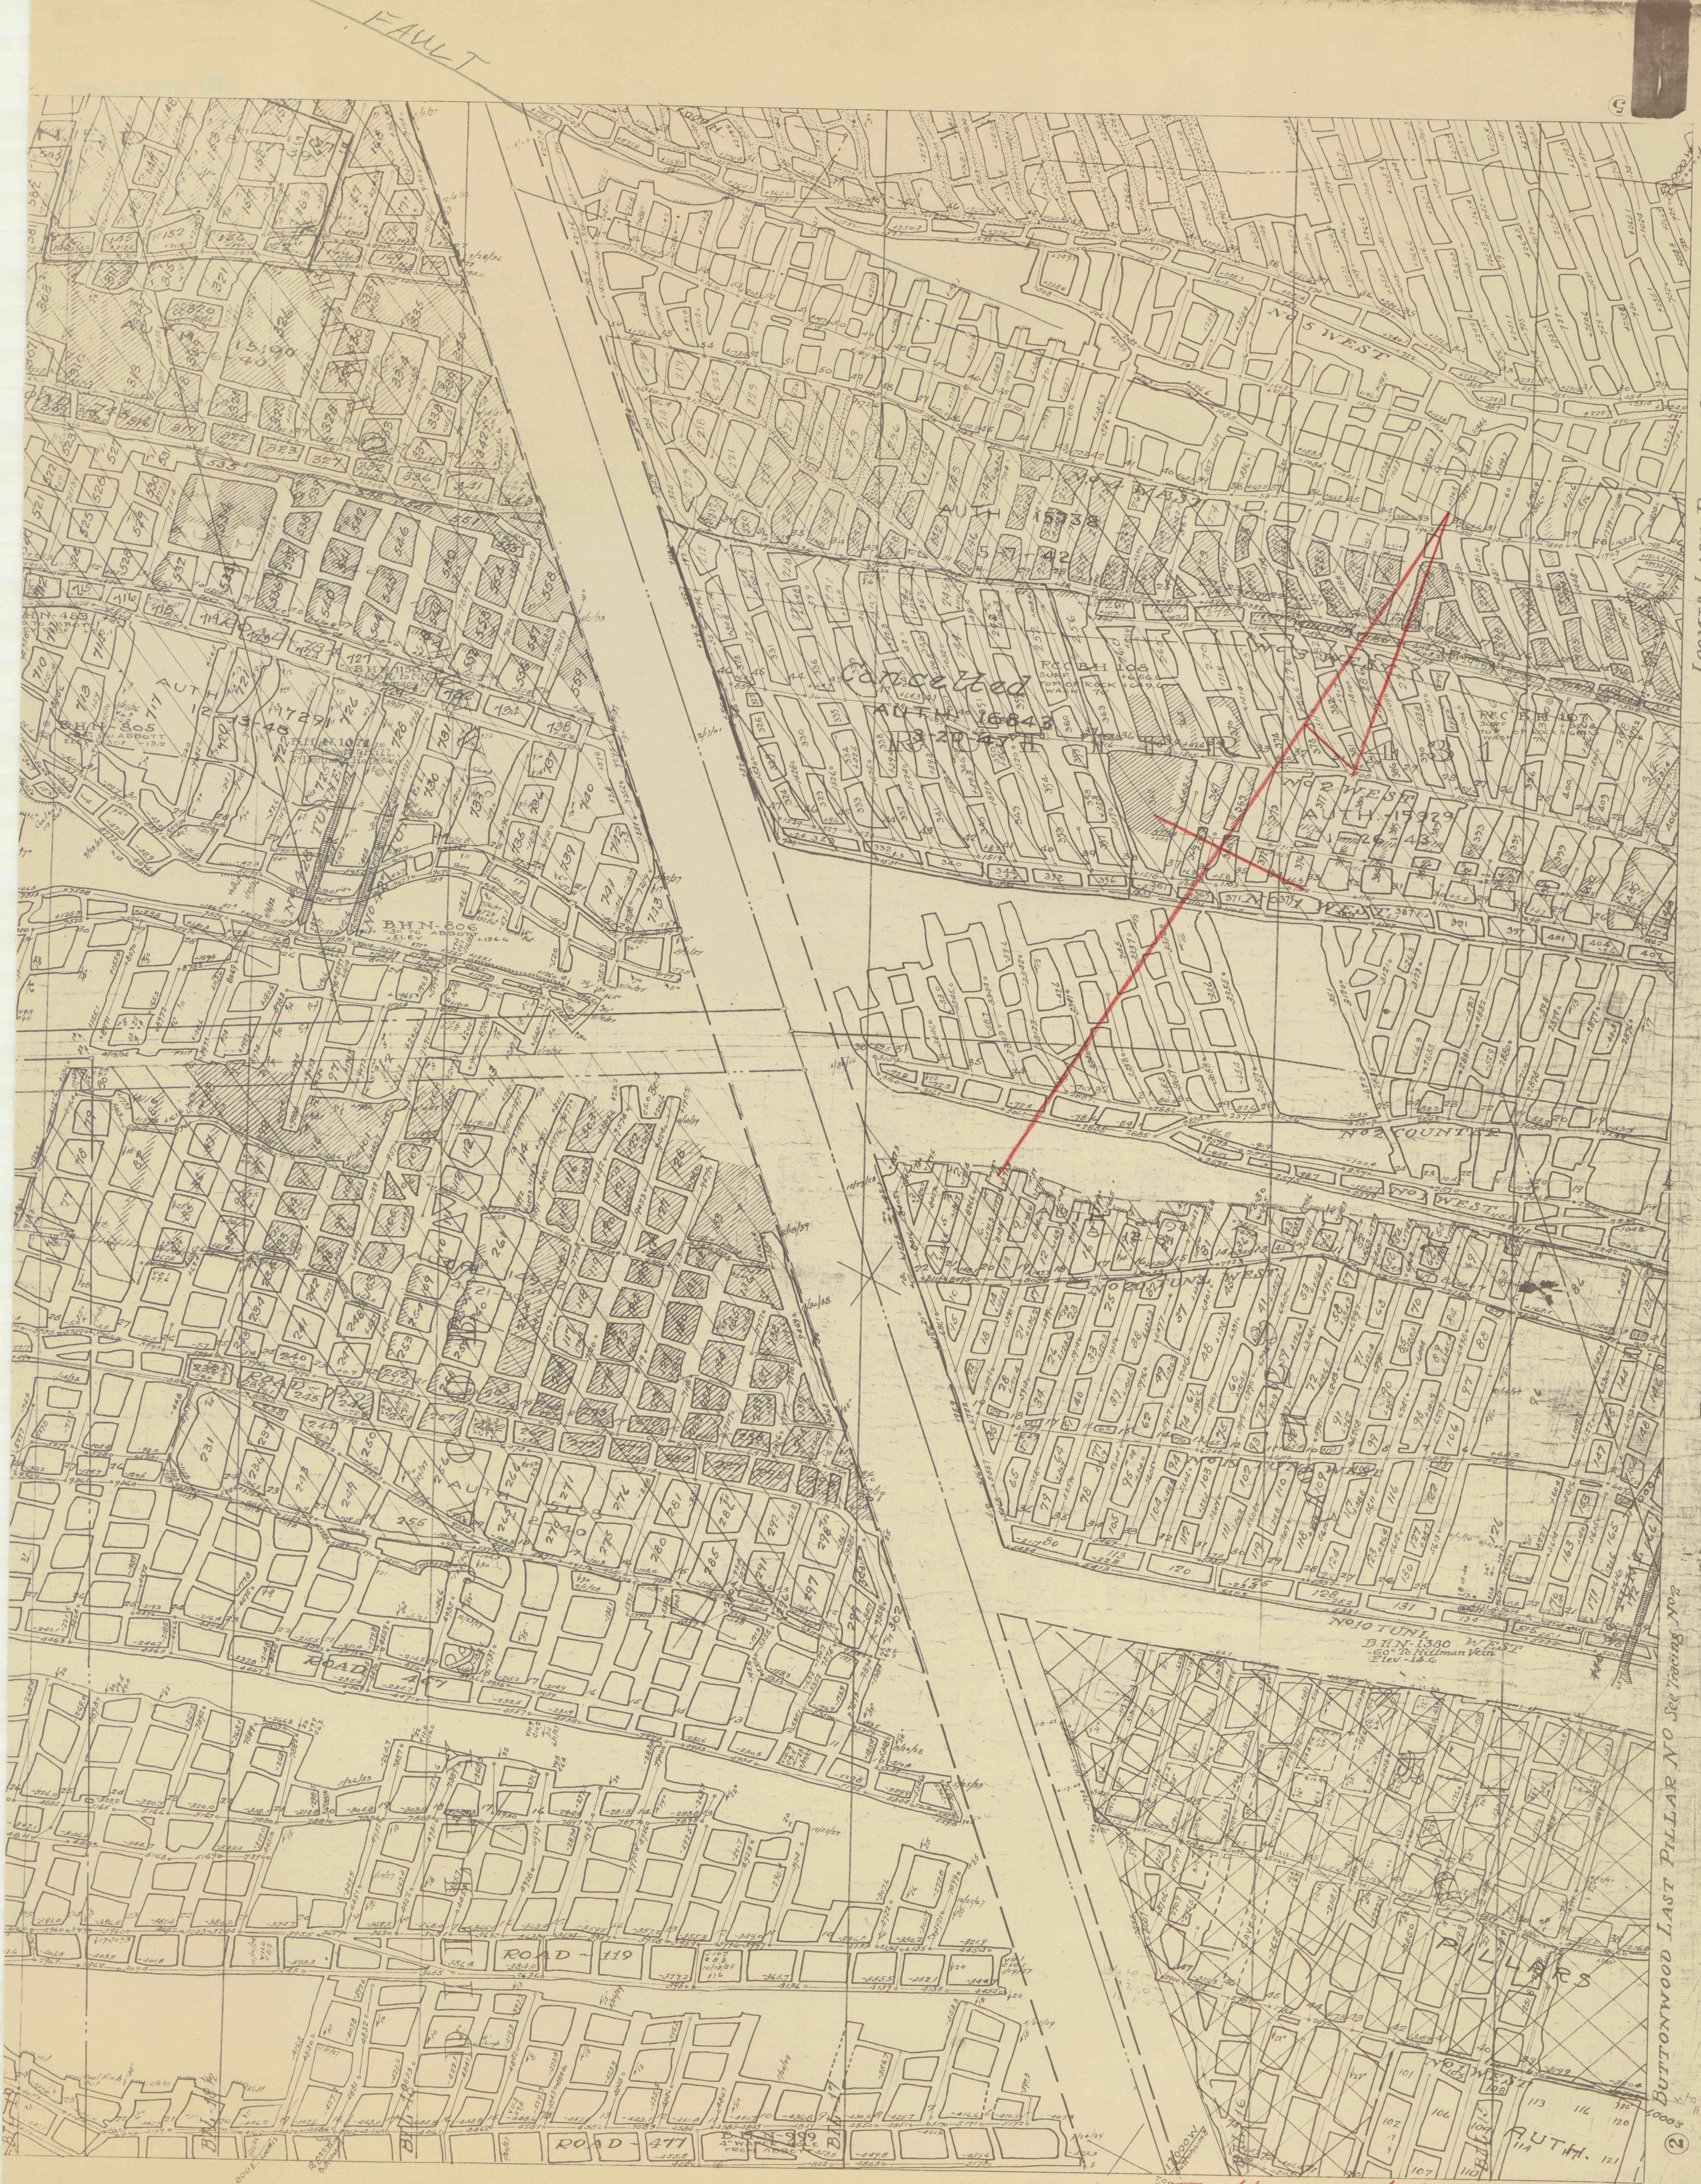

LOOMIS LAST PILLAR NO See other end

LOOMIS COLLIERY
MILLS VEIN #6

BUTTONWOOD LAST PILLAR NO See facing 102

Buttonwood & Inman
Kidney #6
Scale 1"=100'

②

③

⑦