


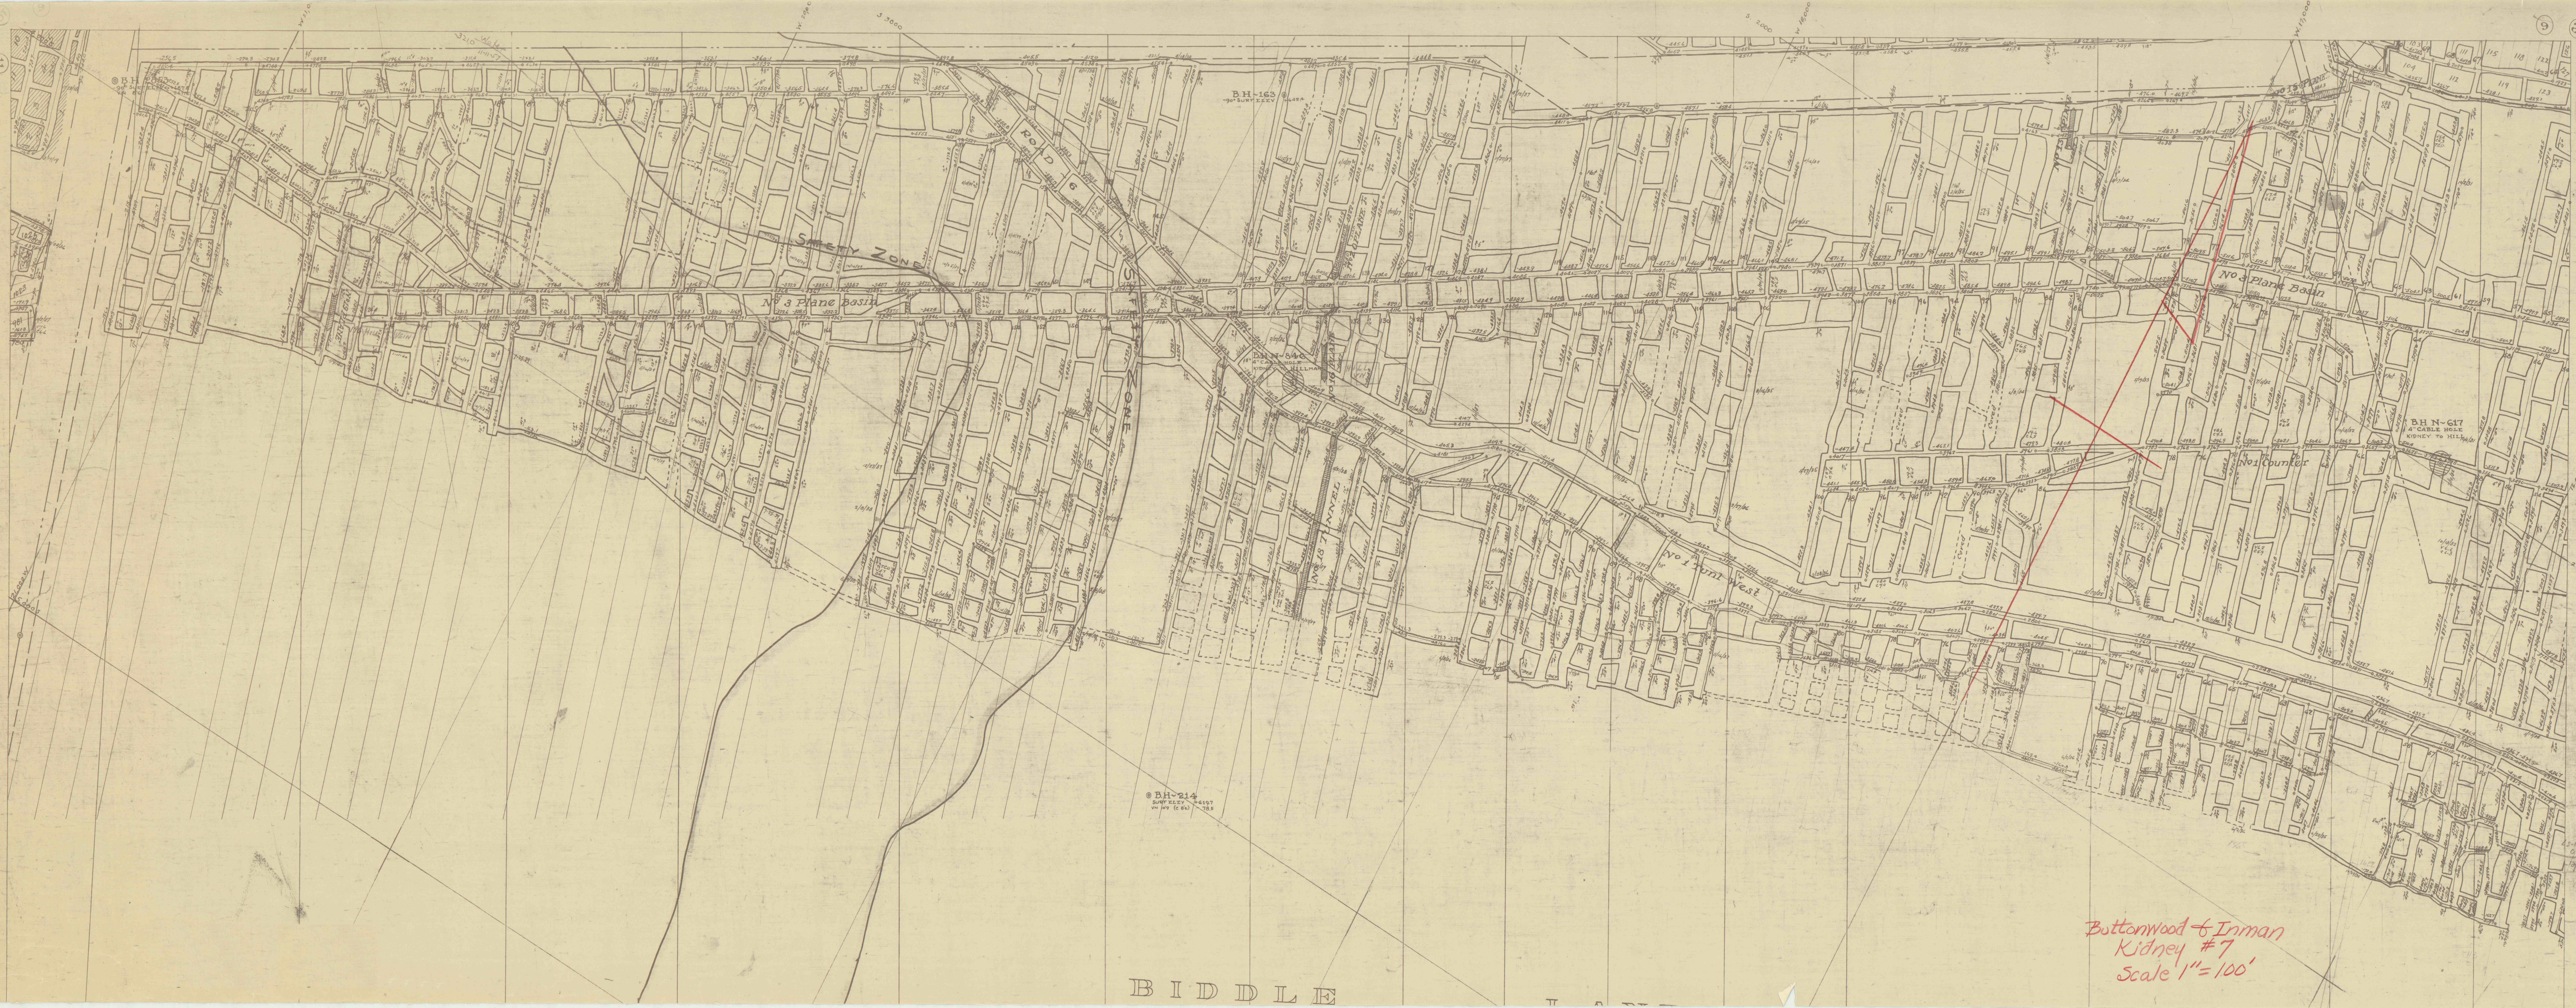

Bottomwood & Inman
Kidney #7
Scale 1"=100'