

2-12 BALTIMORE - 21 JANUARY - END

R. R. CO.

PRISCILLA JOHNSON

LEHIGH VALLEY COAL CO.

COAL CO.

VALLEY

2-12-S

SECTION

LEHIGH

BALTIMORE CO. CO.

STATION



CO.

DELAWARE

AND

HUDSON

CO.

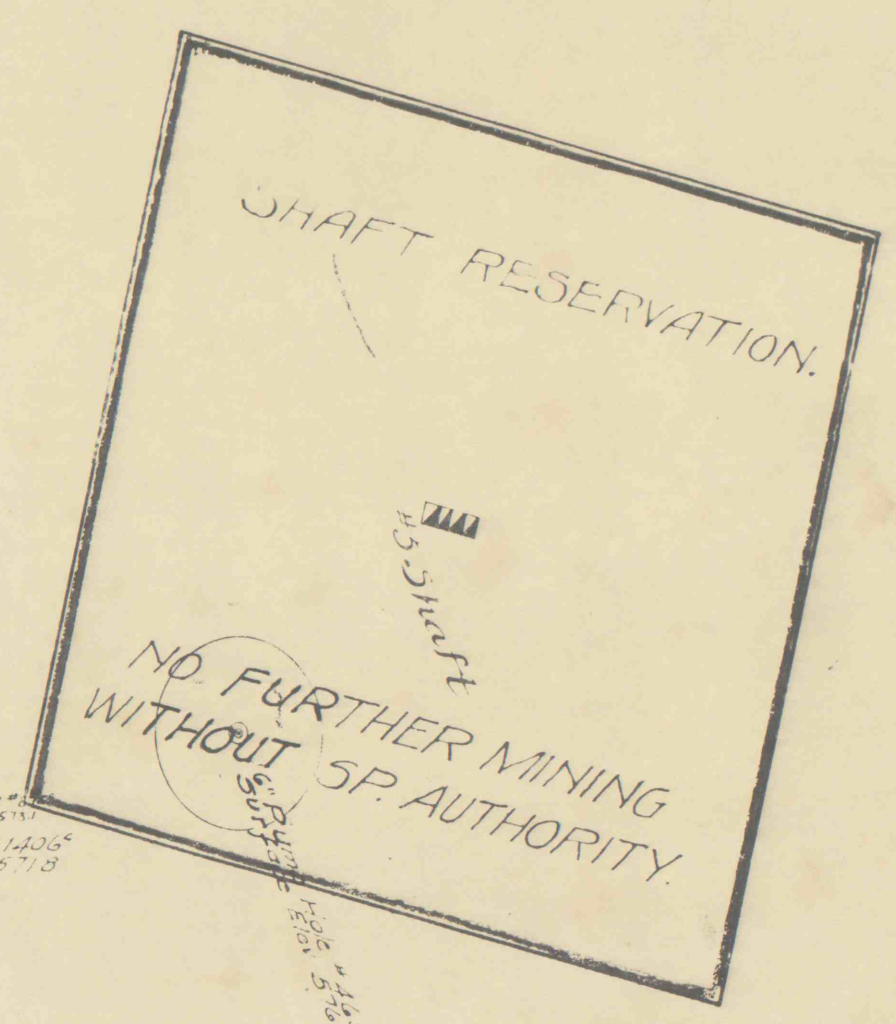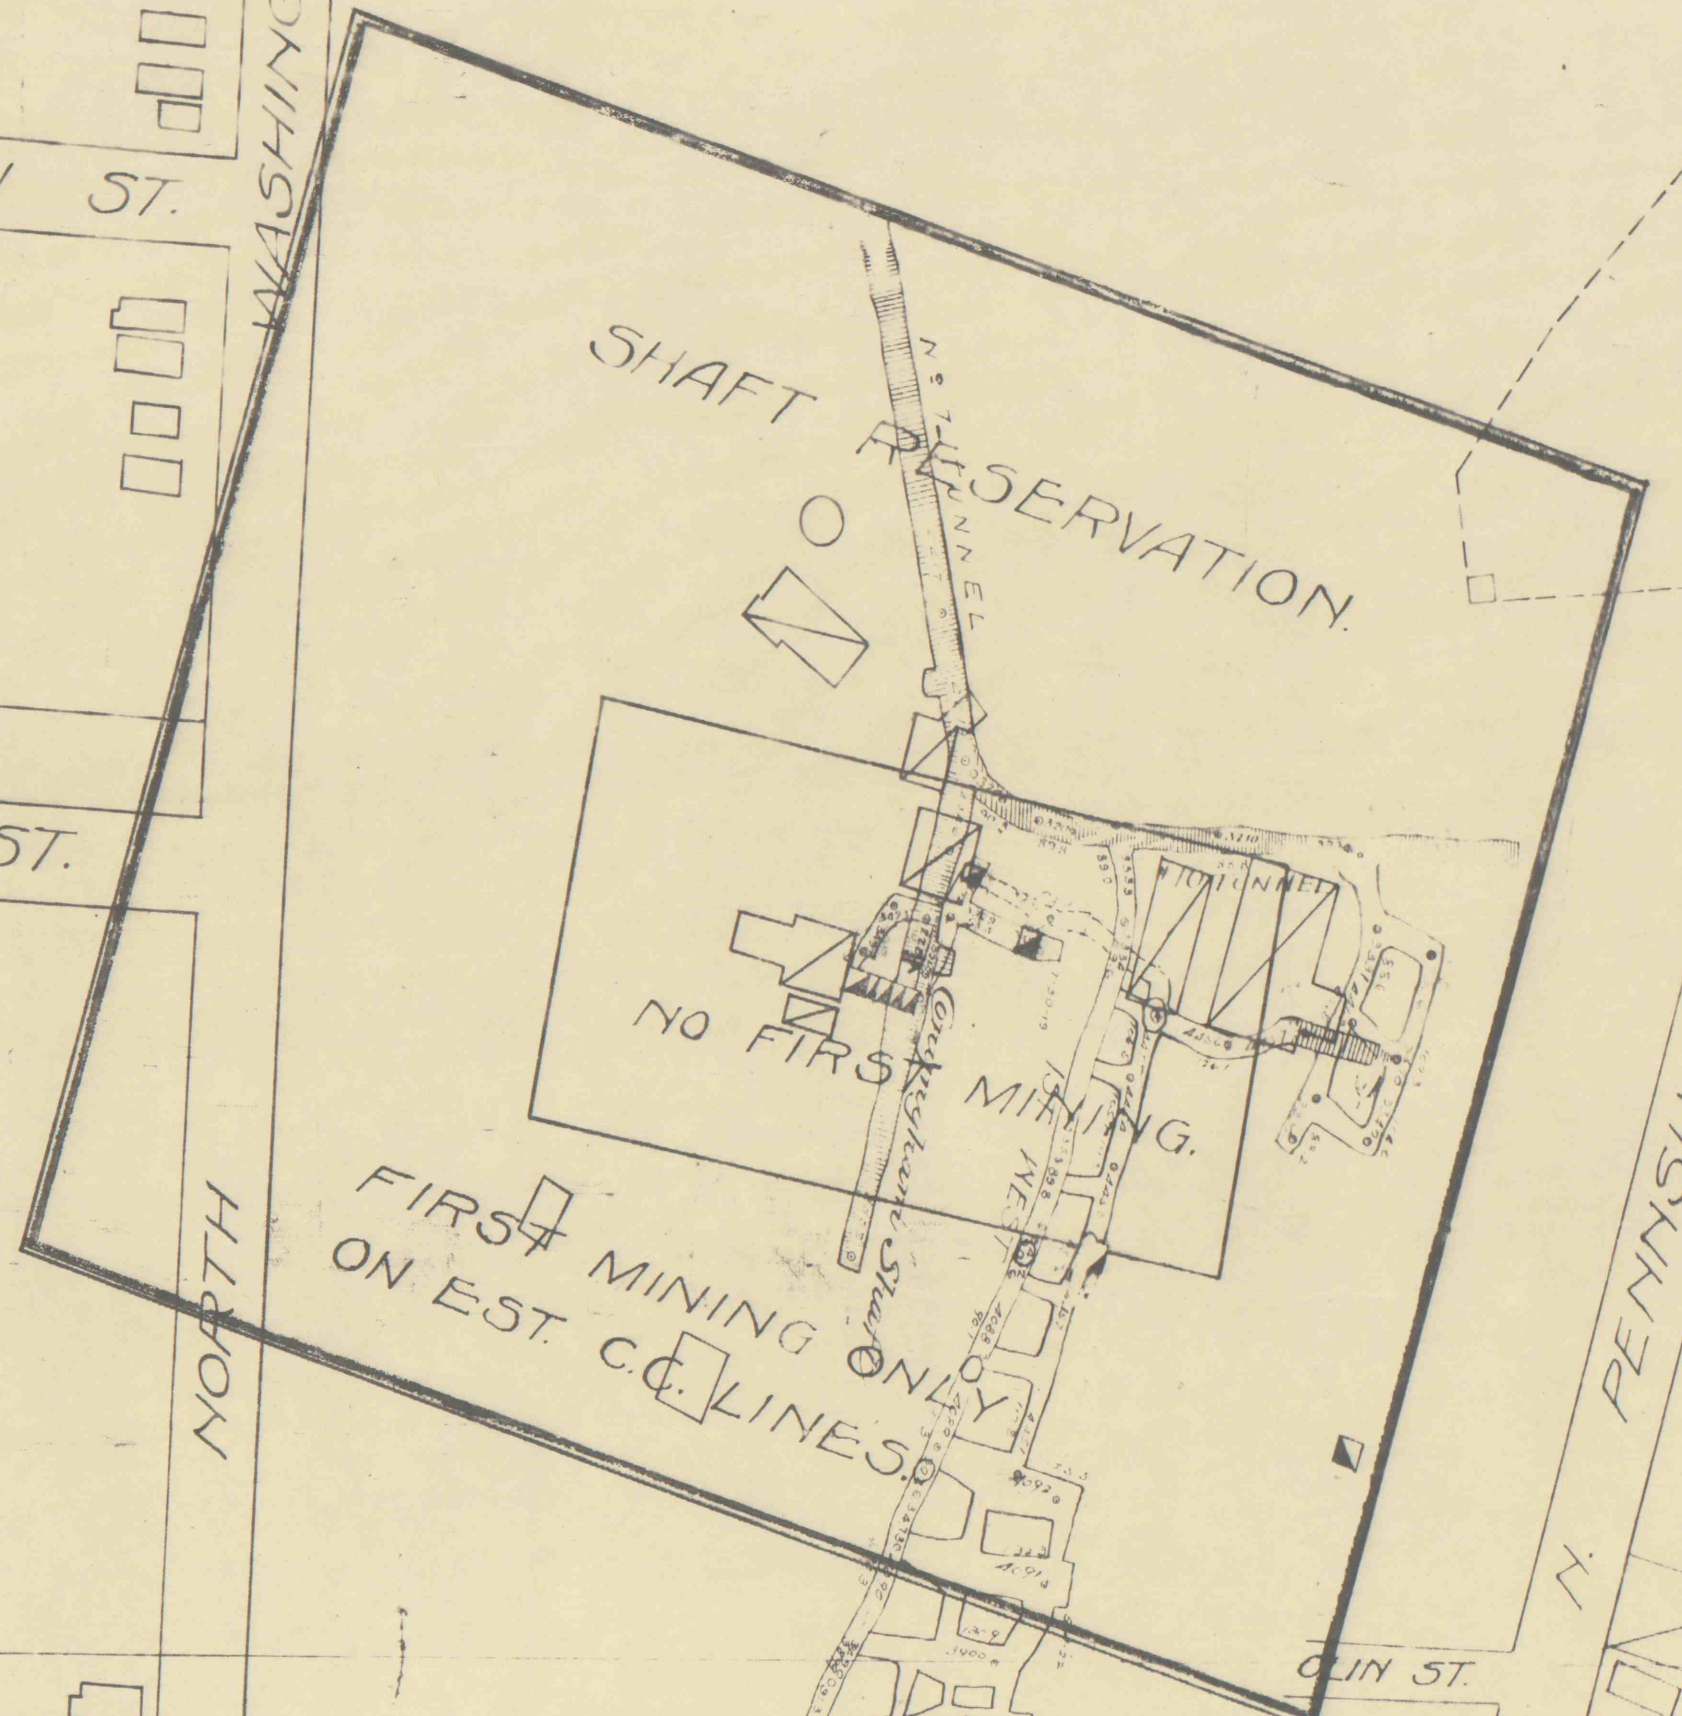

LEHIGH VALLEY COAL CO. LESSEE.

THE HUDSON COAL CO.