
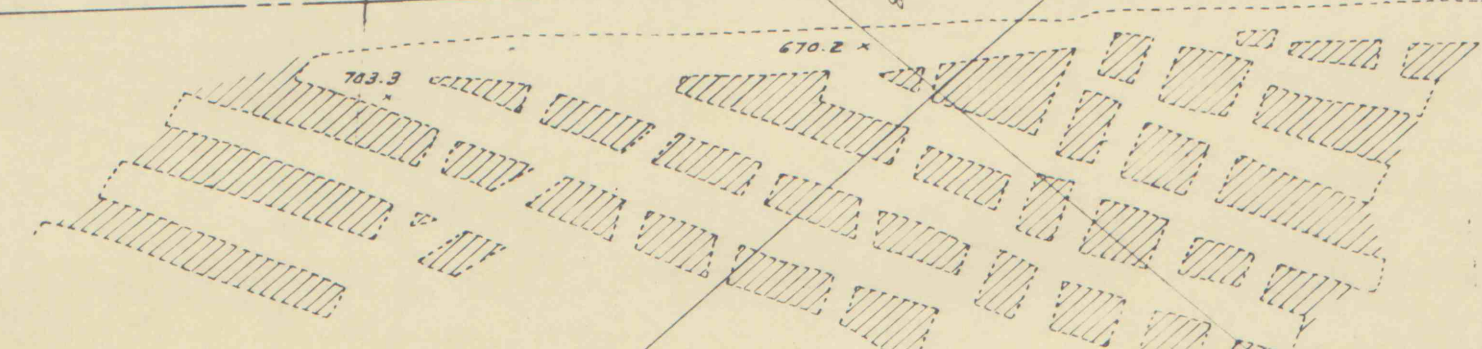
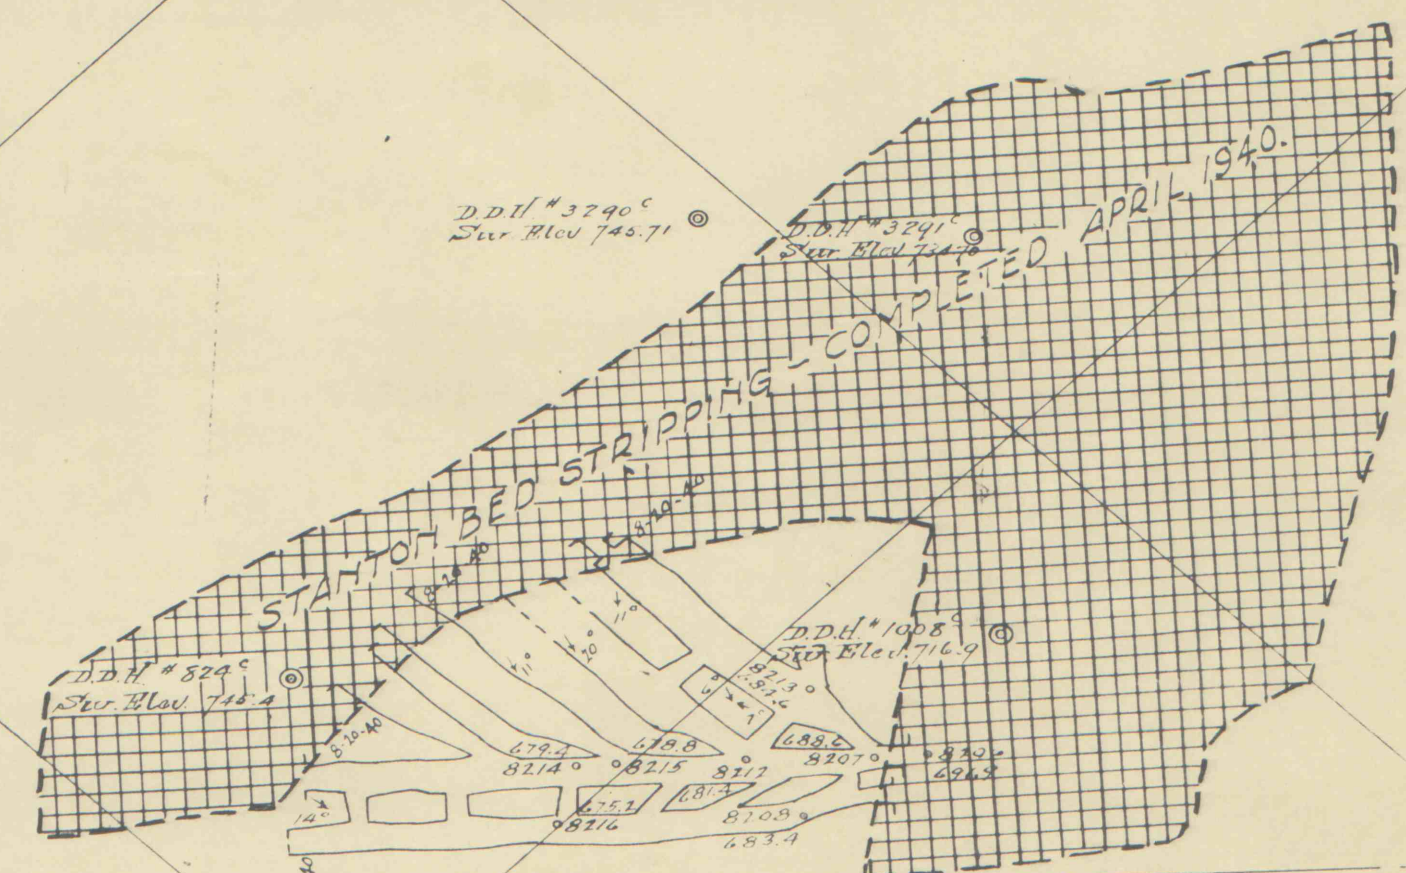


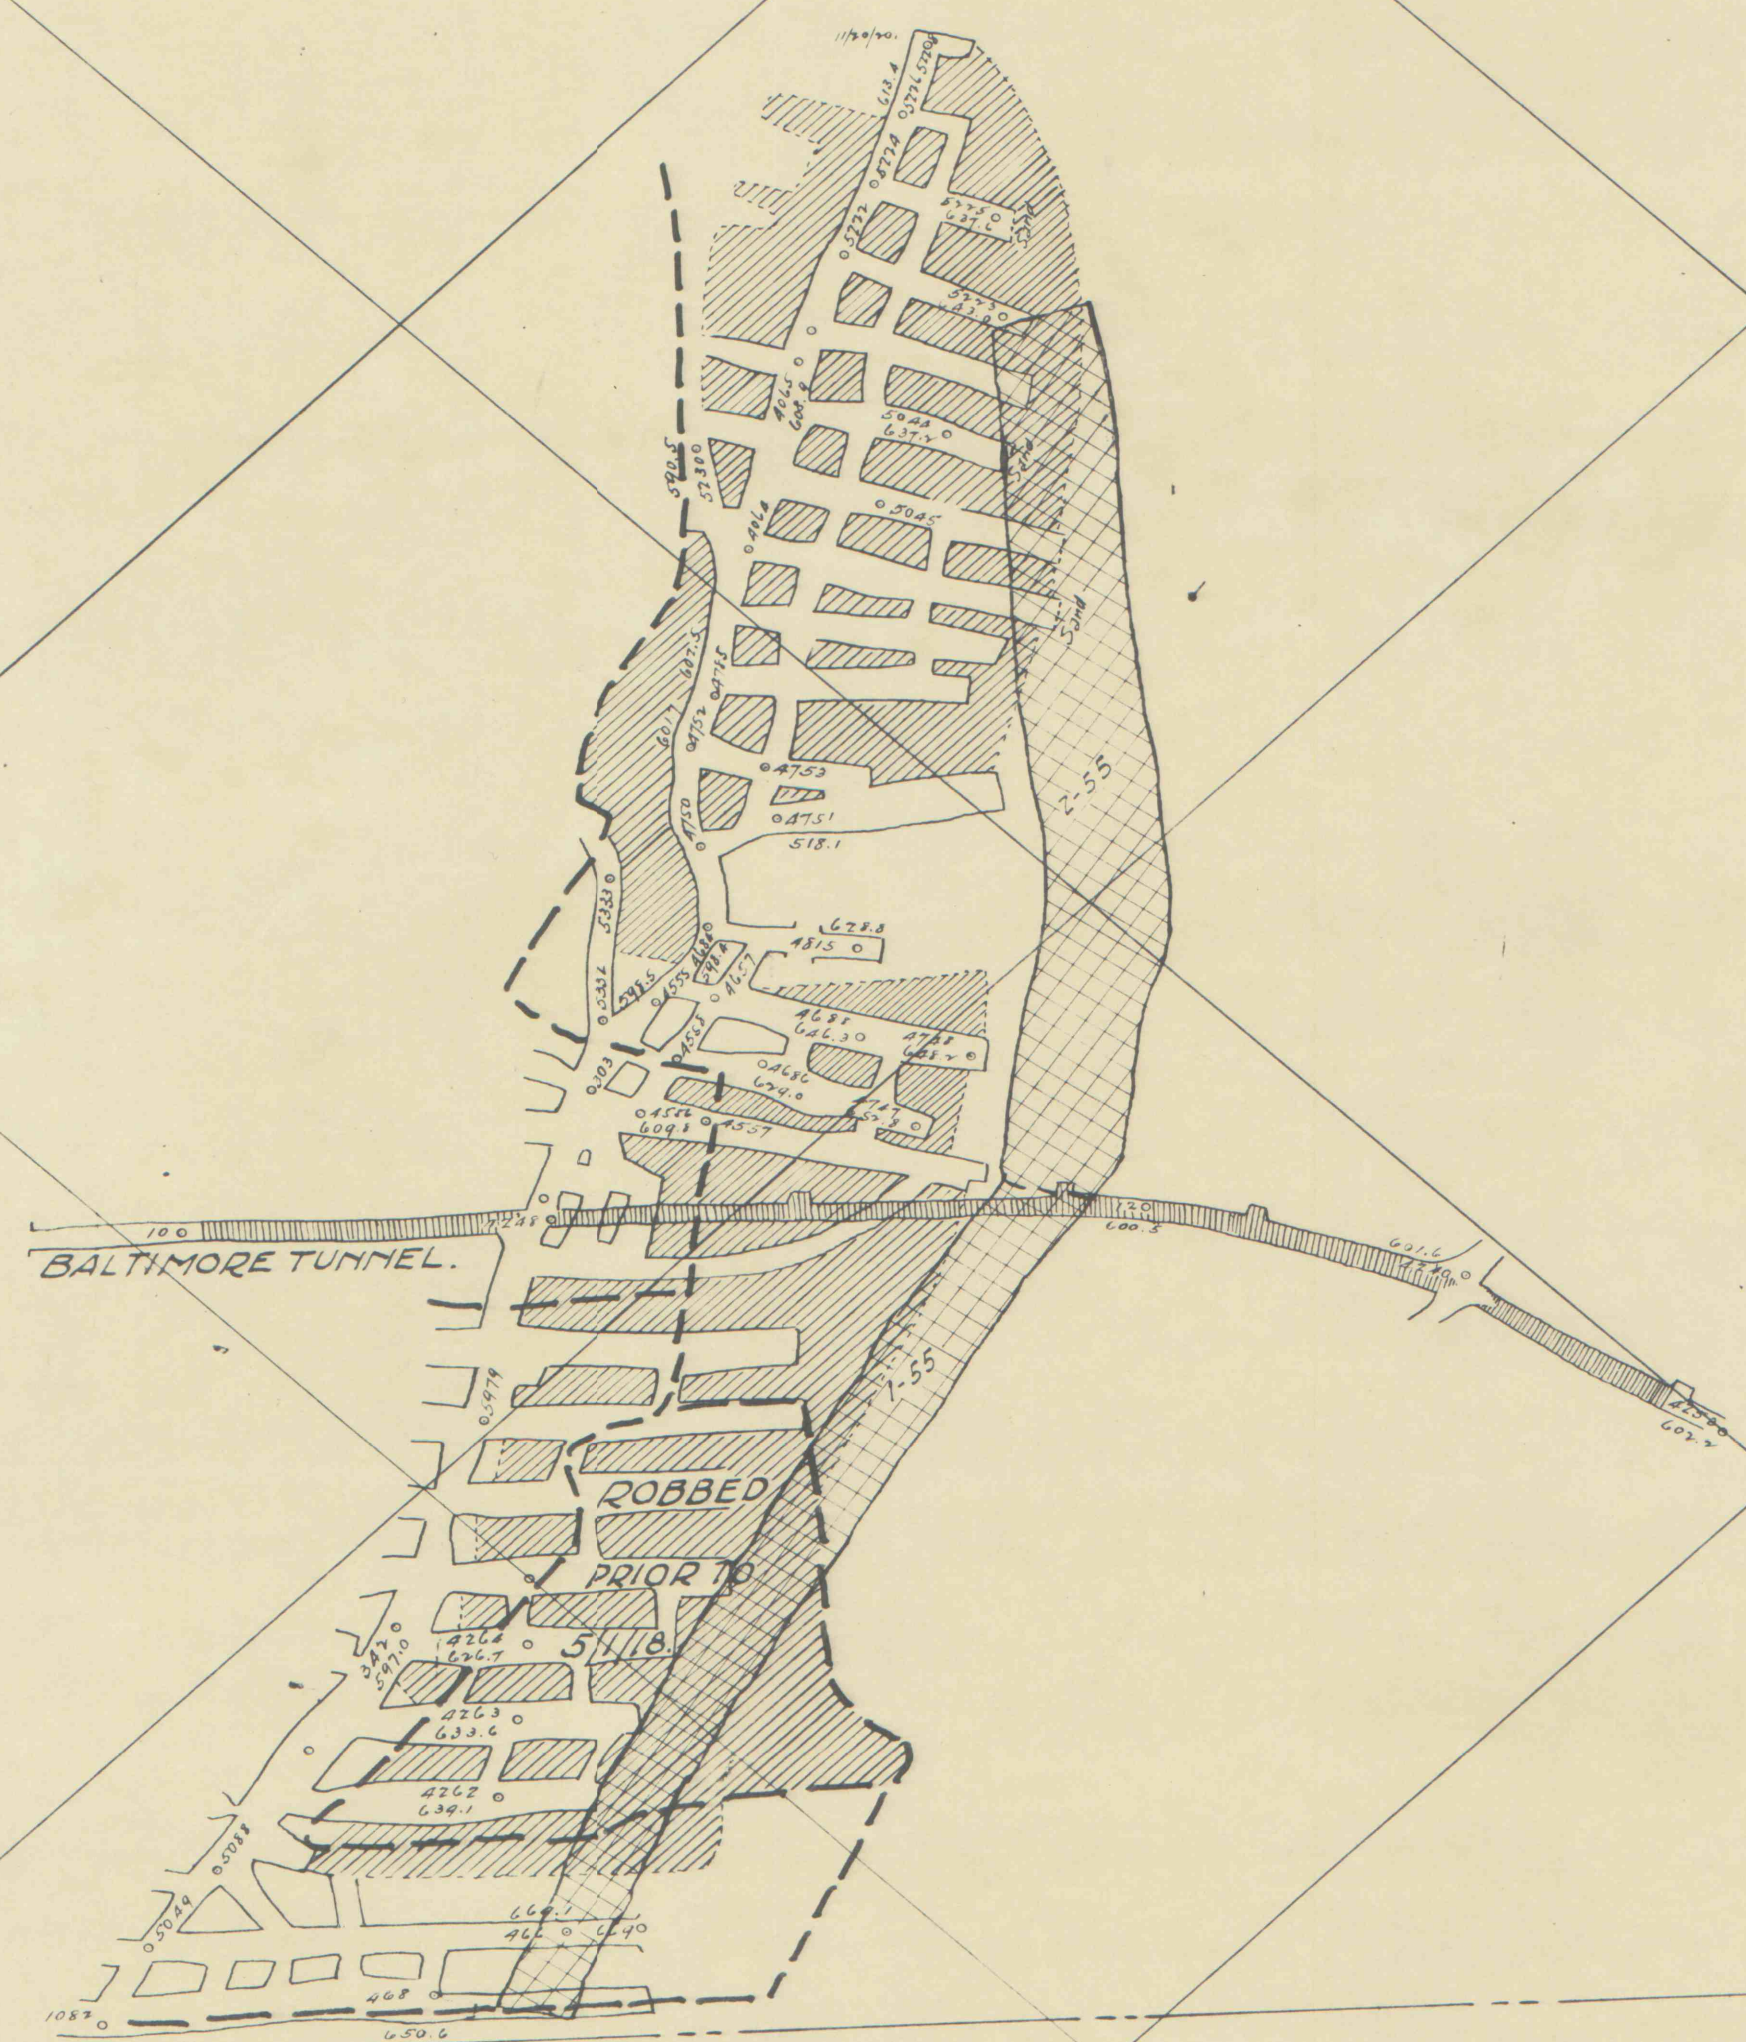

BALTIMORE COLLIERY.
STANTON BED.
SUPPLEMENT TO
WEST SECTION
SCALE 1"=100'