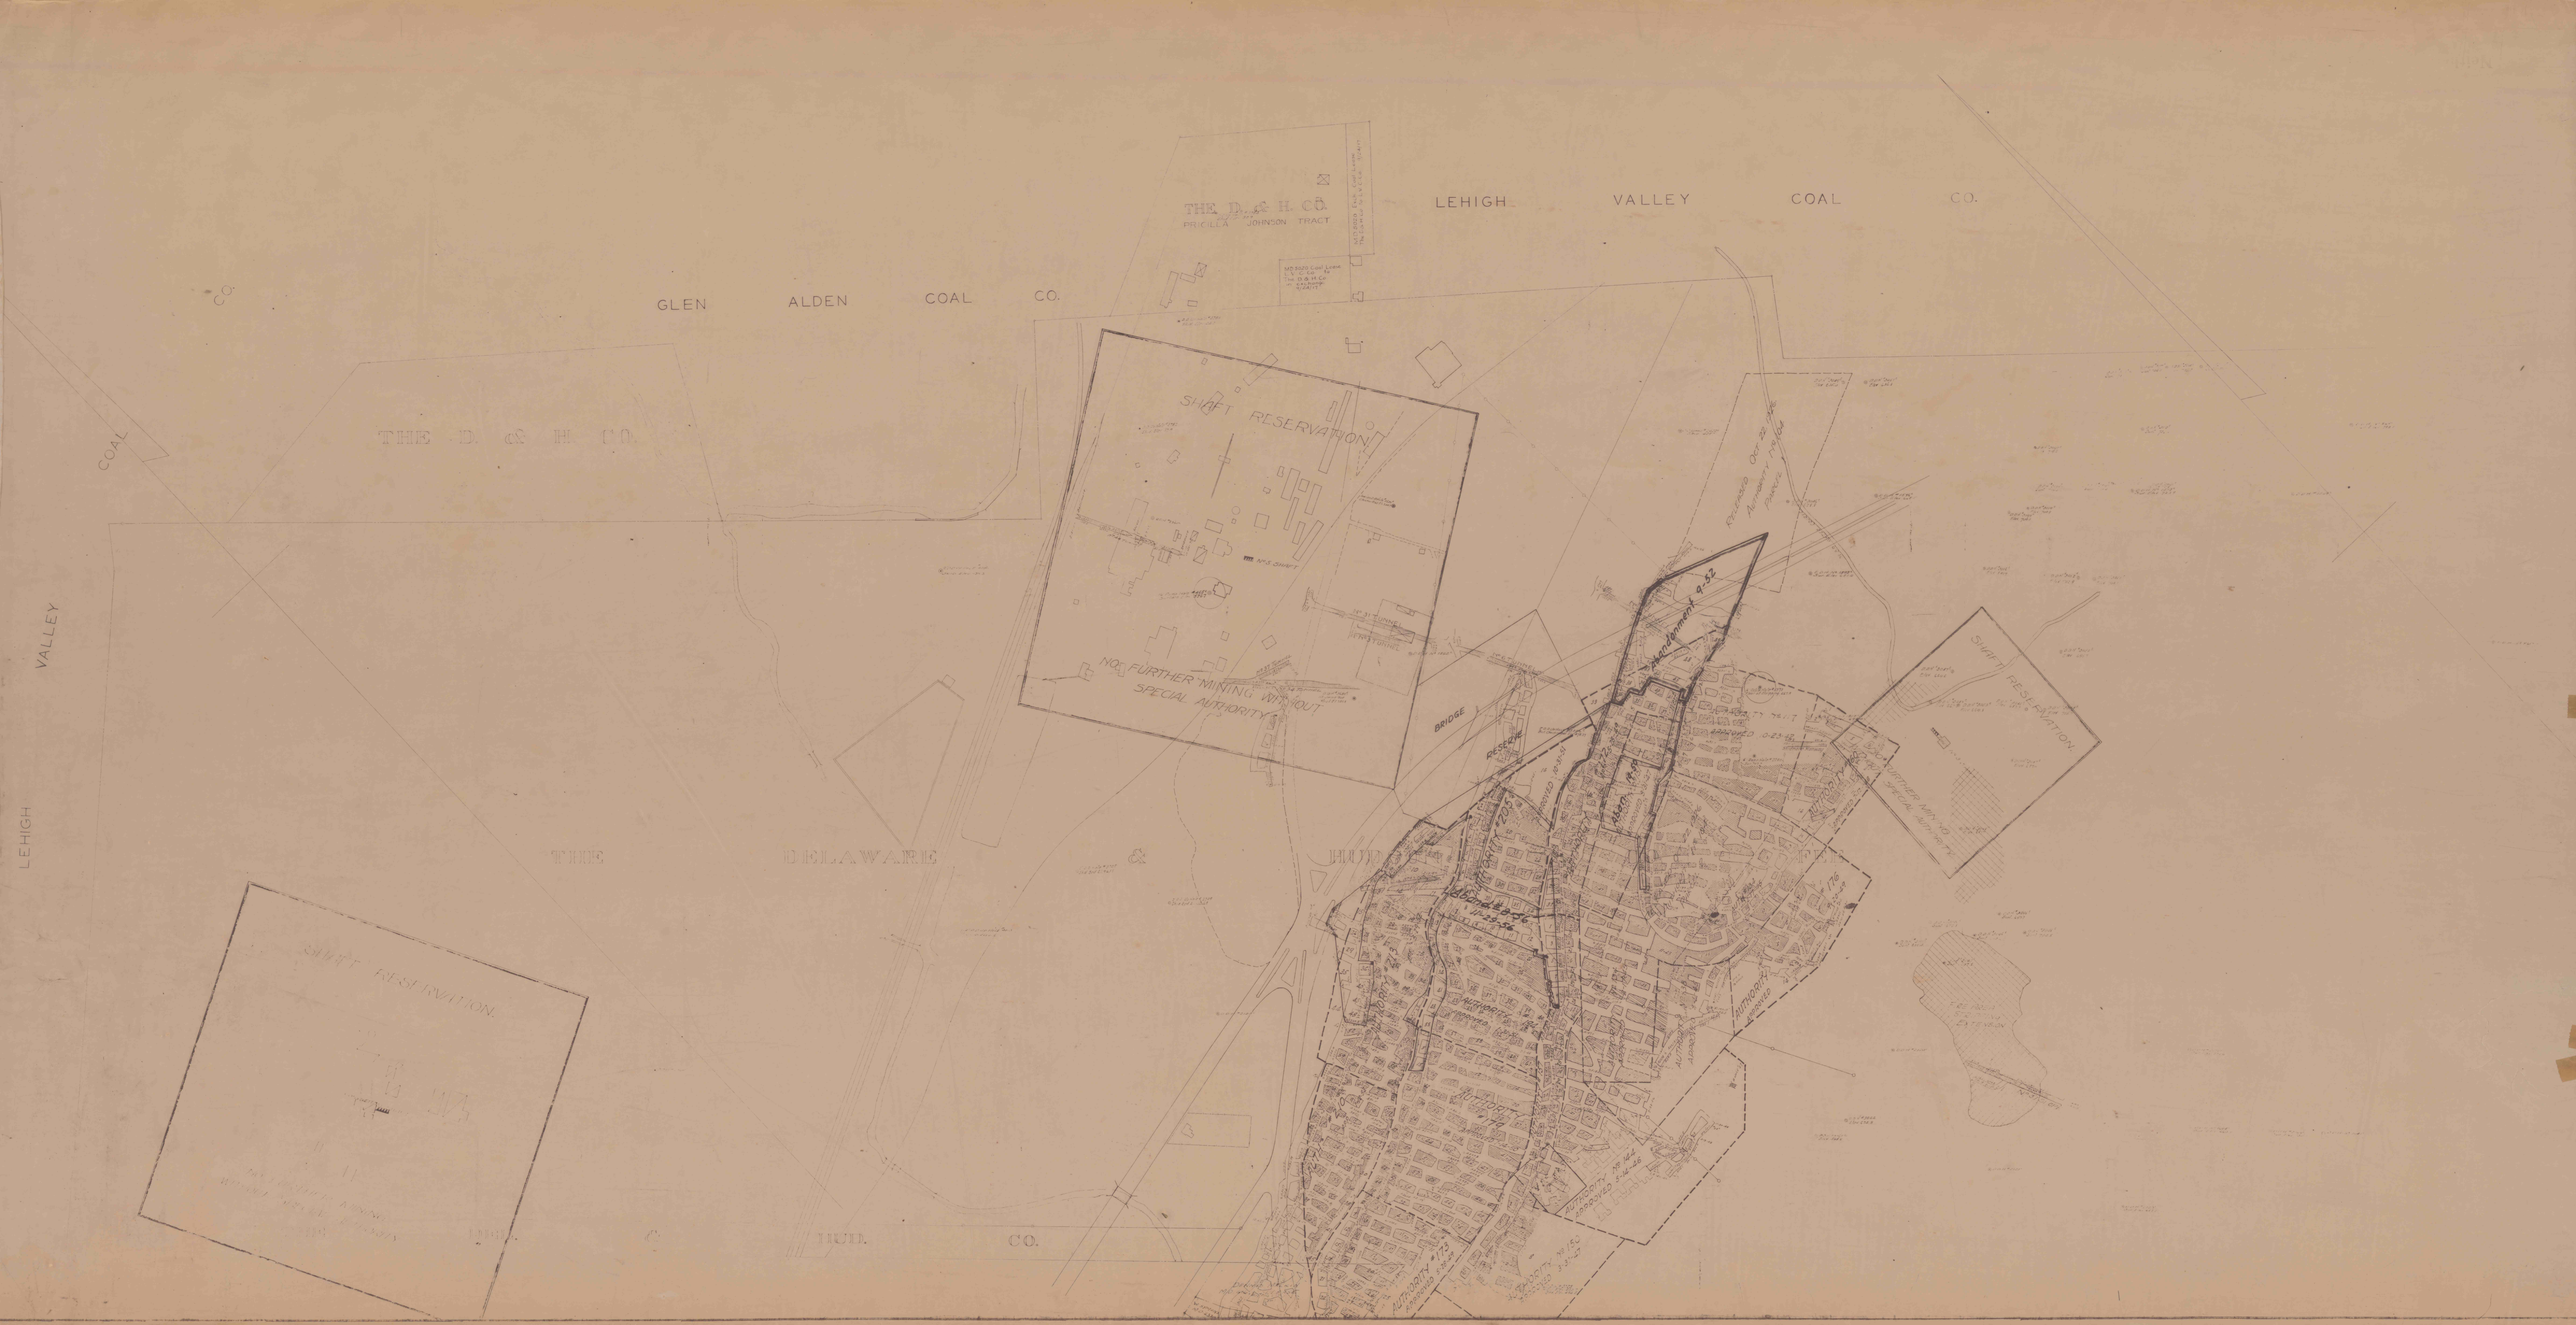
THE D. & H. CO.
PRISCILLA JOHNSON TRACT
LEHIGH VALLEY COAL CO.
GLEN ALDEN COAL CO.
THE D. & H. CO.
SHAFT RESERVATION
NO FURTHER MINING WITHOUT SPECIAL AUTHORITY
BRIDGE
RESERVE
SHAFT RESERVATION
SHAFT RESERVATION
THE DELAWARE & HUD.
HUD. CO.
LEHIGH VALLEY COAL