


N.F. 5 1/5

NORTH FRANKLIN COLLIERY
Cross Section 1700ft. East of Renny Tunnel
Scale 100' = 1" Inch Shamokin Dec 1st 1903

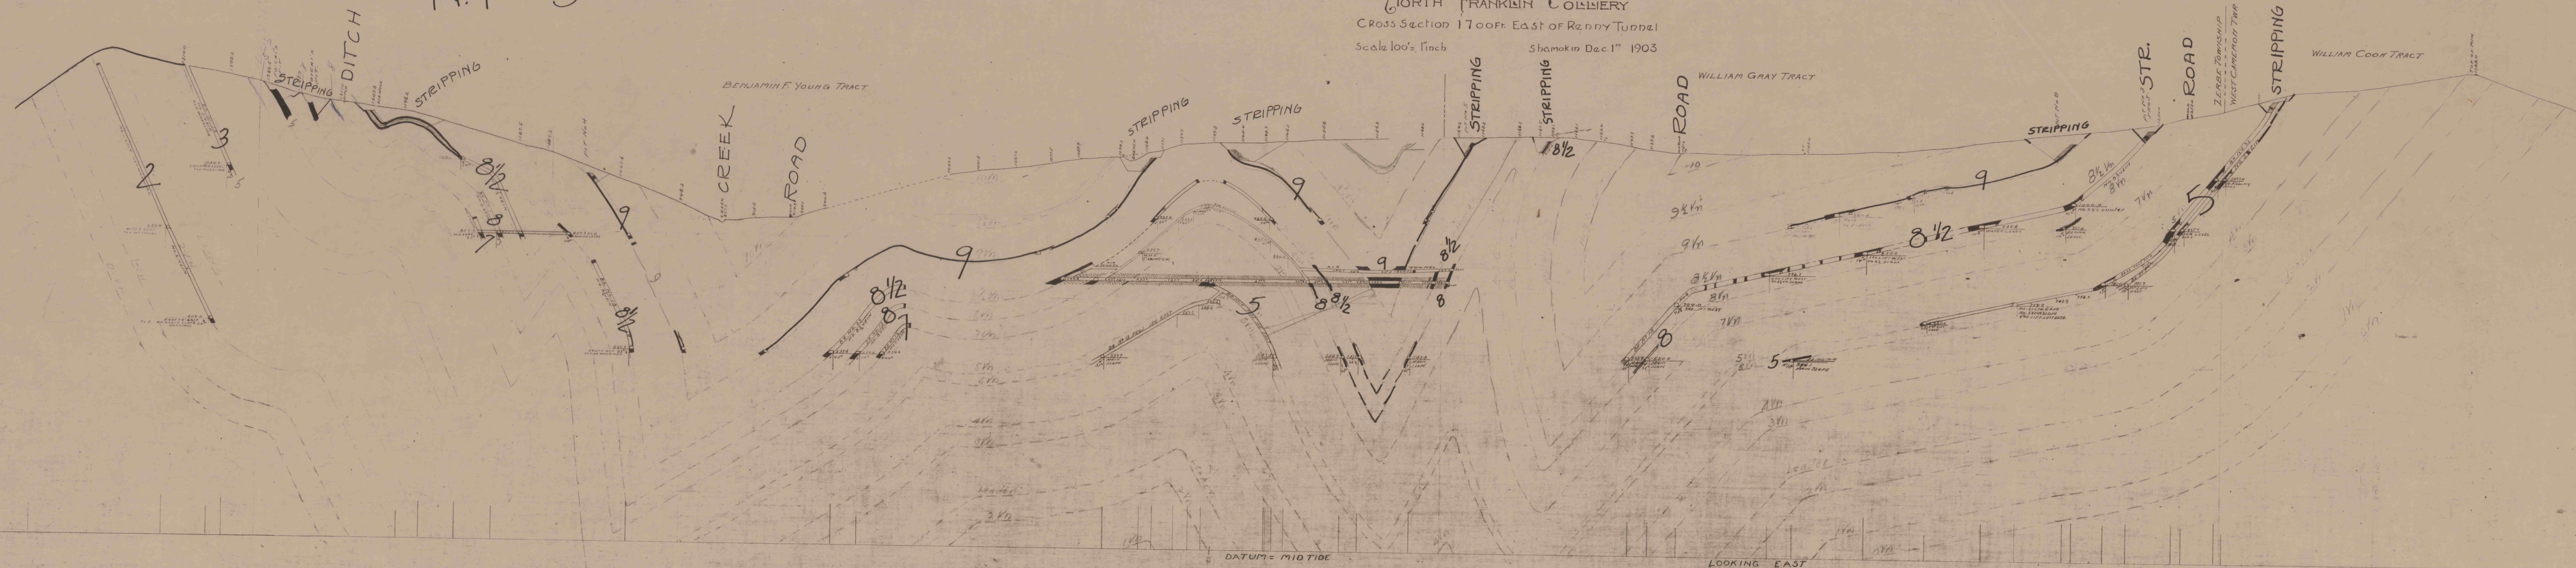

N.F.
5 1/5