Cross Section Looking East Through North Franklin Colliery

Scale 100'-1"

J.S. Kirkpatrick Civ. Engr. Shamokin Pa. Feb 25 1904.

5 1/16 780 Ft. East of Penny Tunnel.

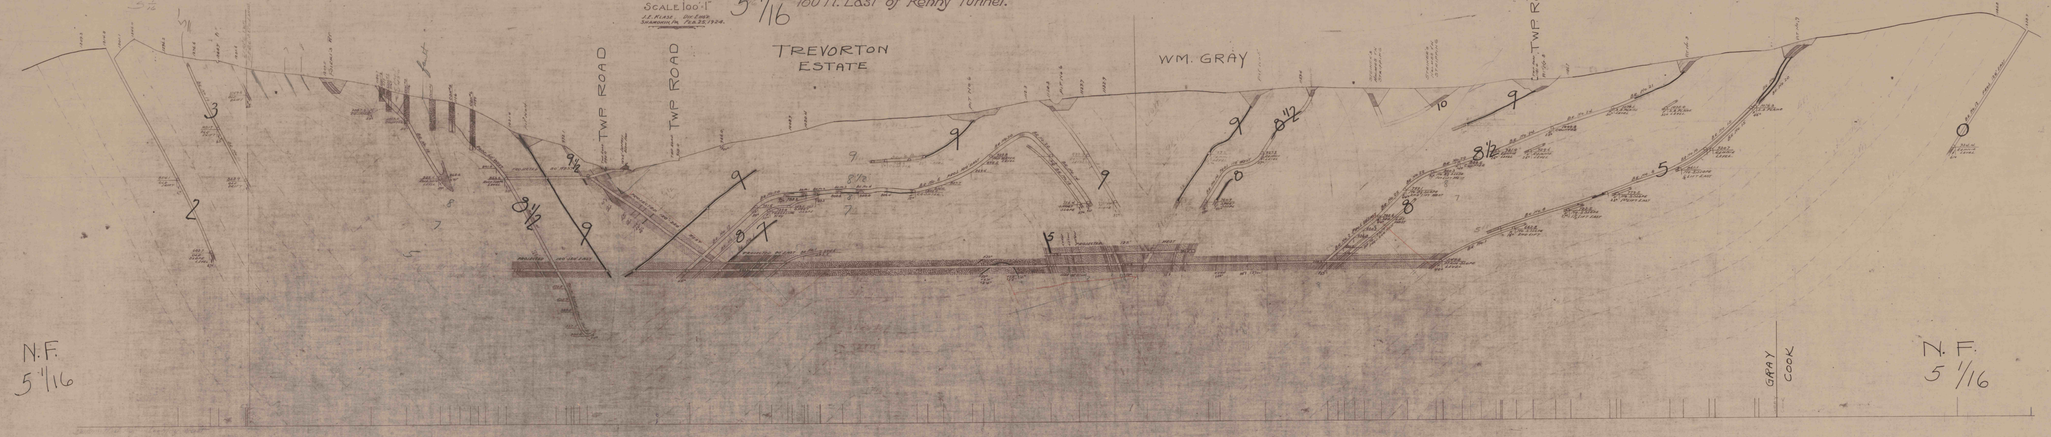

No. Franklin 5 1/16