


North Franklin Colliery
Scale 1" = 100'

Cross Section Looking East
THROUGH North Franklin Colliery — 5 1/17

SCALE 100' = 1"


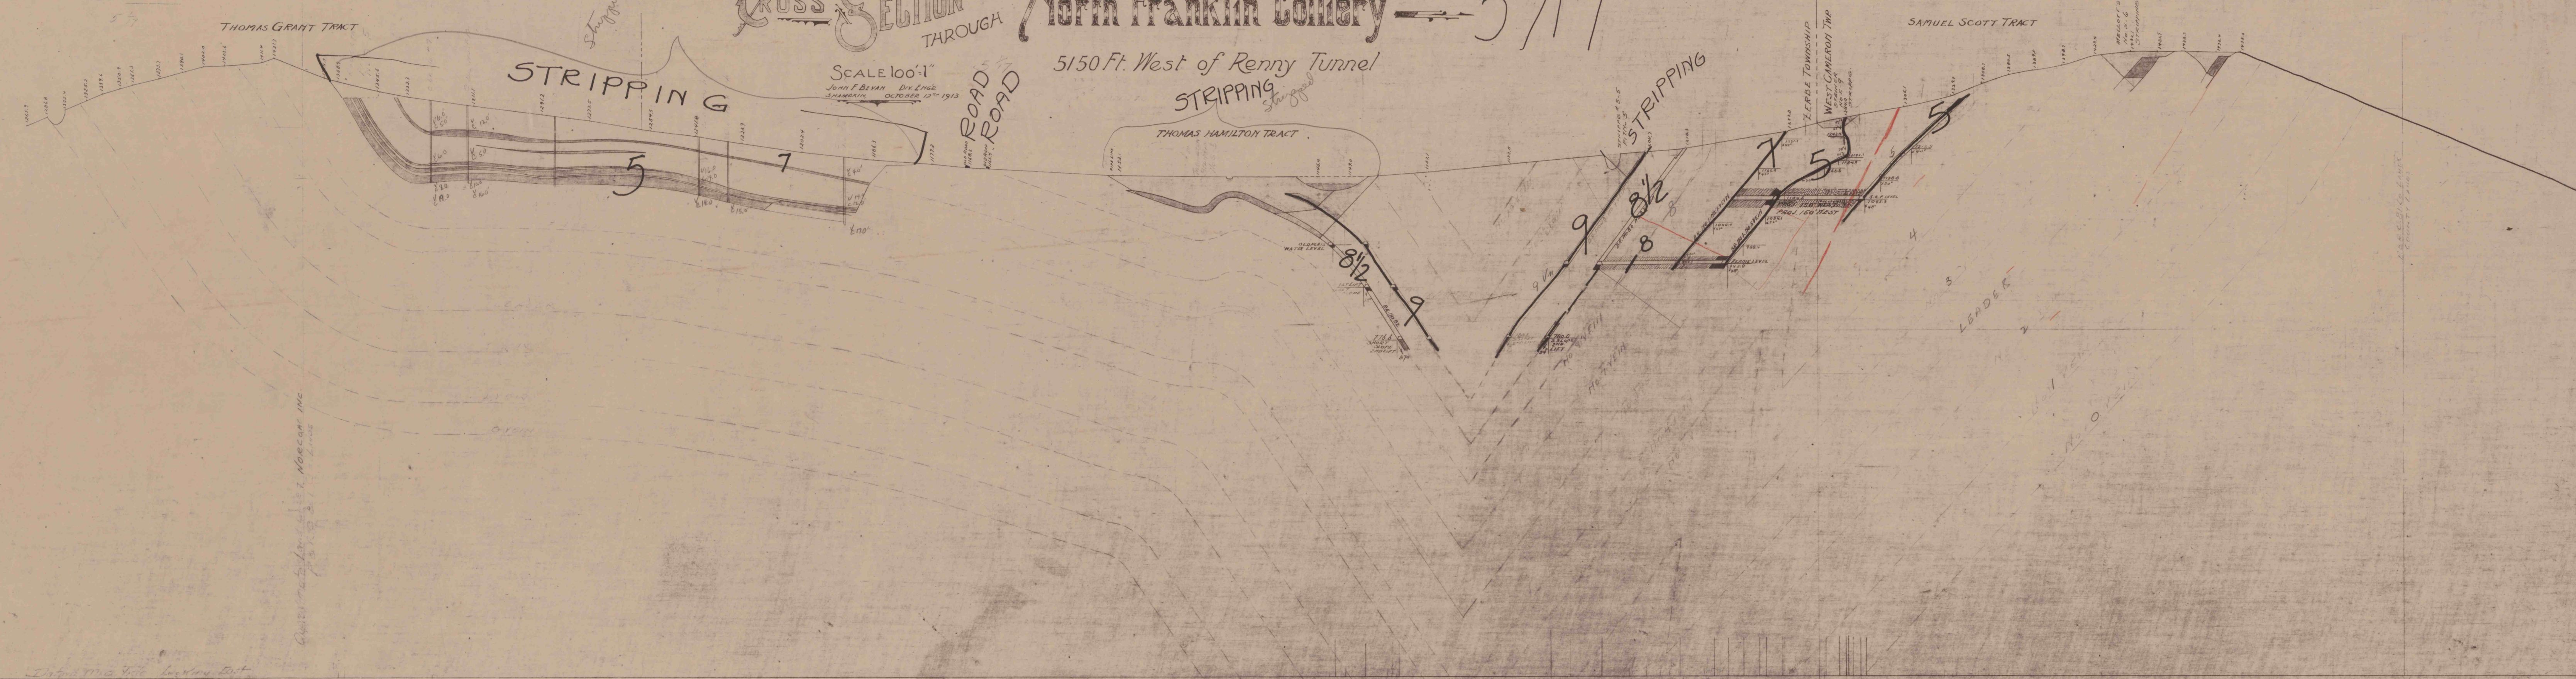

ROAD