


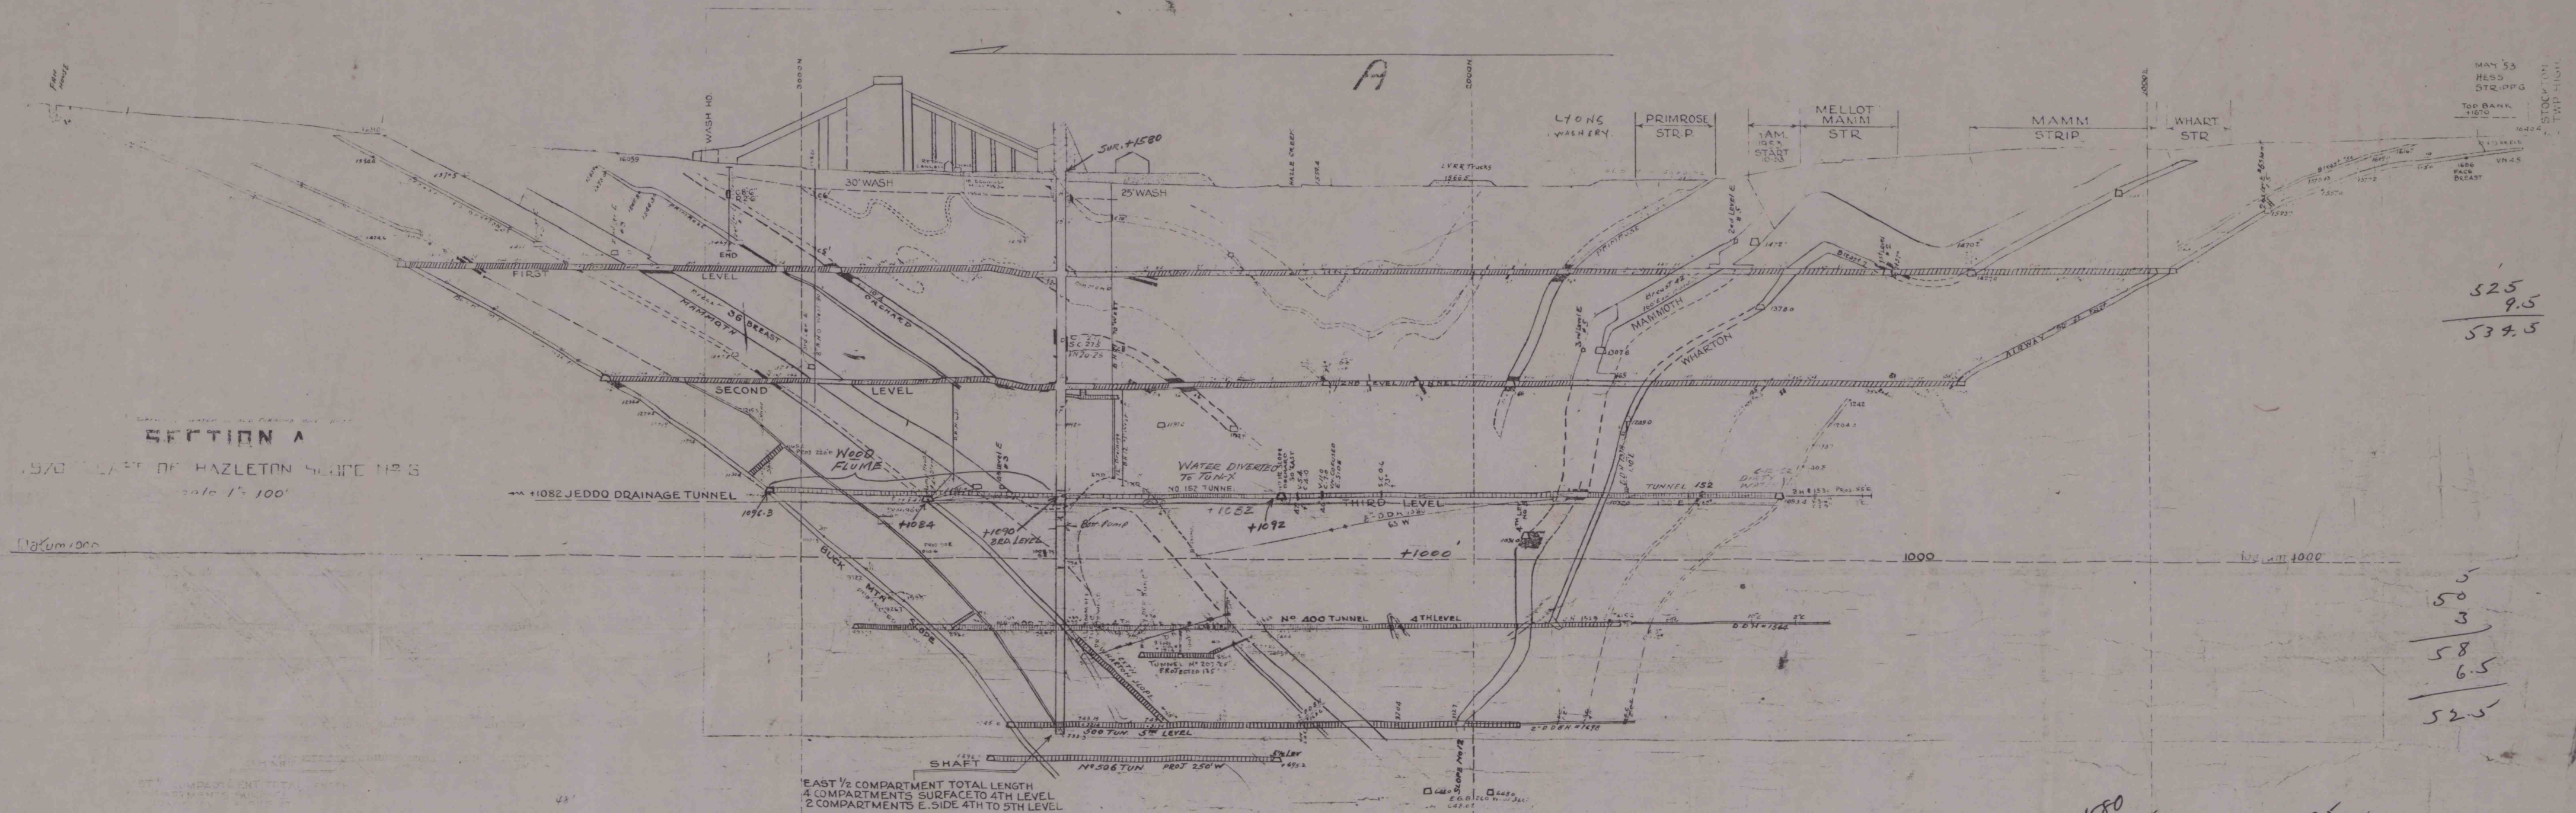

SECTION A

1/20' EAST OF HAZLETON SHAFT NO. 3
Scale 1" = 100'

EAST 1/2 COMPARTMENT TOTAL LENGTH
4 COMPARTMENTS SURFACE TO 4TH LEVEL
2 COMPARTMENTS E. SIDE 4TH TO 5TH LEVEL

SURFACE	1579.6	
FIRST LEVEL	1421.75	1577.85
SECOND "	1253.05	1420.70
THIRD "	1090.75	1252.55
FOURTH "	889.80	1088.95
FIFTH "	743.40	932.20
SUMP	732.90	

Surface to 2nd Level 1577.85
Surface to 3rd Level 1420.70

525
9.5
534.5

5
50
3
58
6.5
52.5

9.5
470.0
479.5
- 7.0
472.5

1580
484.5
1095.5
1045.5
50.0

525
9.5
534.5
- 5
529.5

529.5
481.5
48.0

1580
534.5
1045.5

525
9.5
534.5
484.5
50.0

HAZLETON SHAFT NO. 3
1/20' EAST OF HAZLETON SHAFT NO. 3
Scale 1" = 100'