OTTO #31

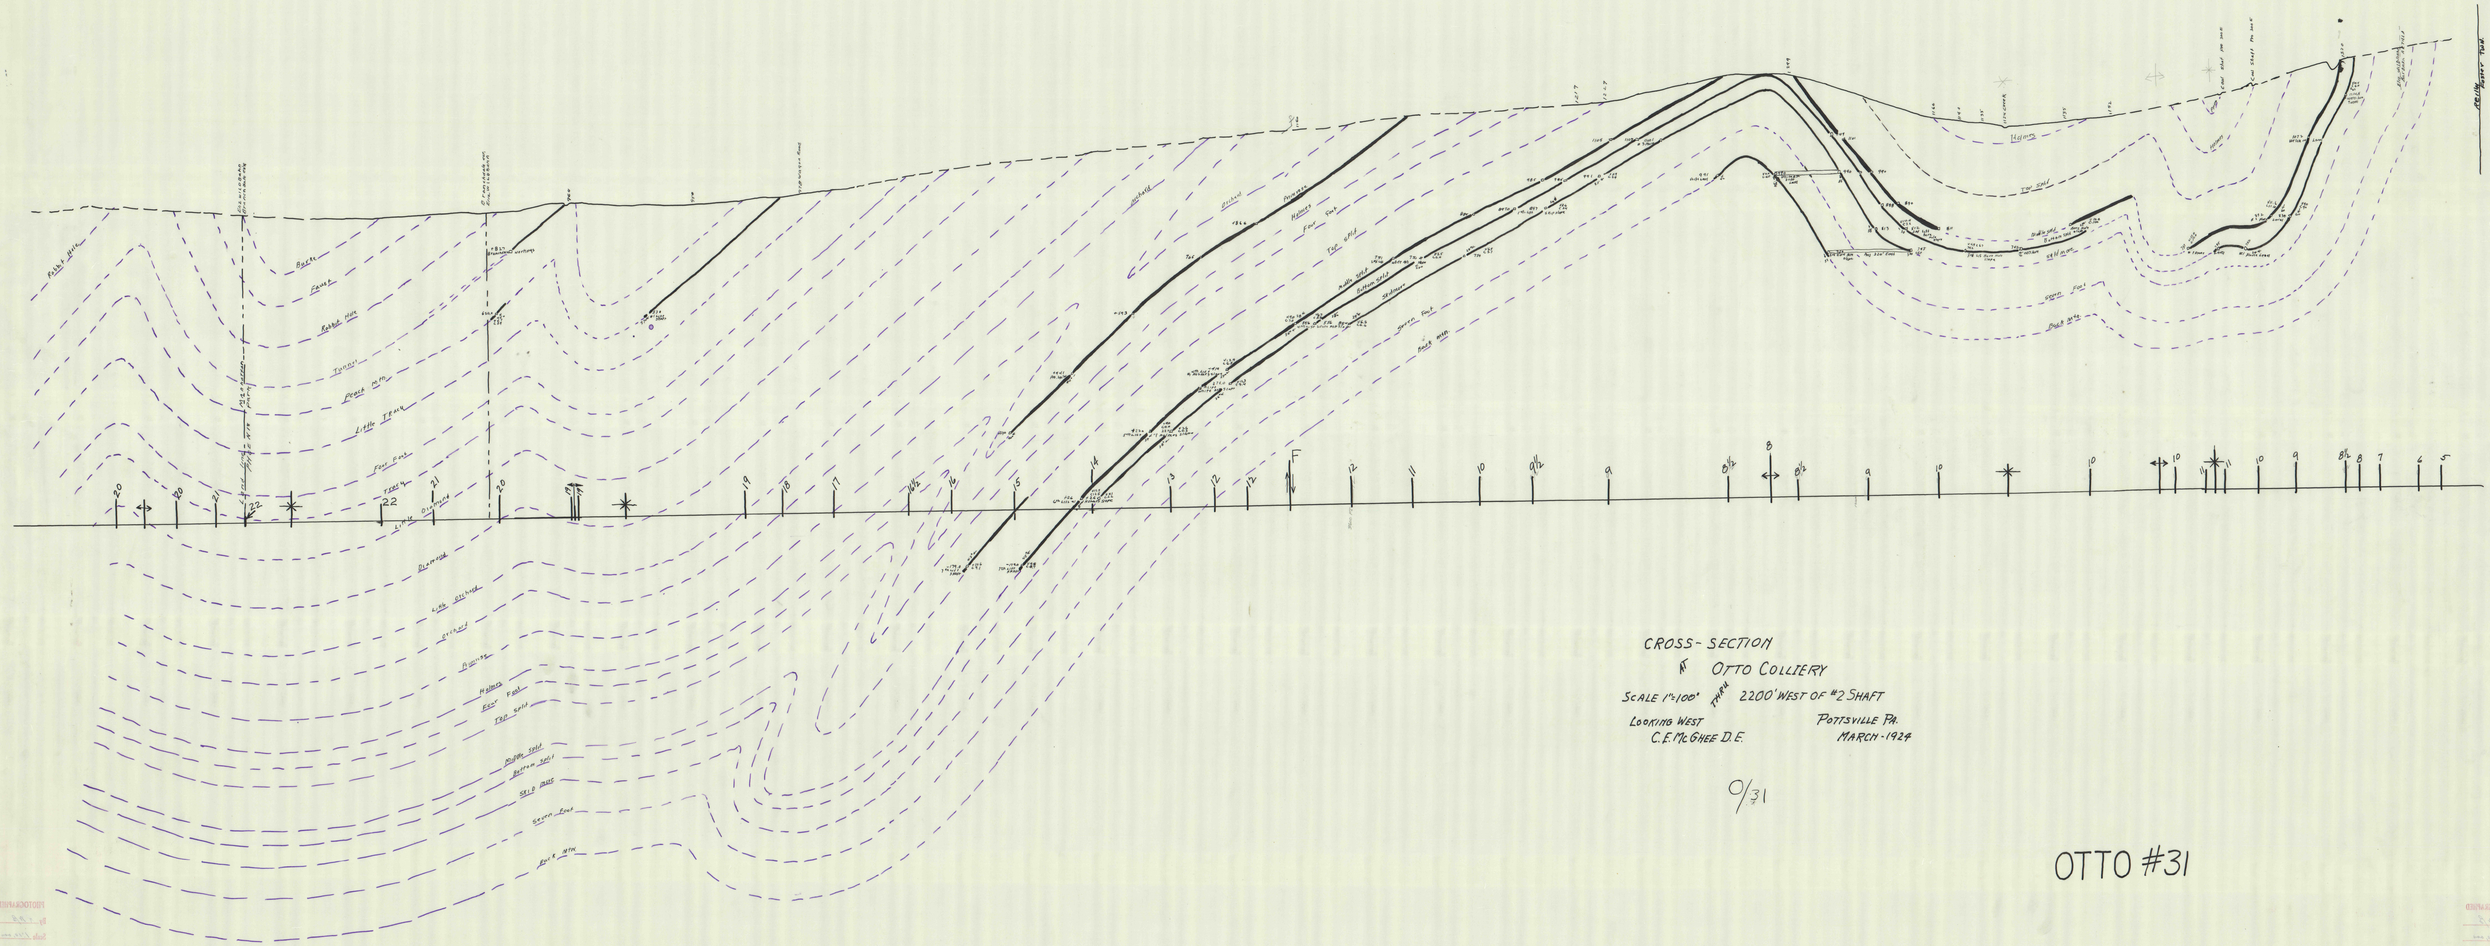

CROSS-SECTION
AT OTTO COLLIERY
SCALE 1"=100' THRU 2200' WEST OF #2 SHAFT
LOOKING WEST POTTSVILLE PA.
C.E. McGHEE D.E. MARCH-1924

0/31

OTTO #31