0.26

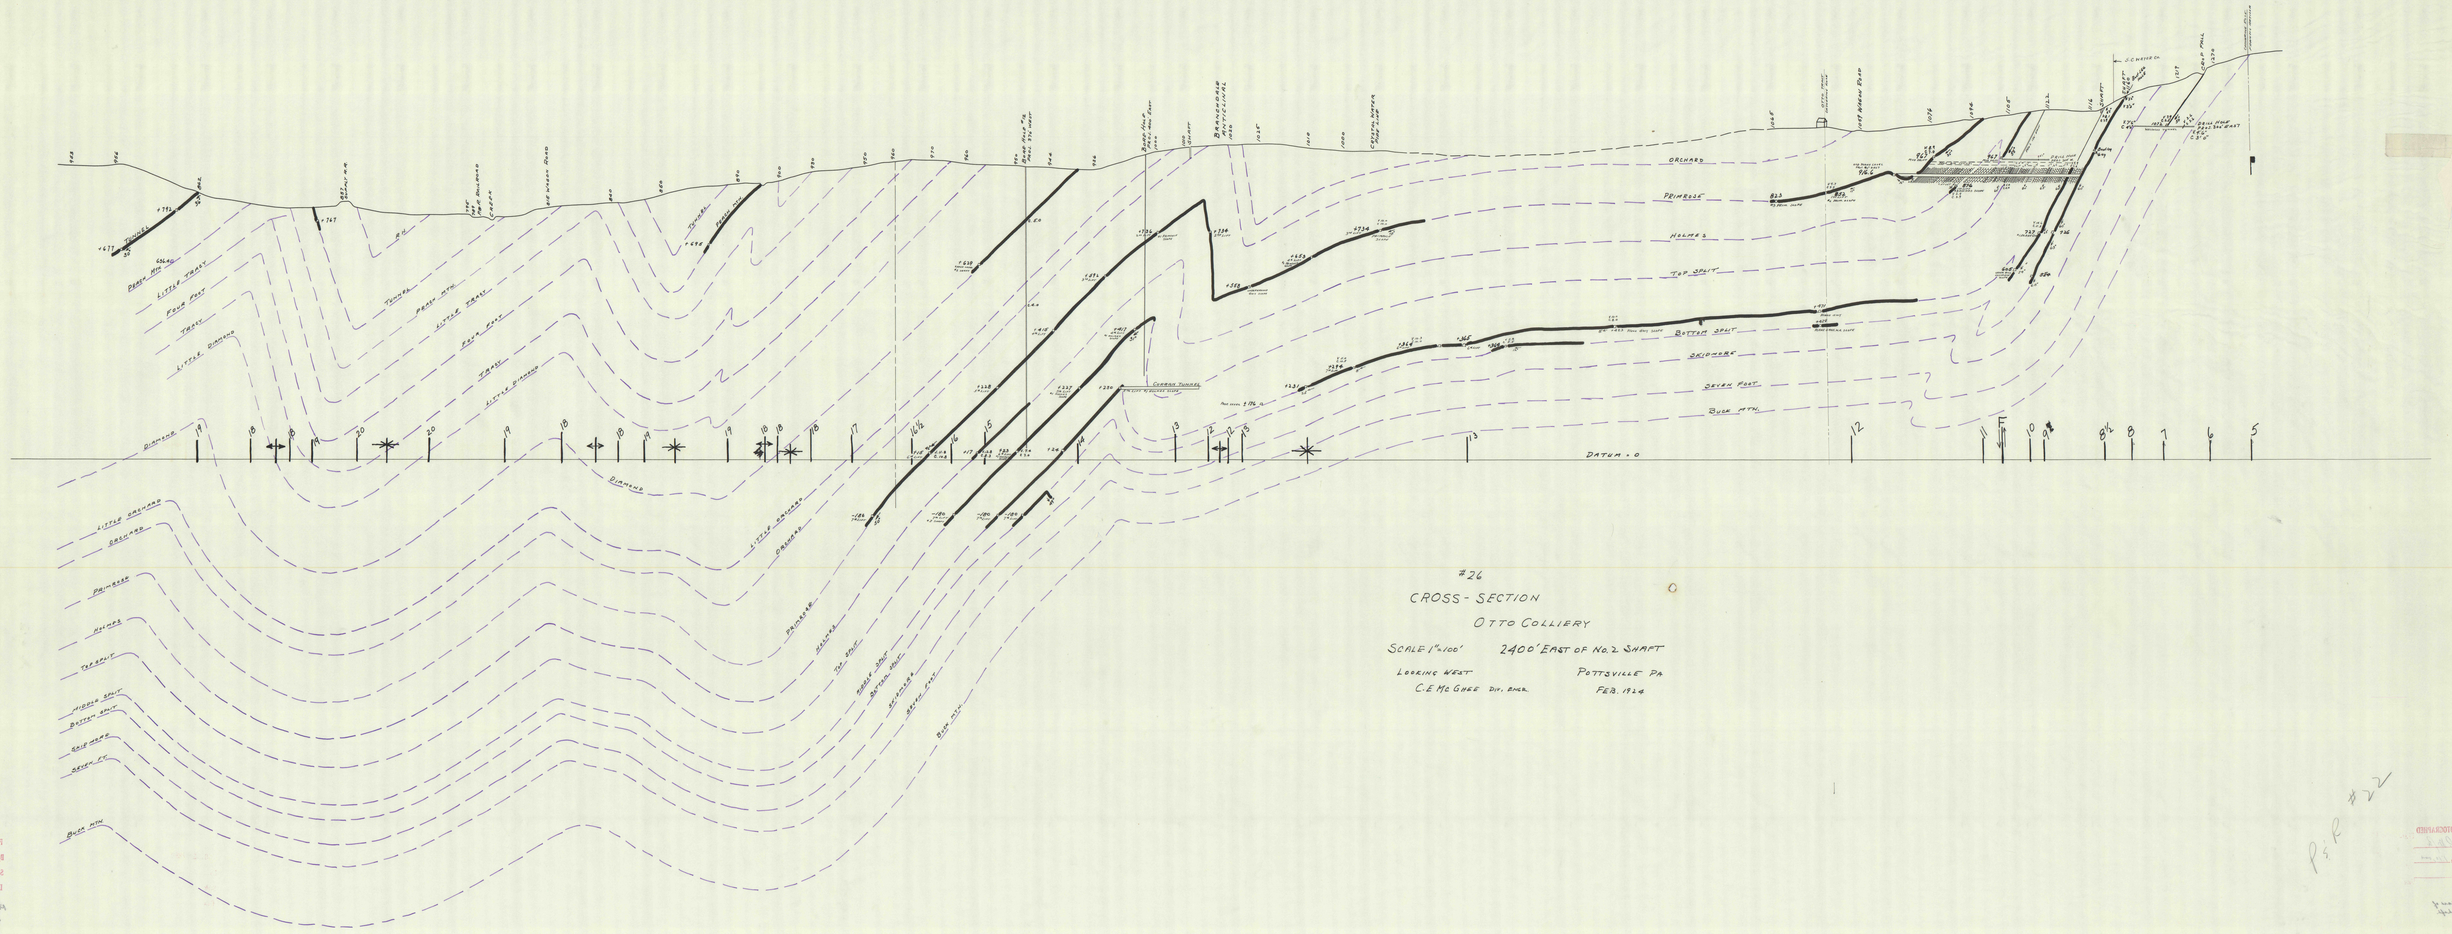


#26

CROSS-SECTION

OTTO COLLIERY

SCALE 1" = 100'  2400' EAST OF No. 2 SHAFT

LOOKING WEST  POTTSVILLE PA

C.E McGHEE DIV. ENGR.  FEB. 1924

#22

P.S.P