


2-4
Tondelife-Checker Des-#128 Drift

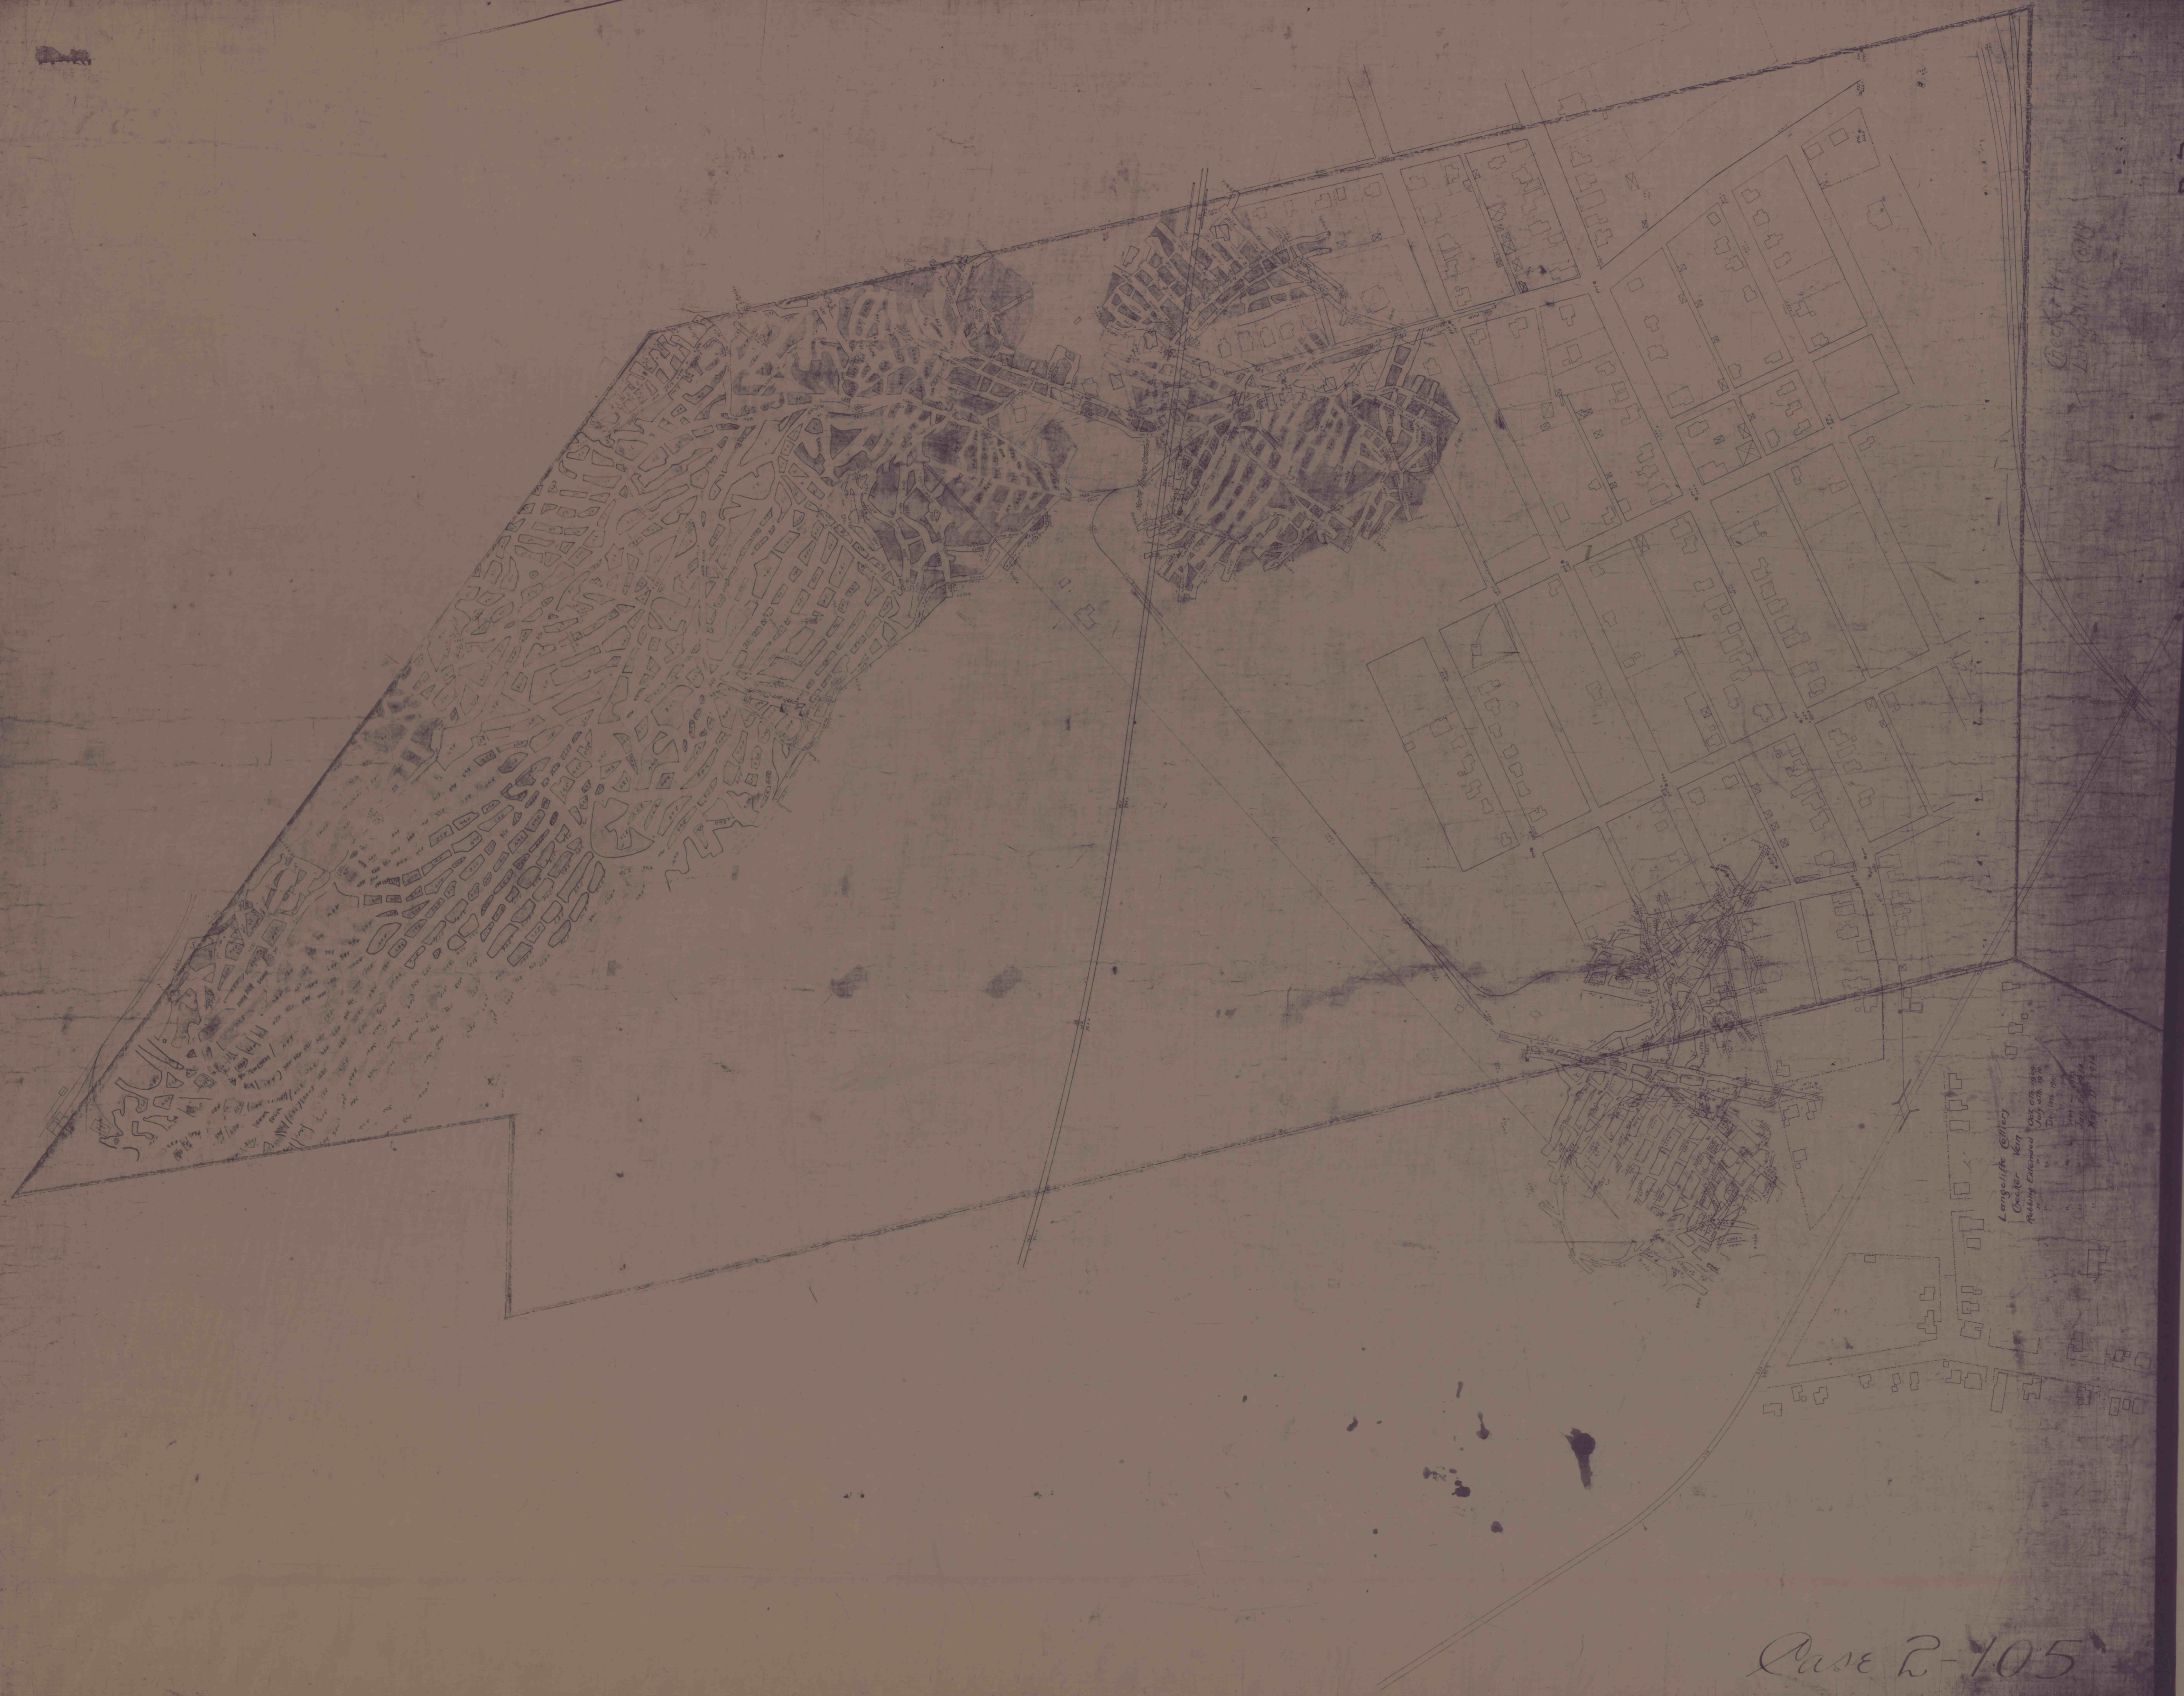

Case R-105