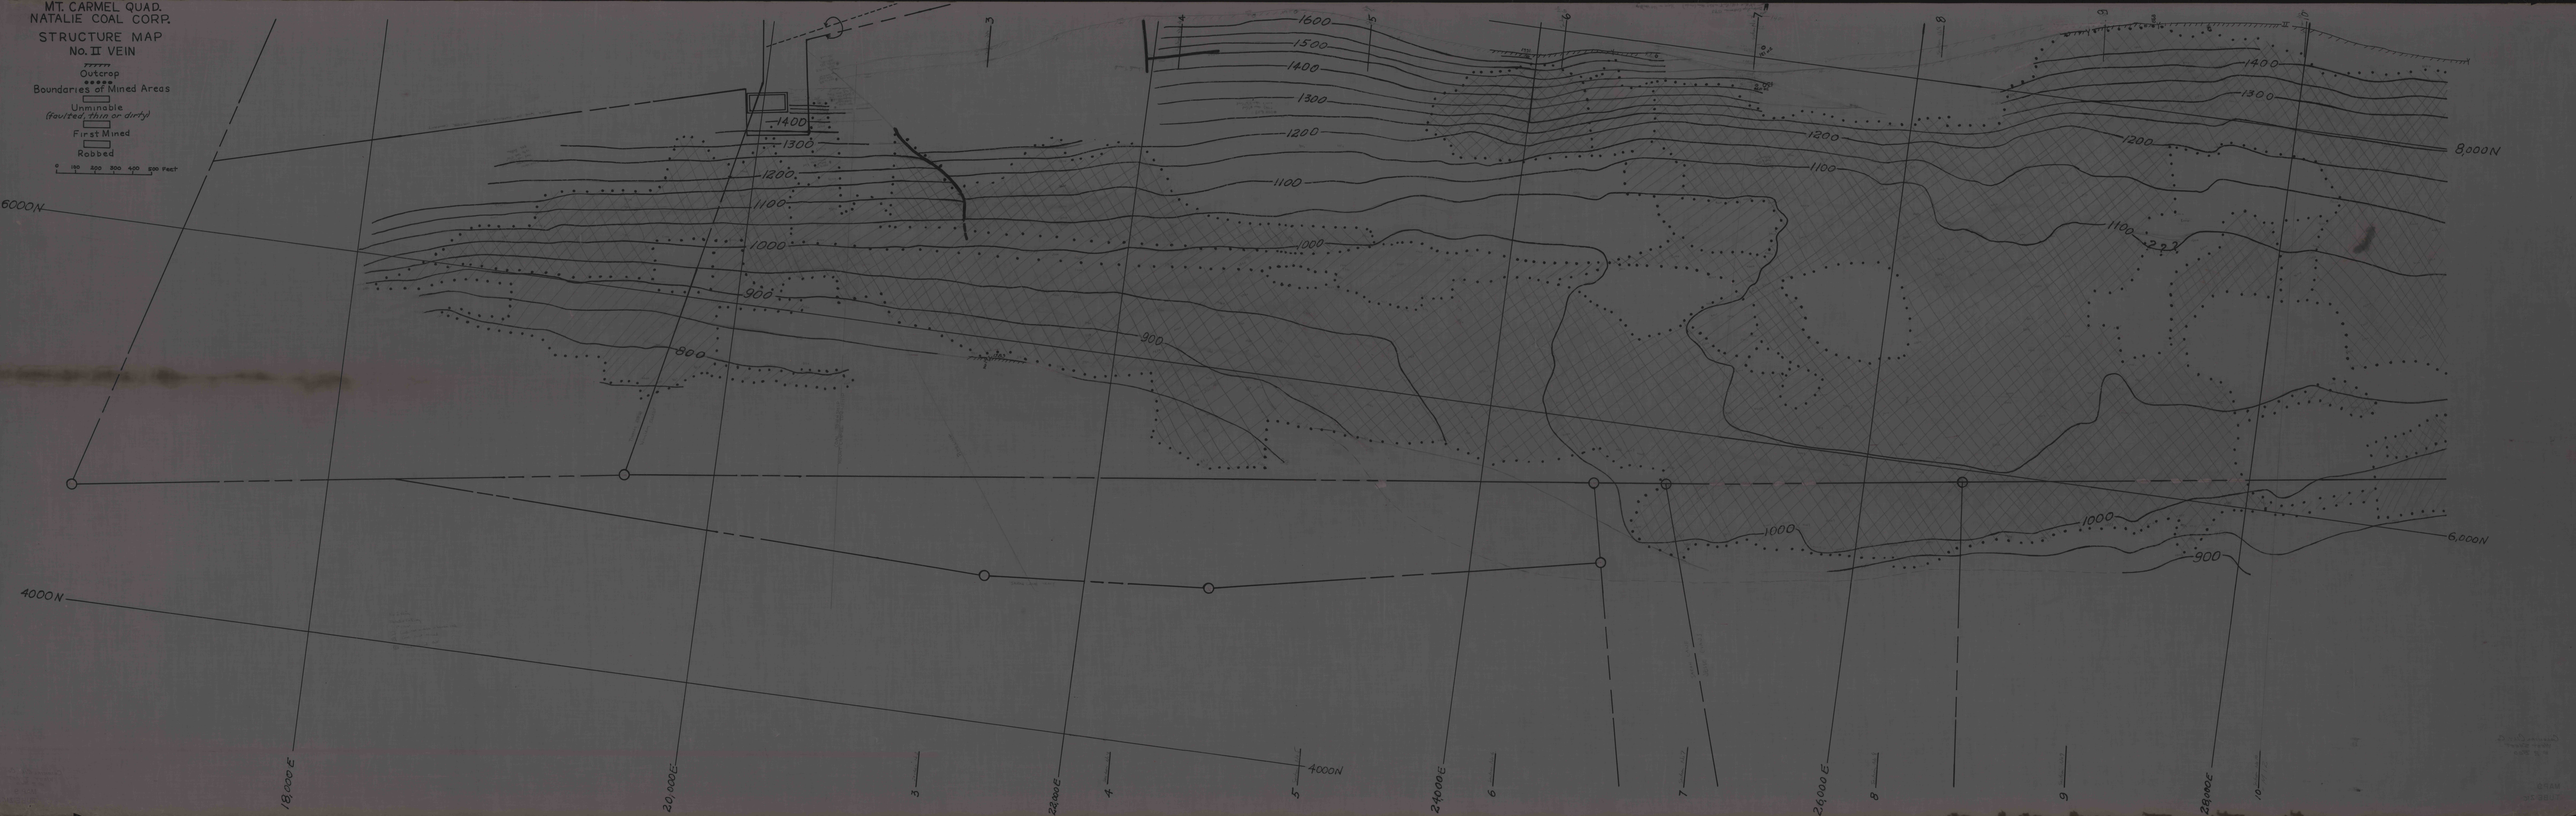
MT. CARMEL QUAD.
NATALIE COAL CORP.
STRUCTURE MAP
No. II VEIN
Outcrop
Boundaries of Mined Areas
Unminable
(faulted, thin or dirty)
First Mined
Robbed
0 100 200 300 400 500 FEET
6000N
4000N
8,000N
6,000N
1600
1500
1400
1300
1200
1100
1000
900
800
18,000E
20,000E
22,000E
24,000E
26,000E
28,000E
3
4
5
6
7
8
9
10