


YERS.

JOHN REYNOLDS.

THOS. BILLINGTON.

MARY R

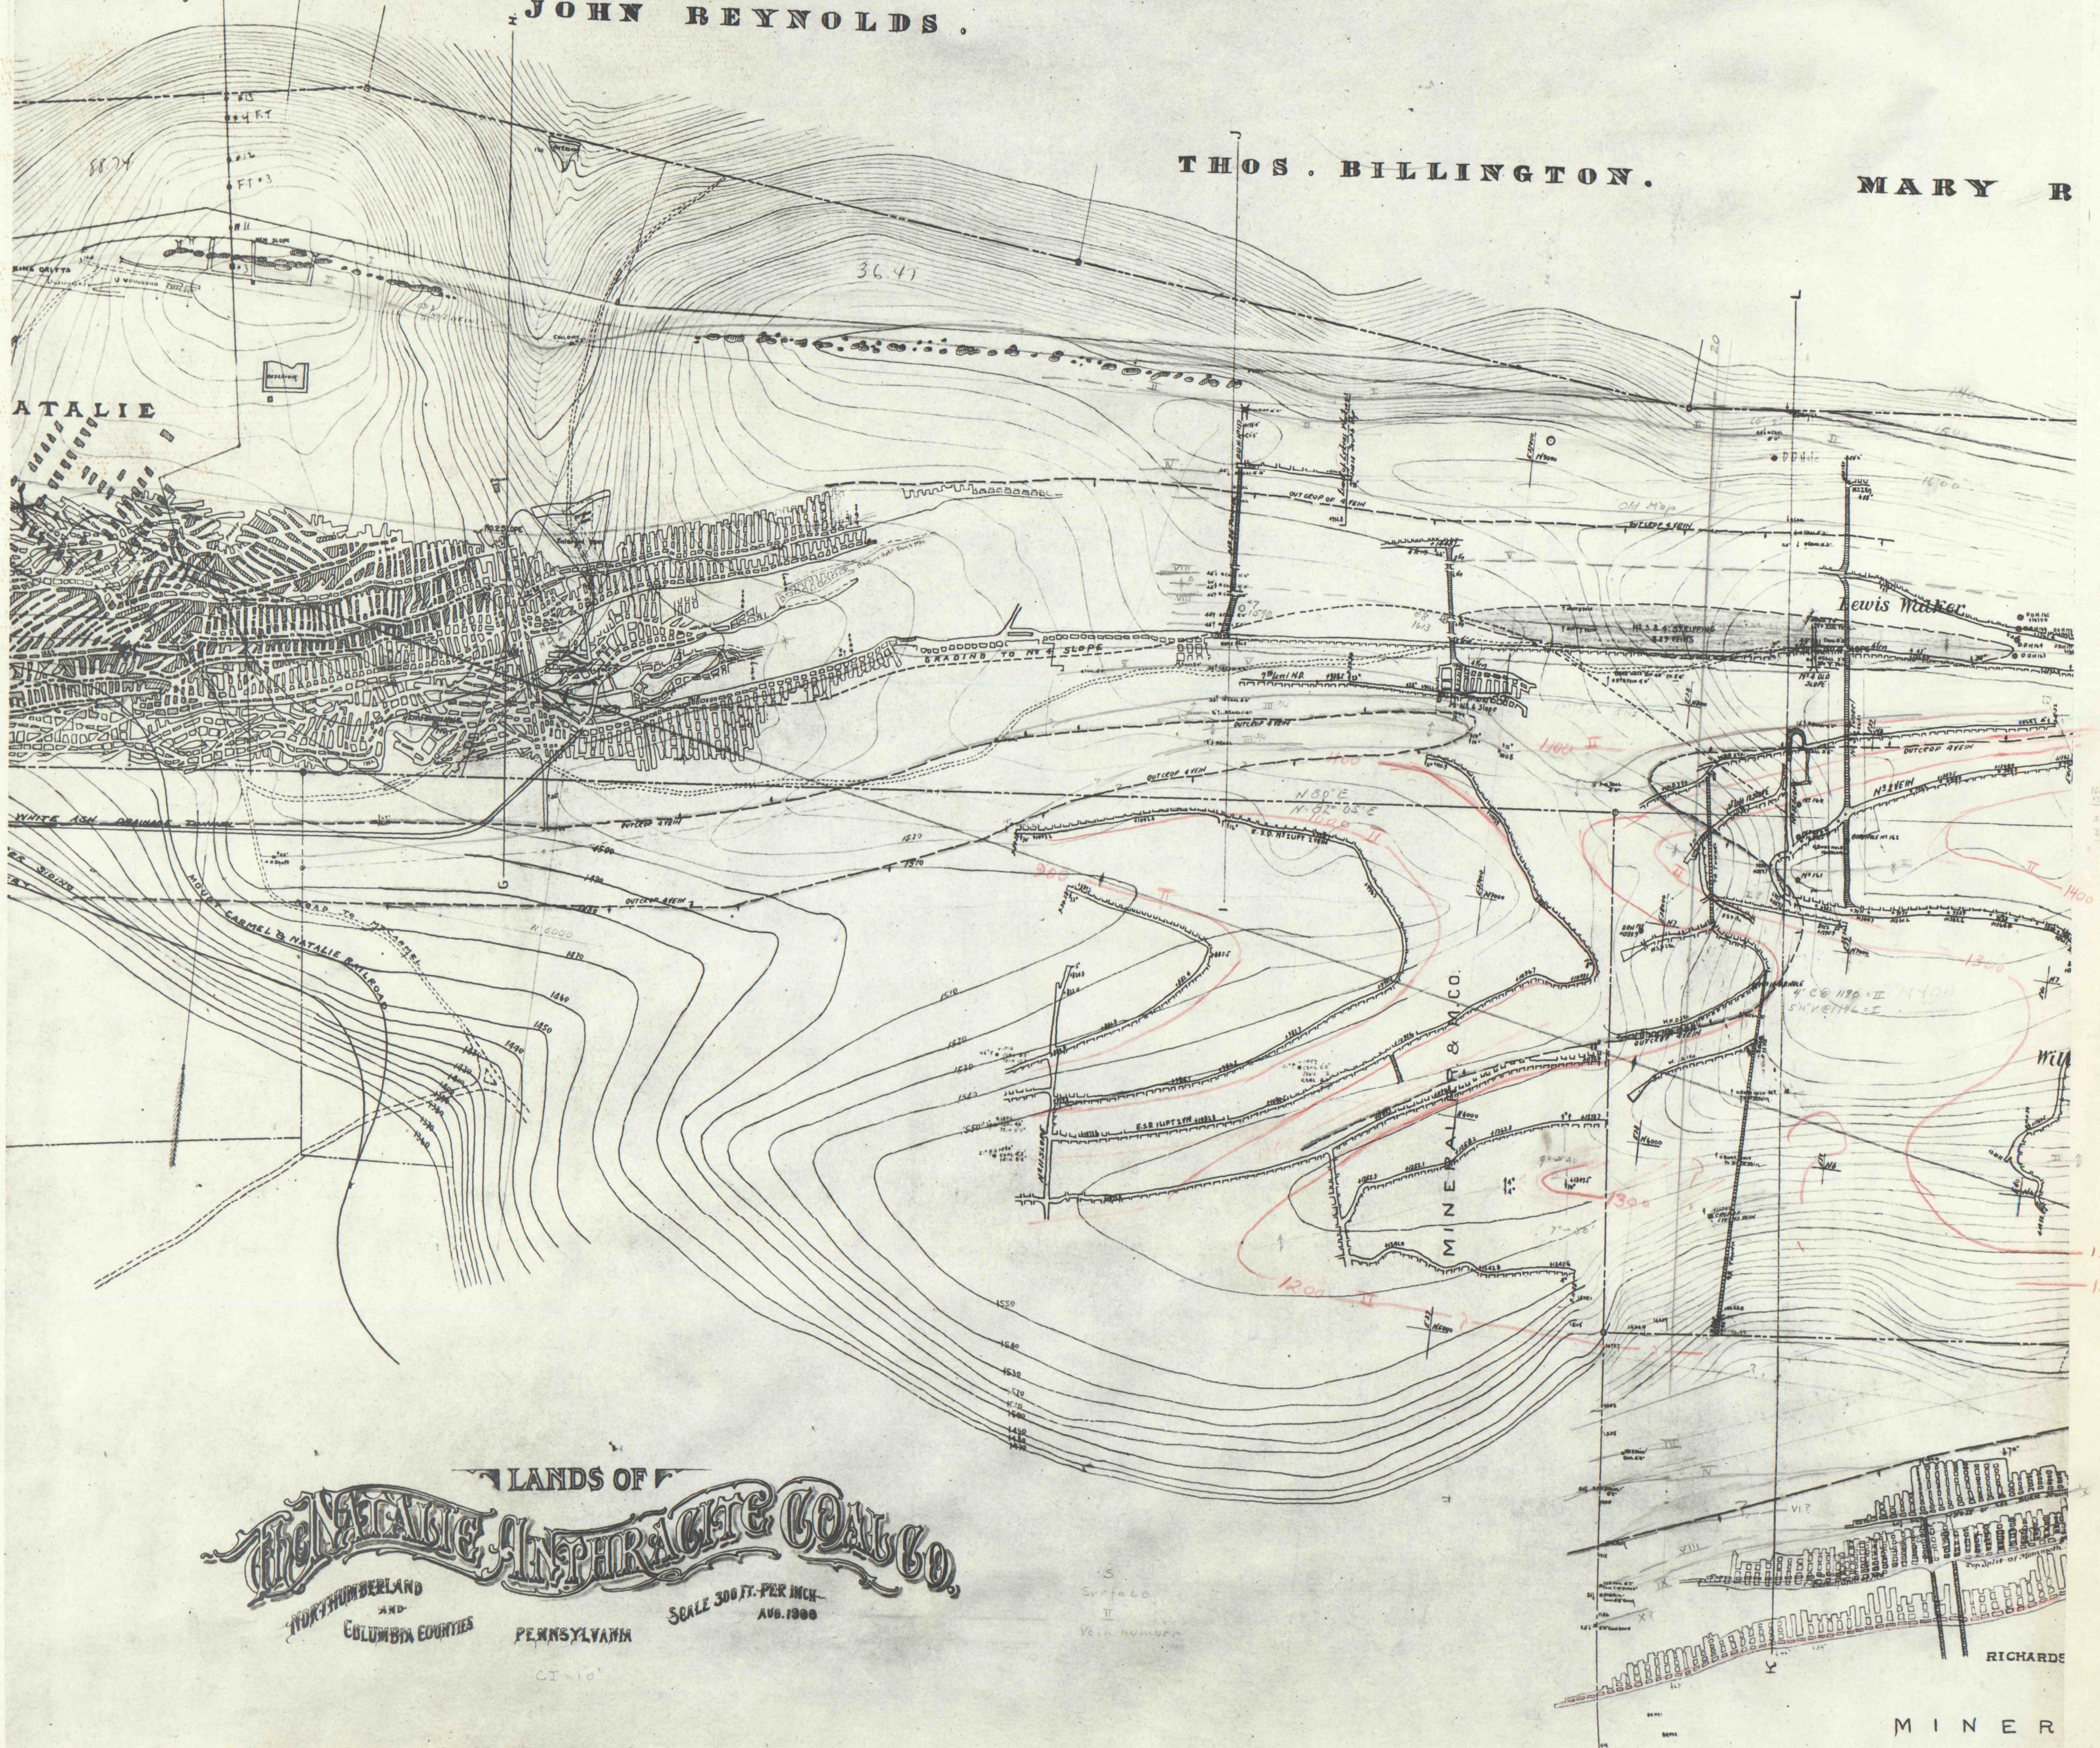

LANDS OF
NORTHUMBERLAND AND COLUMBIA COUNTIES PENNSYLVANIA
SCALE 300 FT. PER INCH
AUG. 1900

MINER