


YOUNG

JOSHUA BEAN

SAM'L LOBDELL

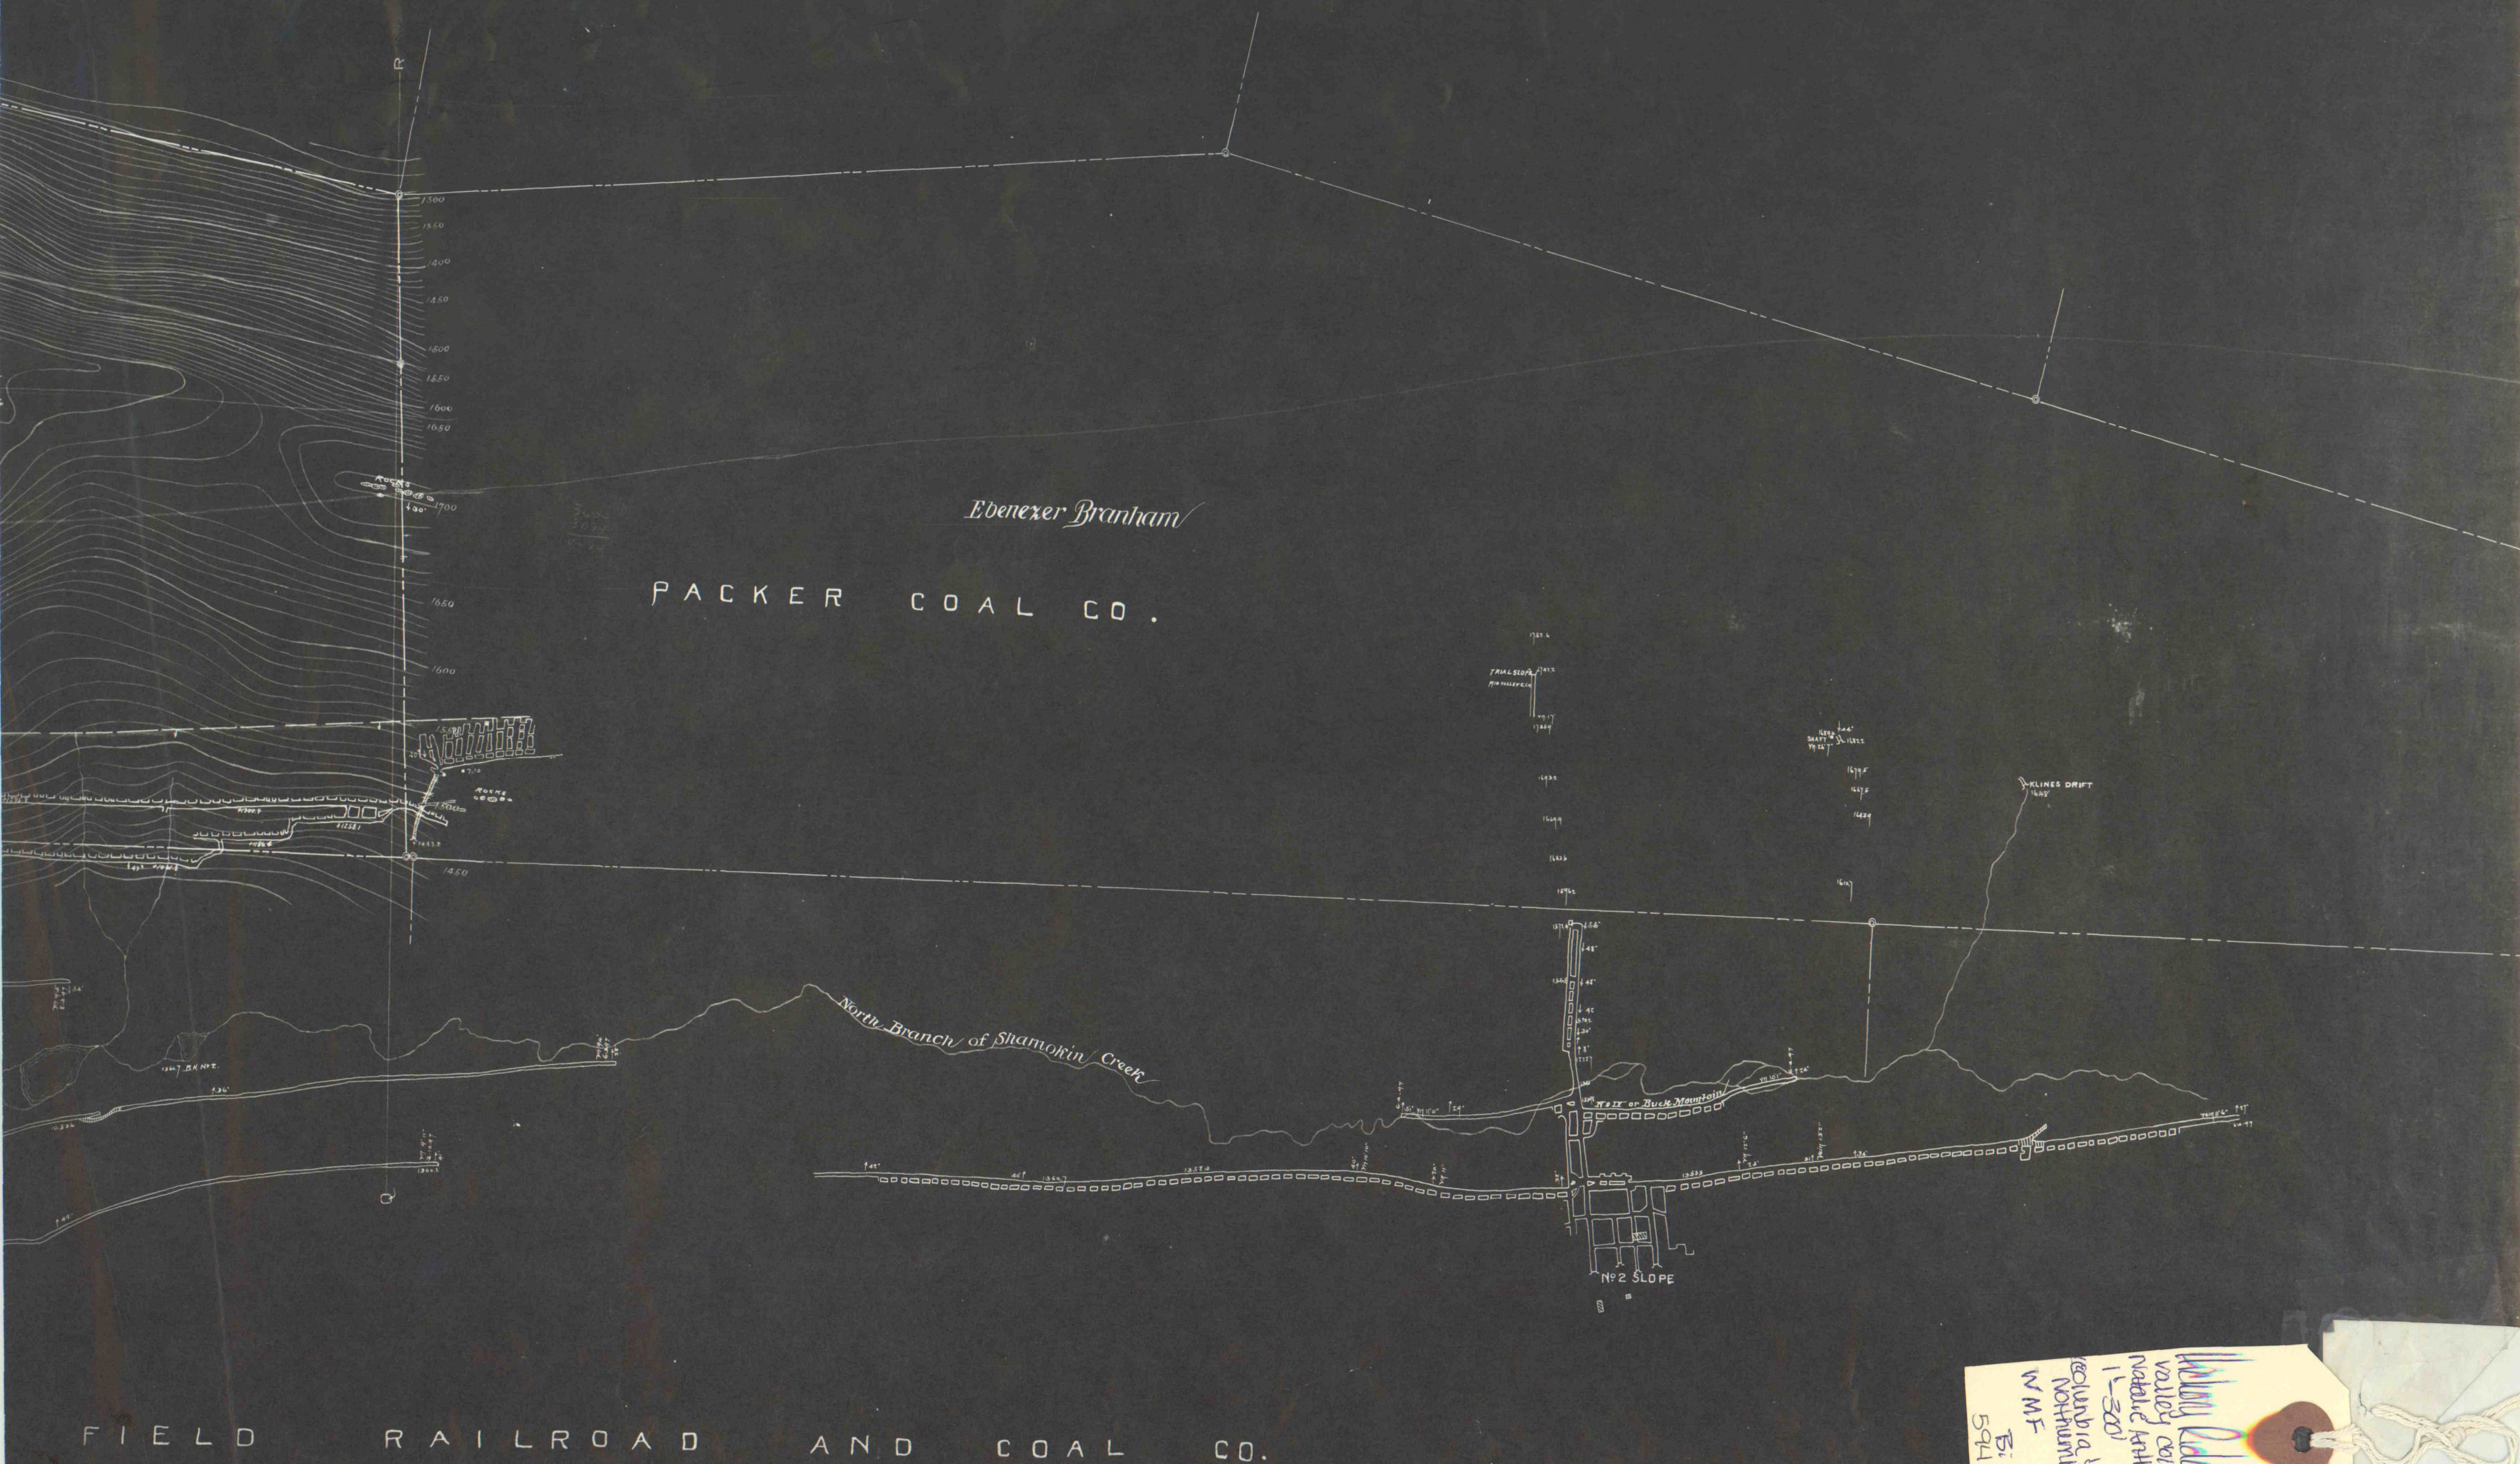

Handwritten notes on a tag:
Ebenezer Brantham
Packer Coal Co.
Field Railroad and Coal Co.
No 2 Slope
No 1 Slope
No 3 Slope
No 4 Slope
