


DANIEL REESE. CHARLOTTE RUSTON. MARY MYERS.

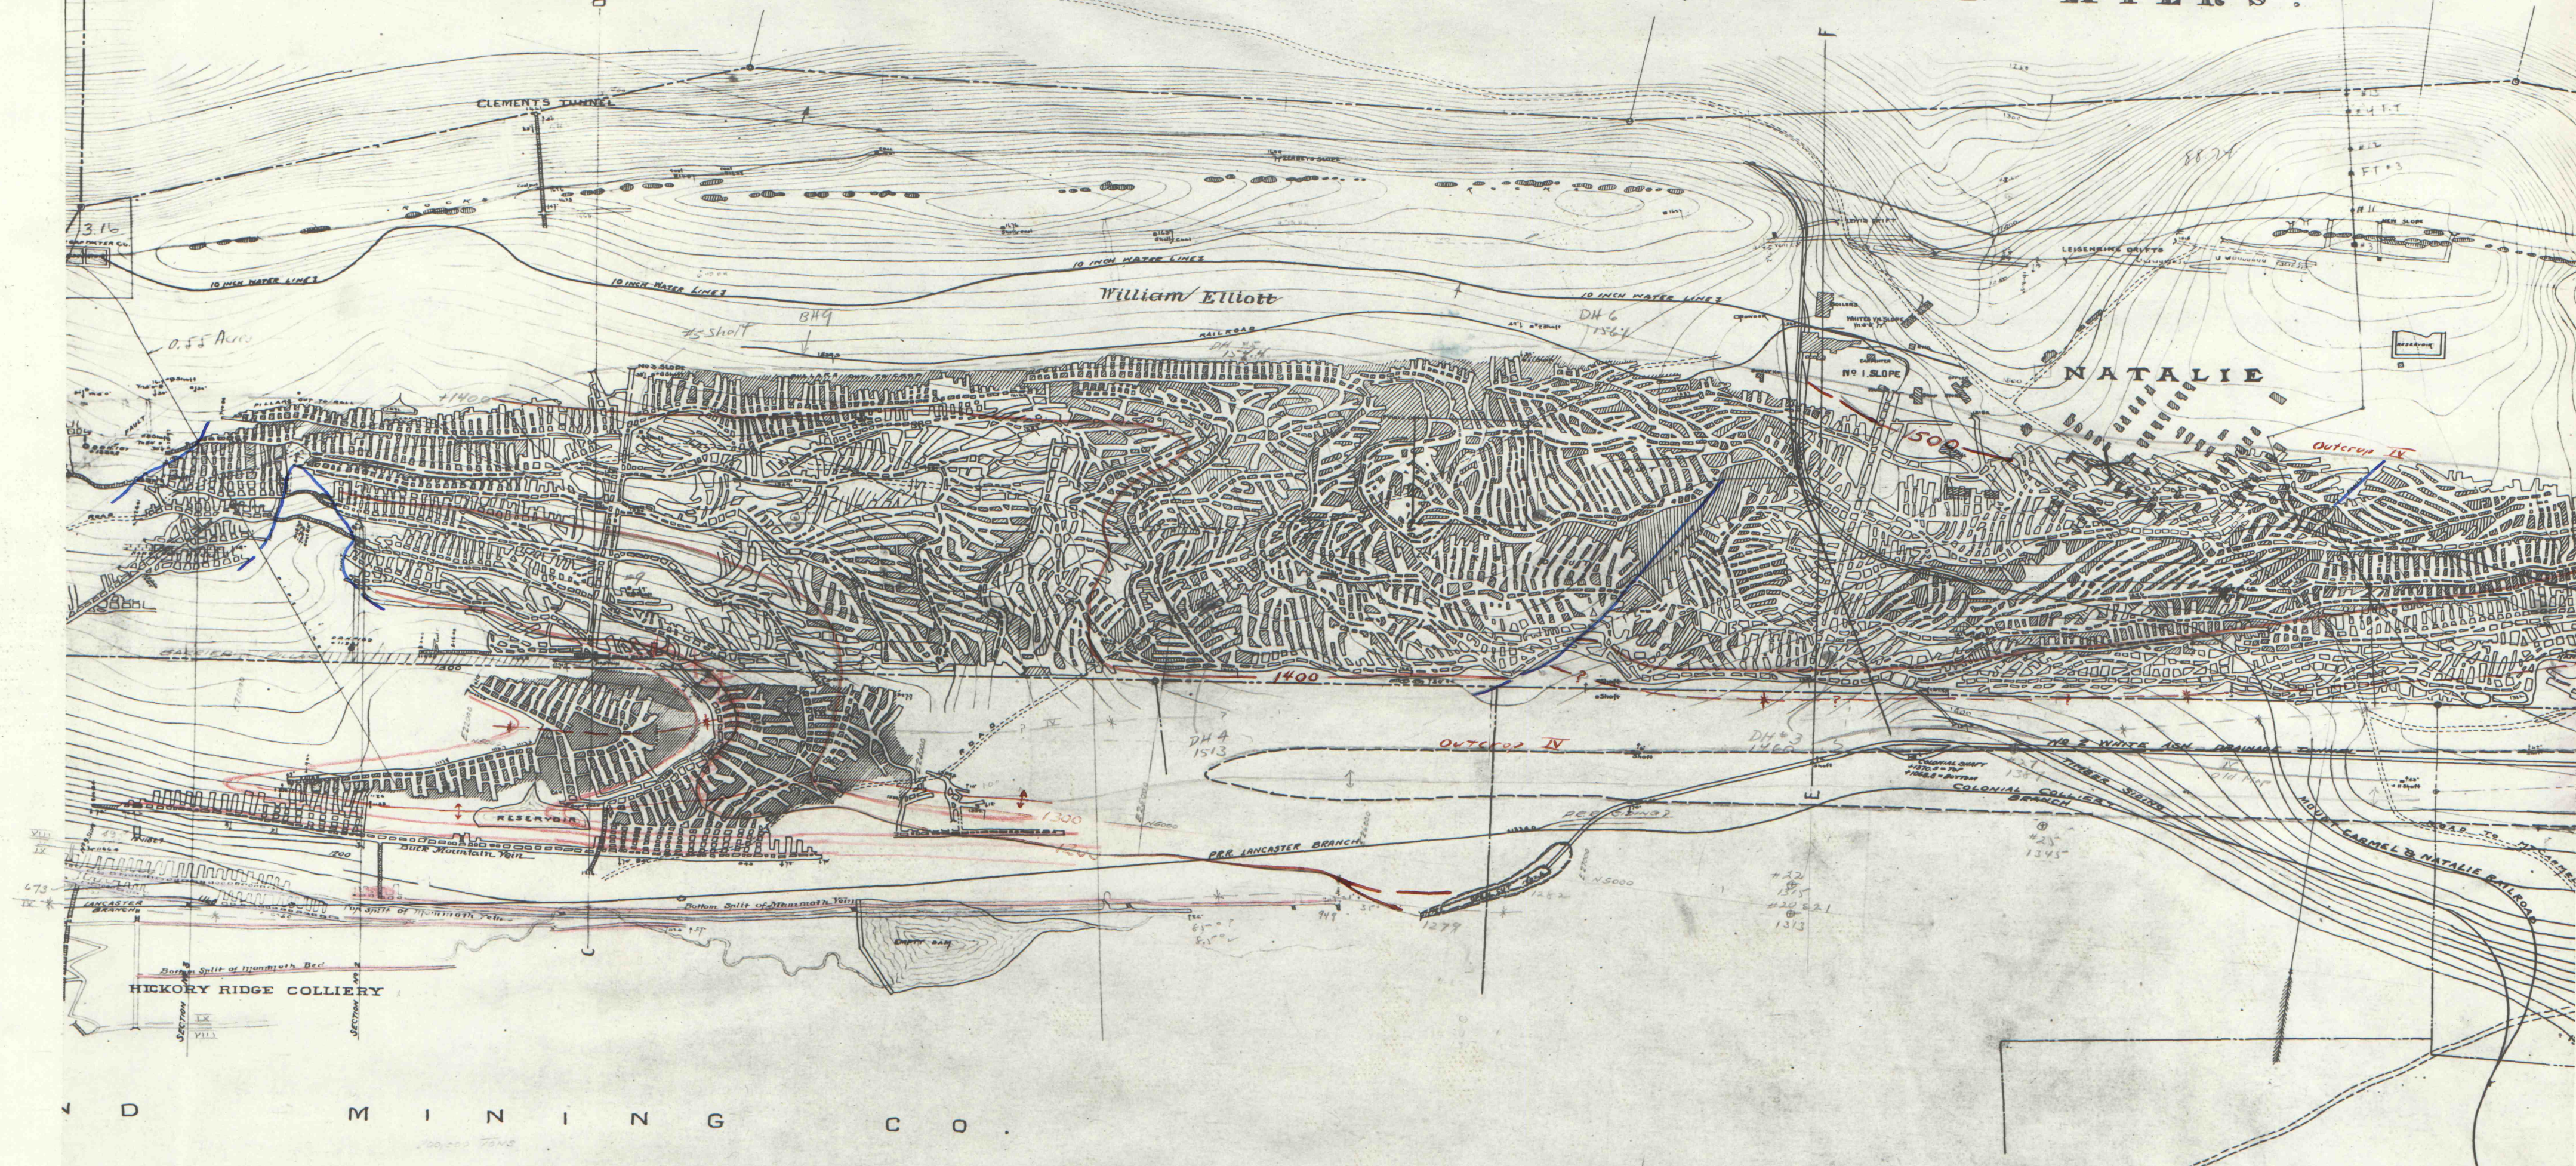

Contours on IV Vein
Faults

