


THOS. RUSTON

MARY RUSTON JR.

JOHN YOUNG

JOSH

PACKE

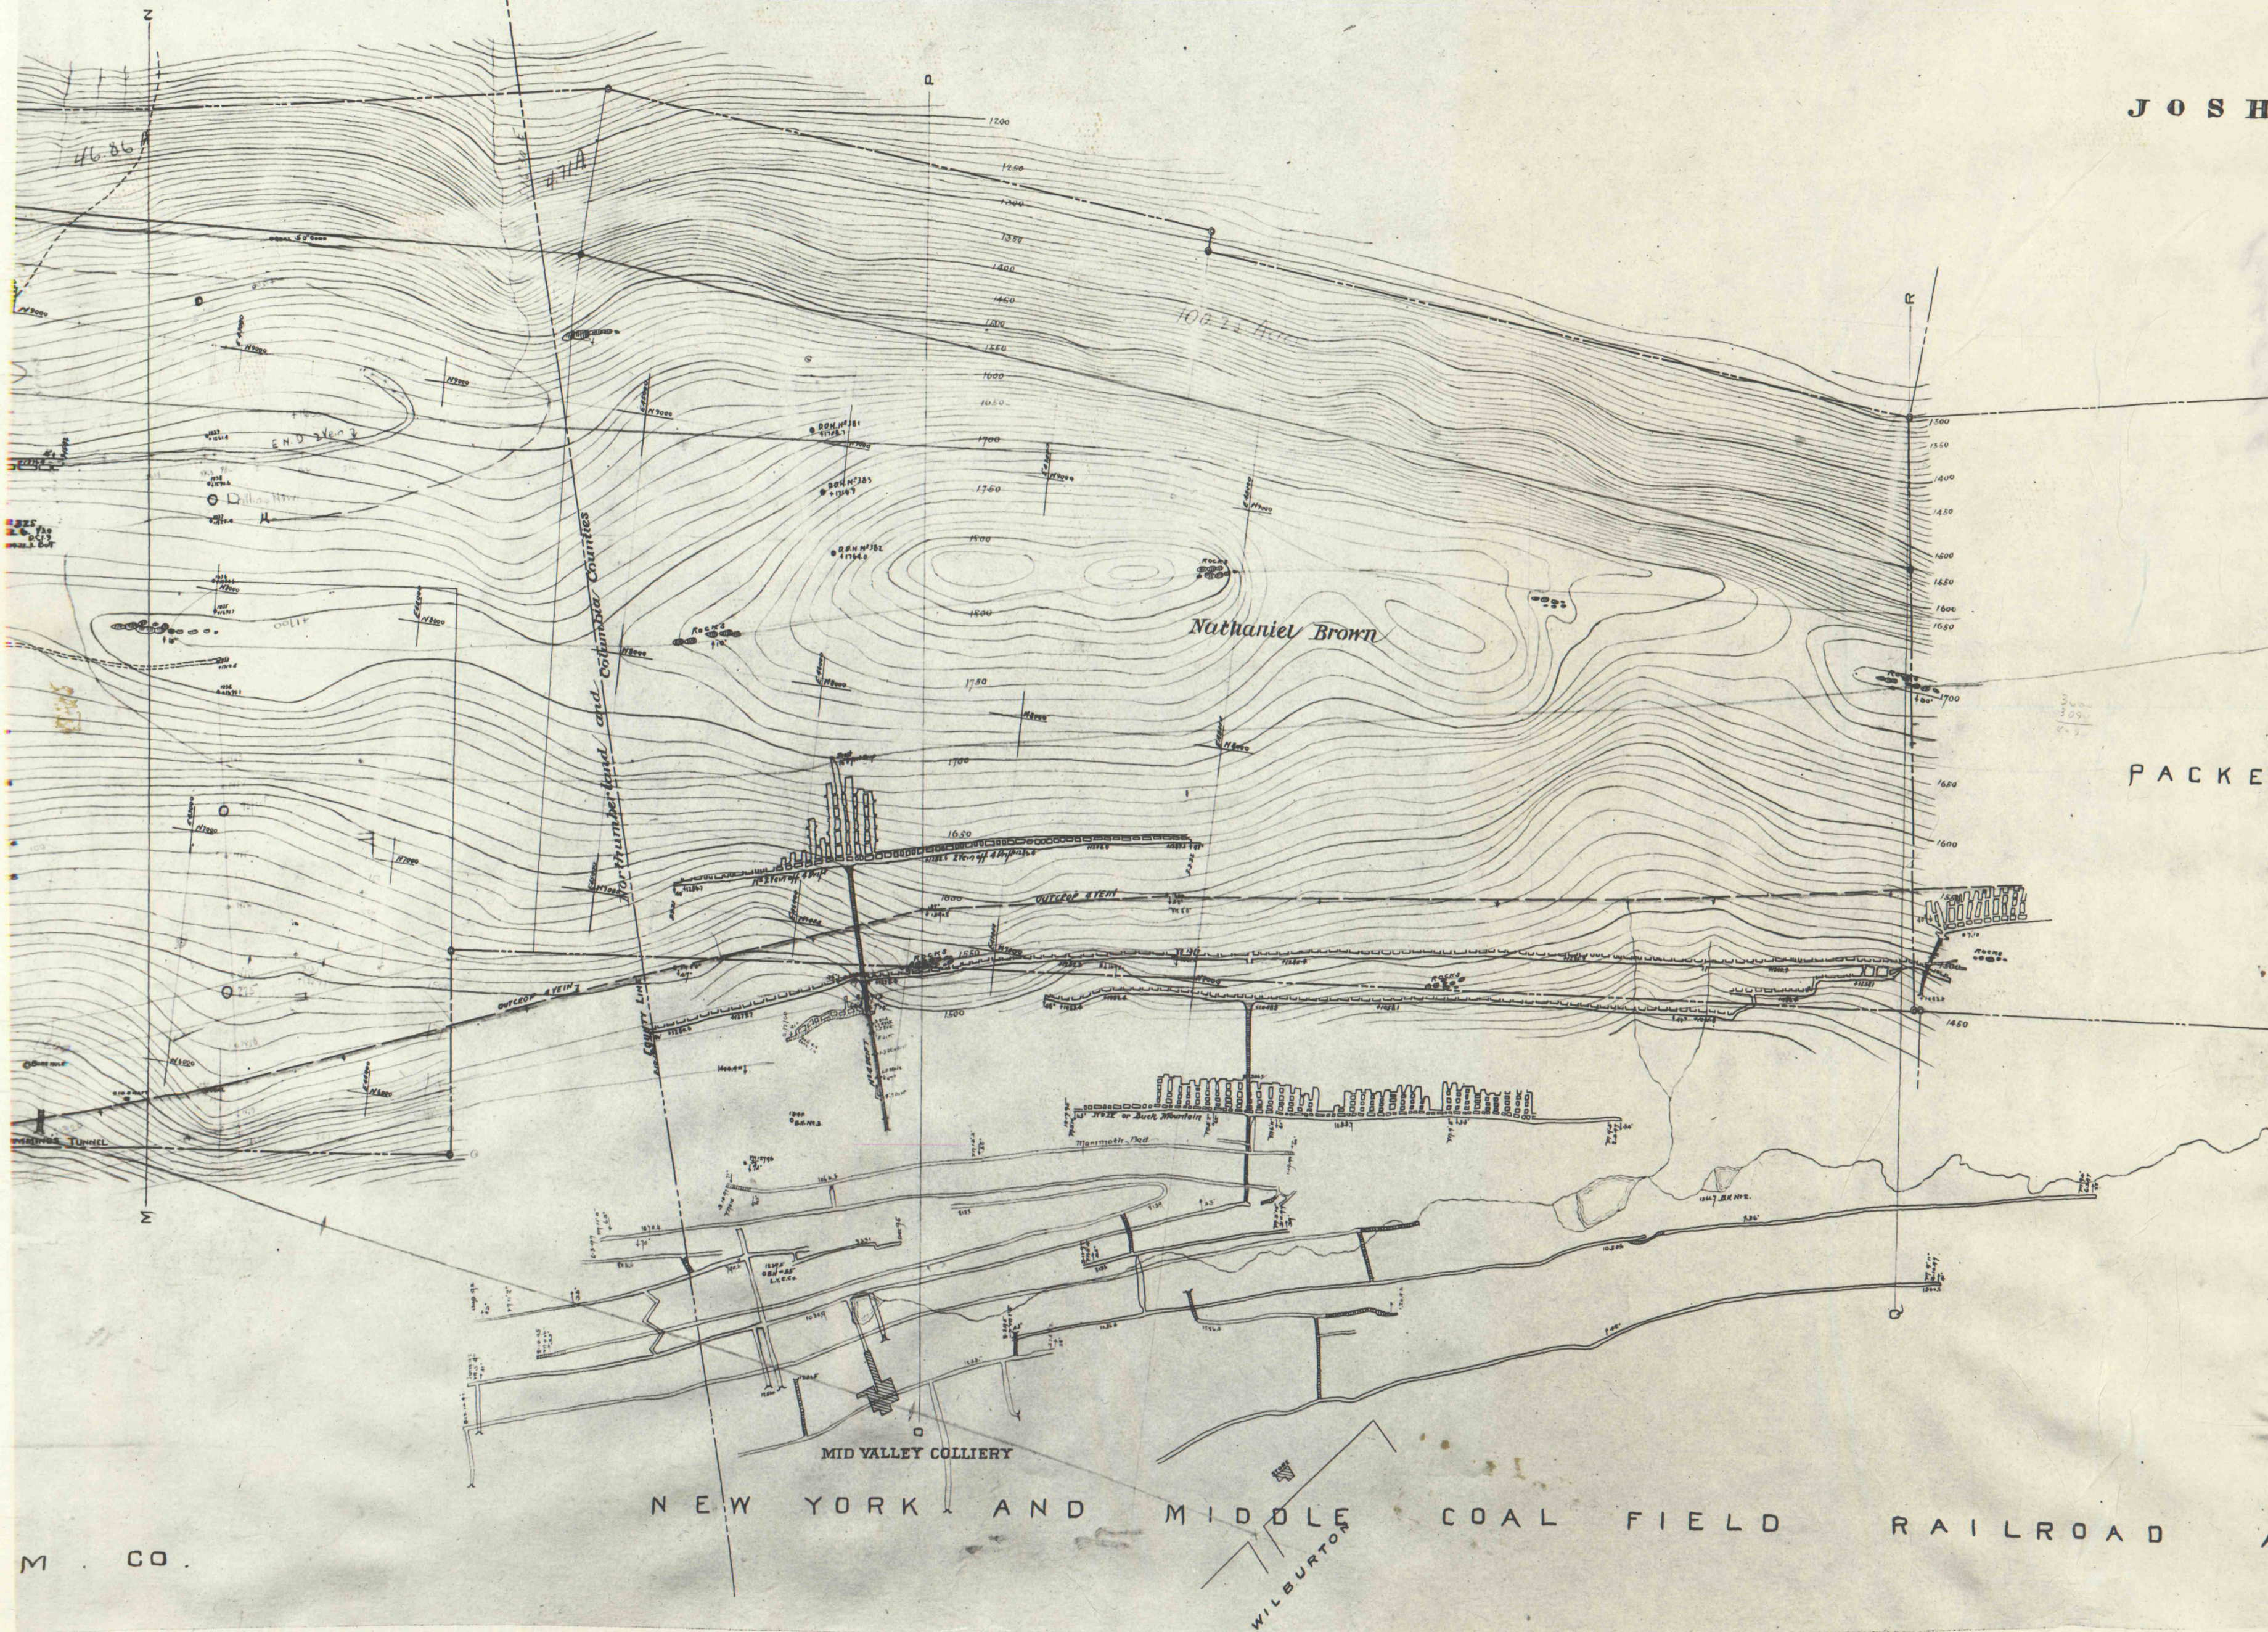

M. CO.