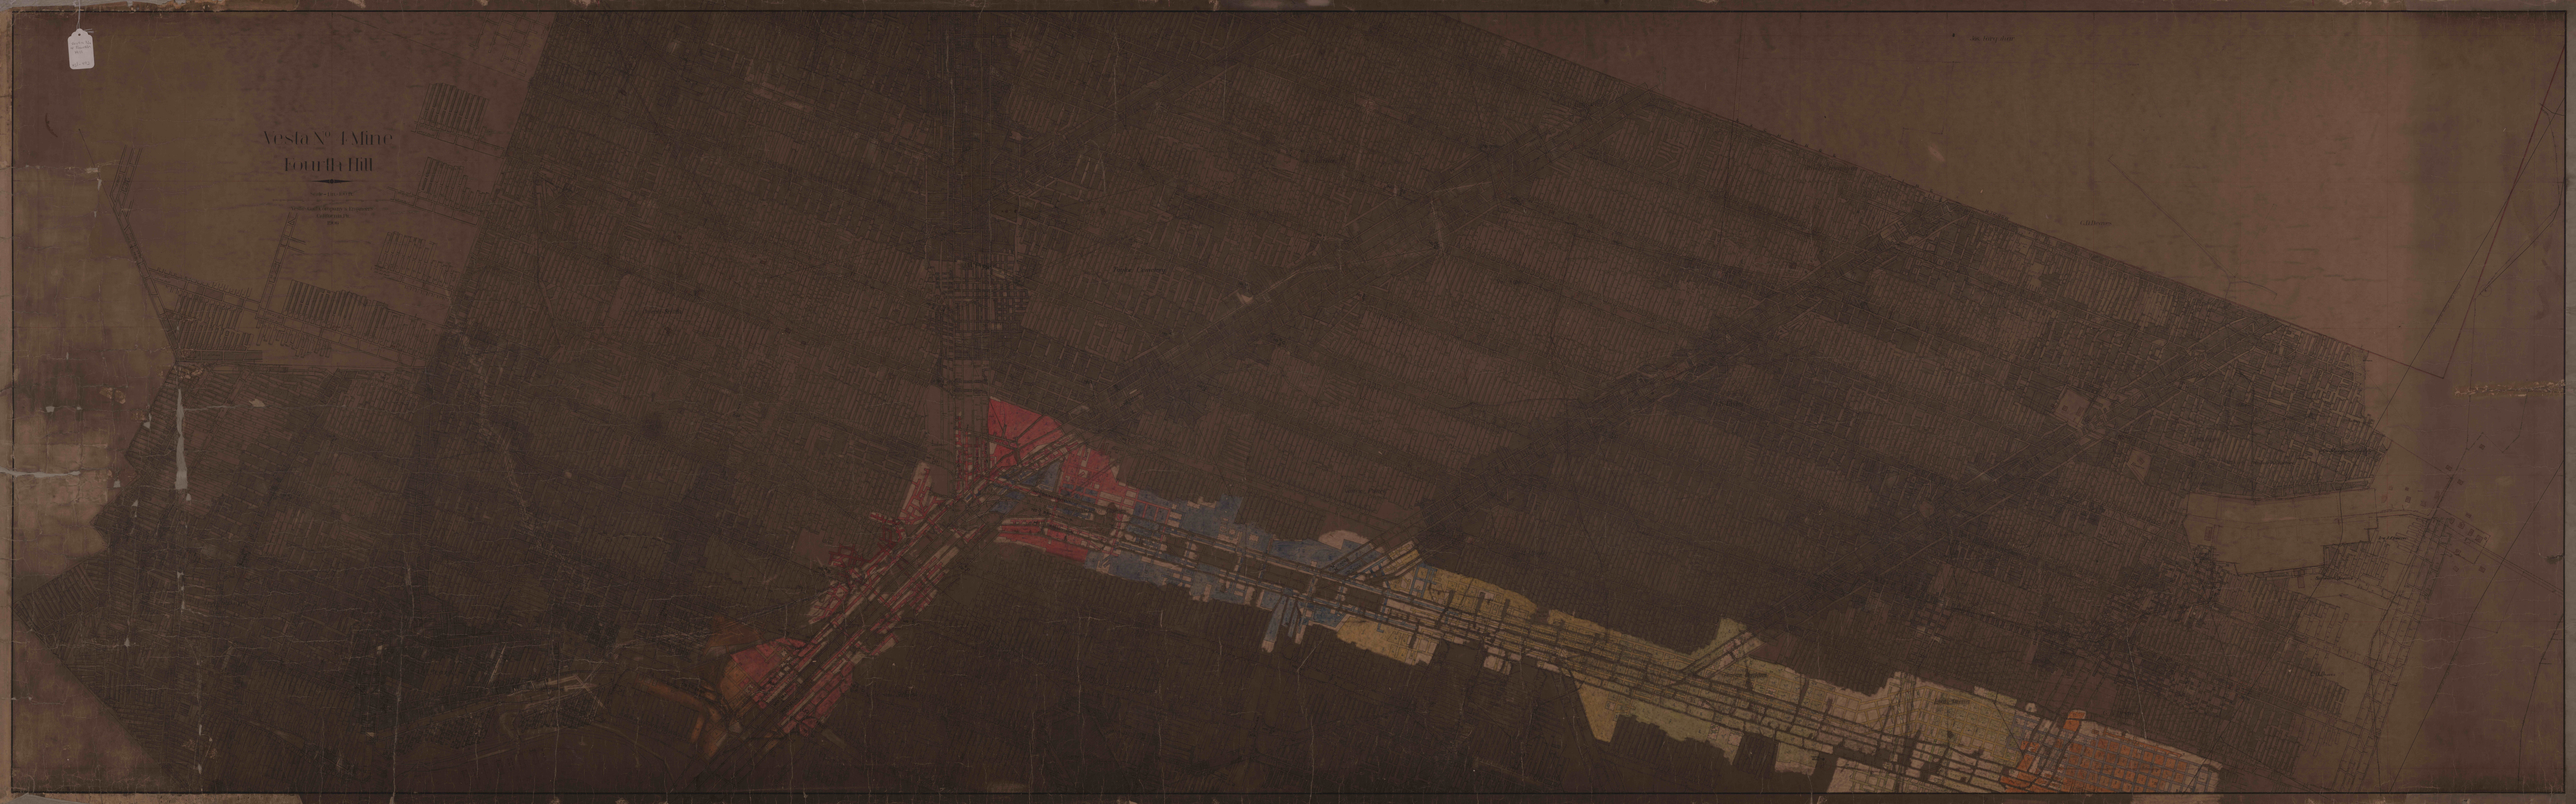
Vesta No. 1 Mine
Fourth Hill