


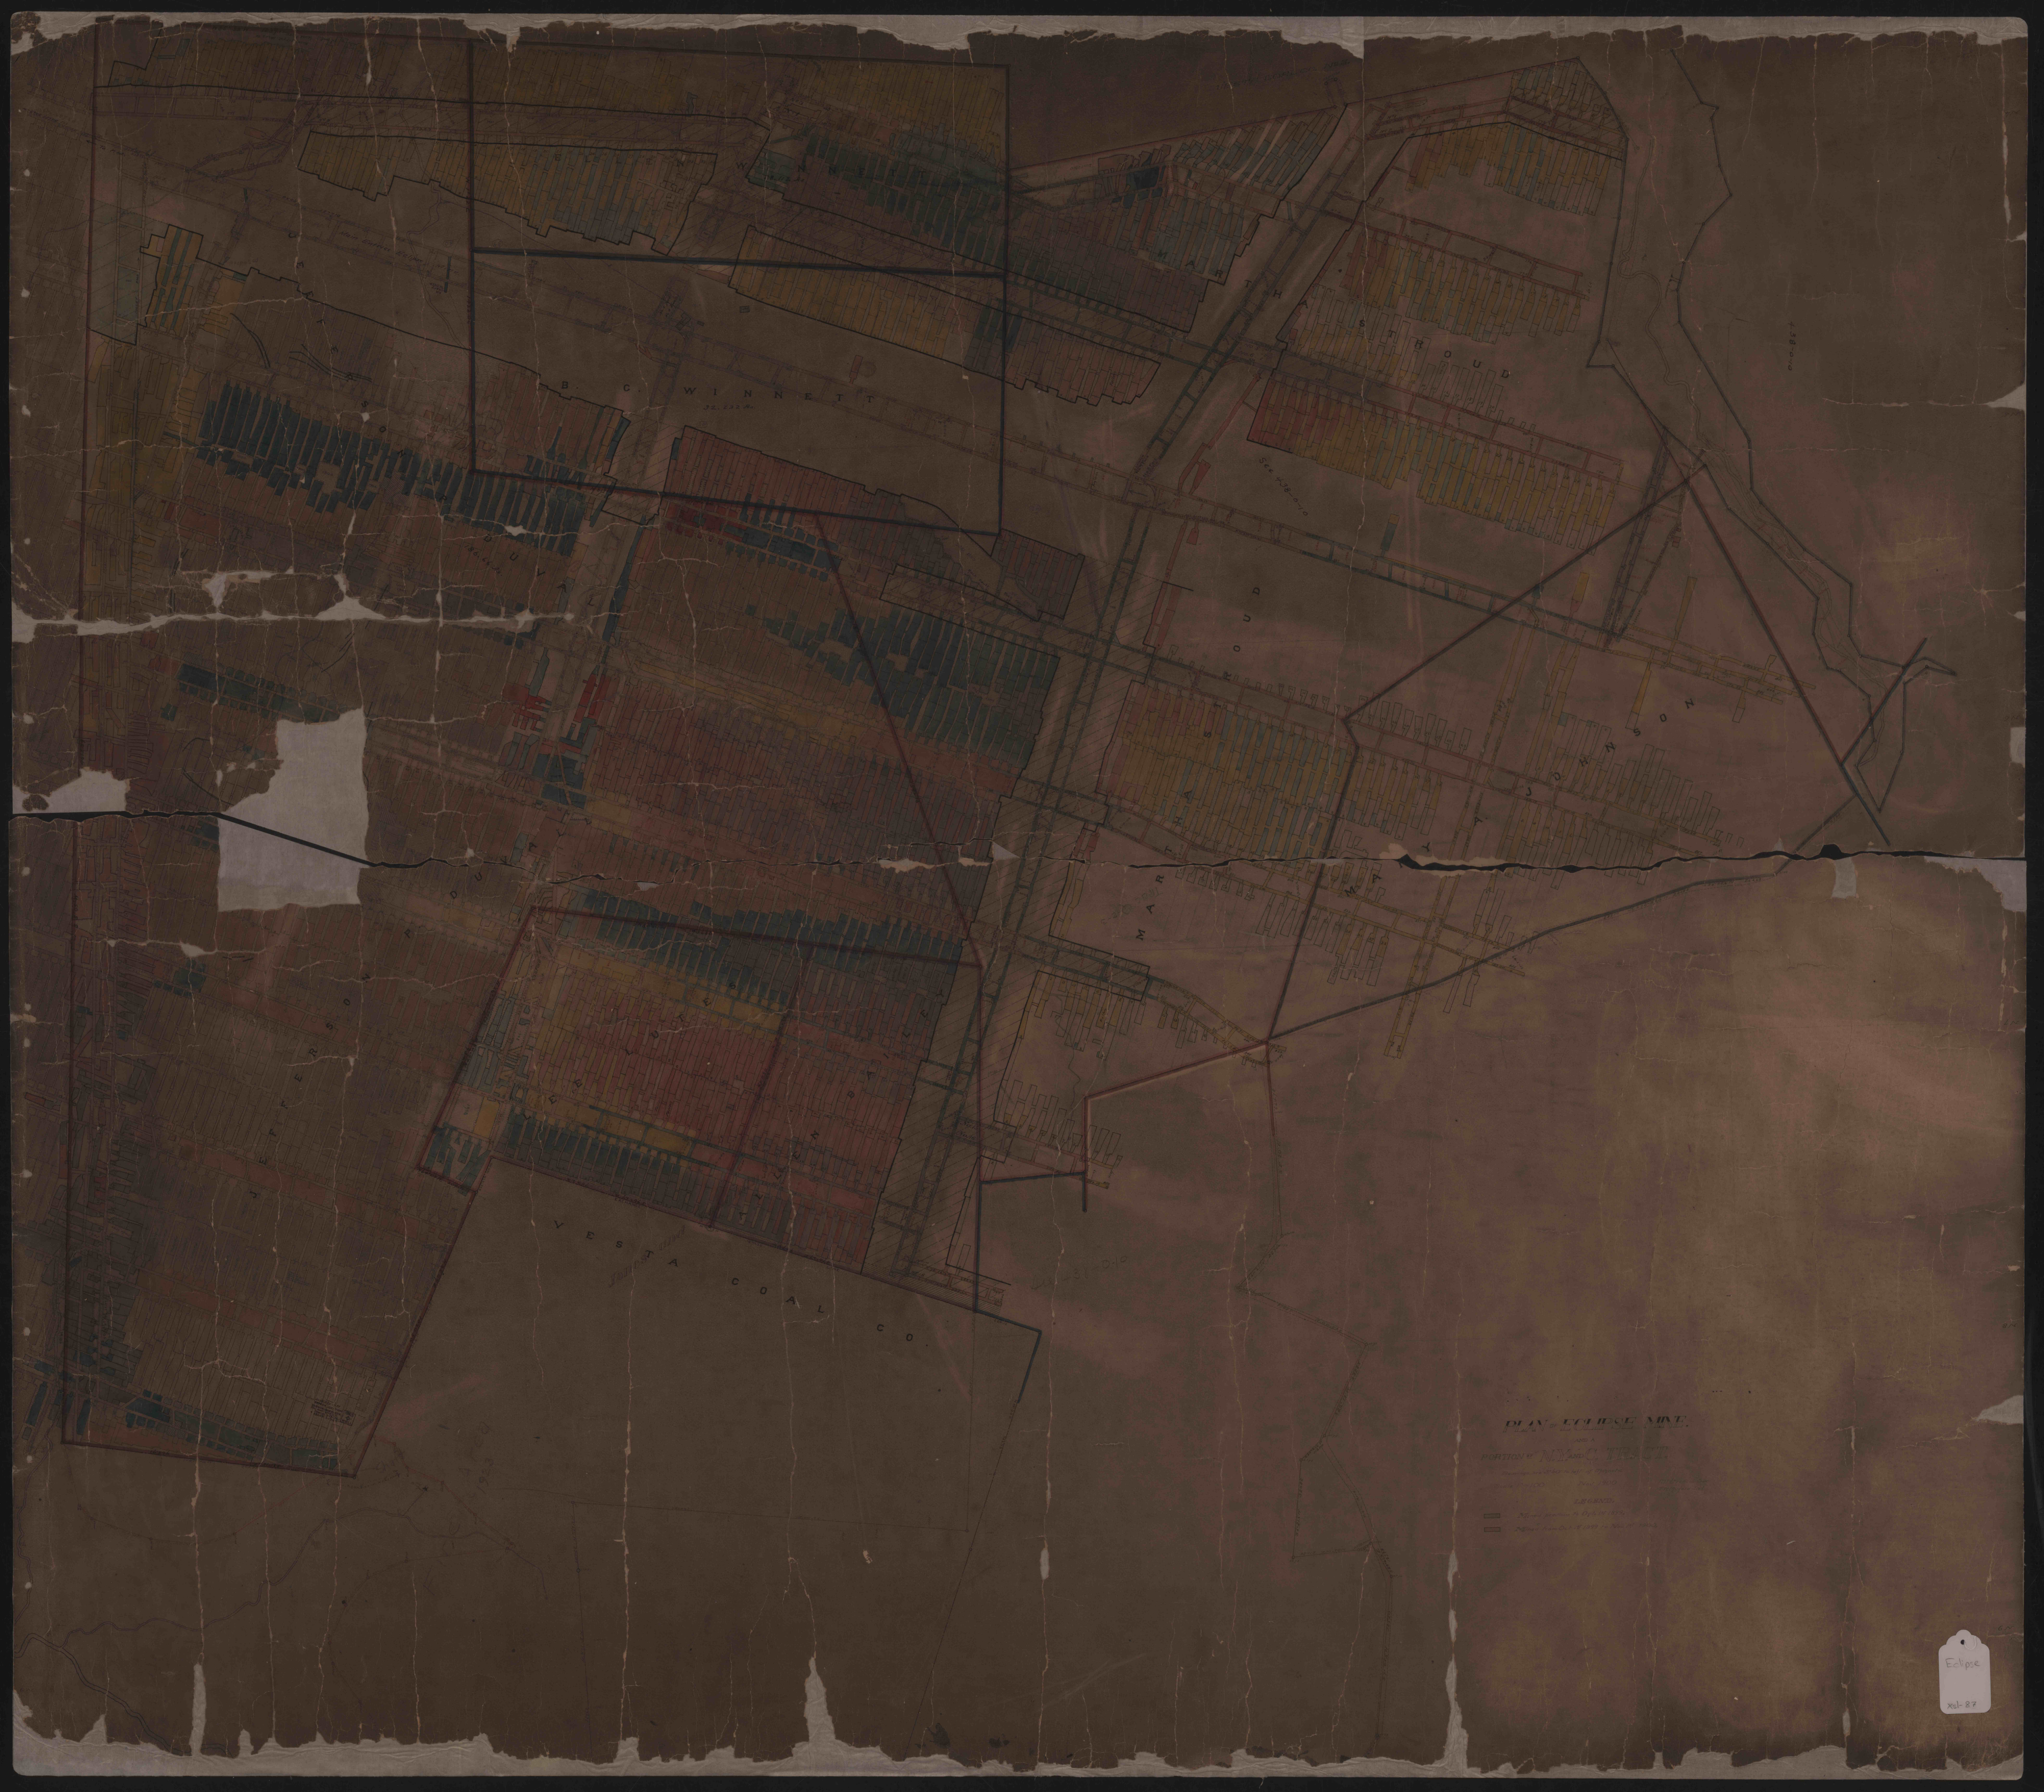

PORTION OF N. M. & C. TR. CO.
