


NO. 8

WANAMIE SURFACE

NO. 8

TRACING NO. 11

TRACING NO. 5

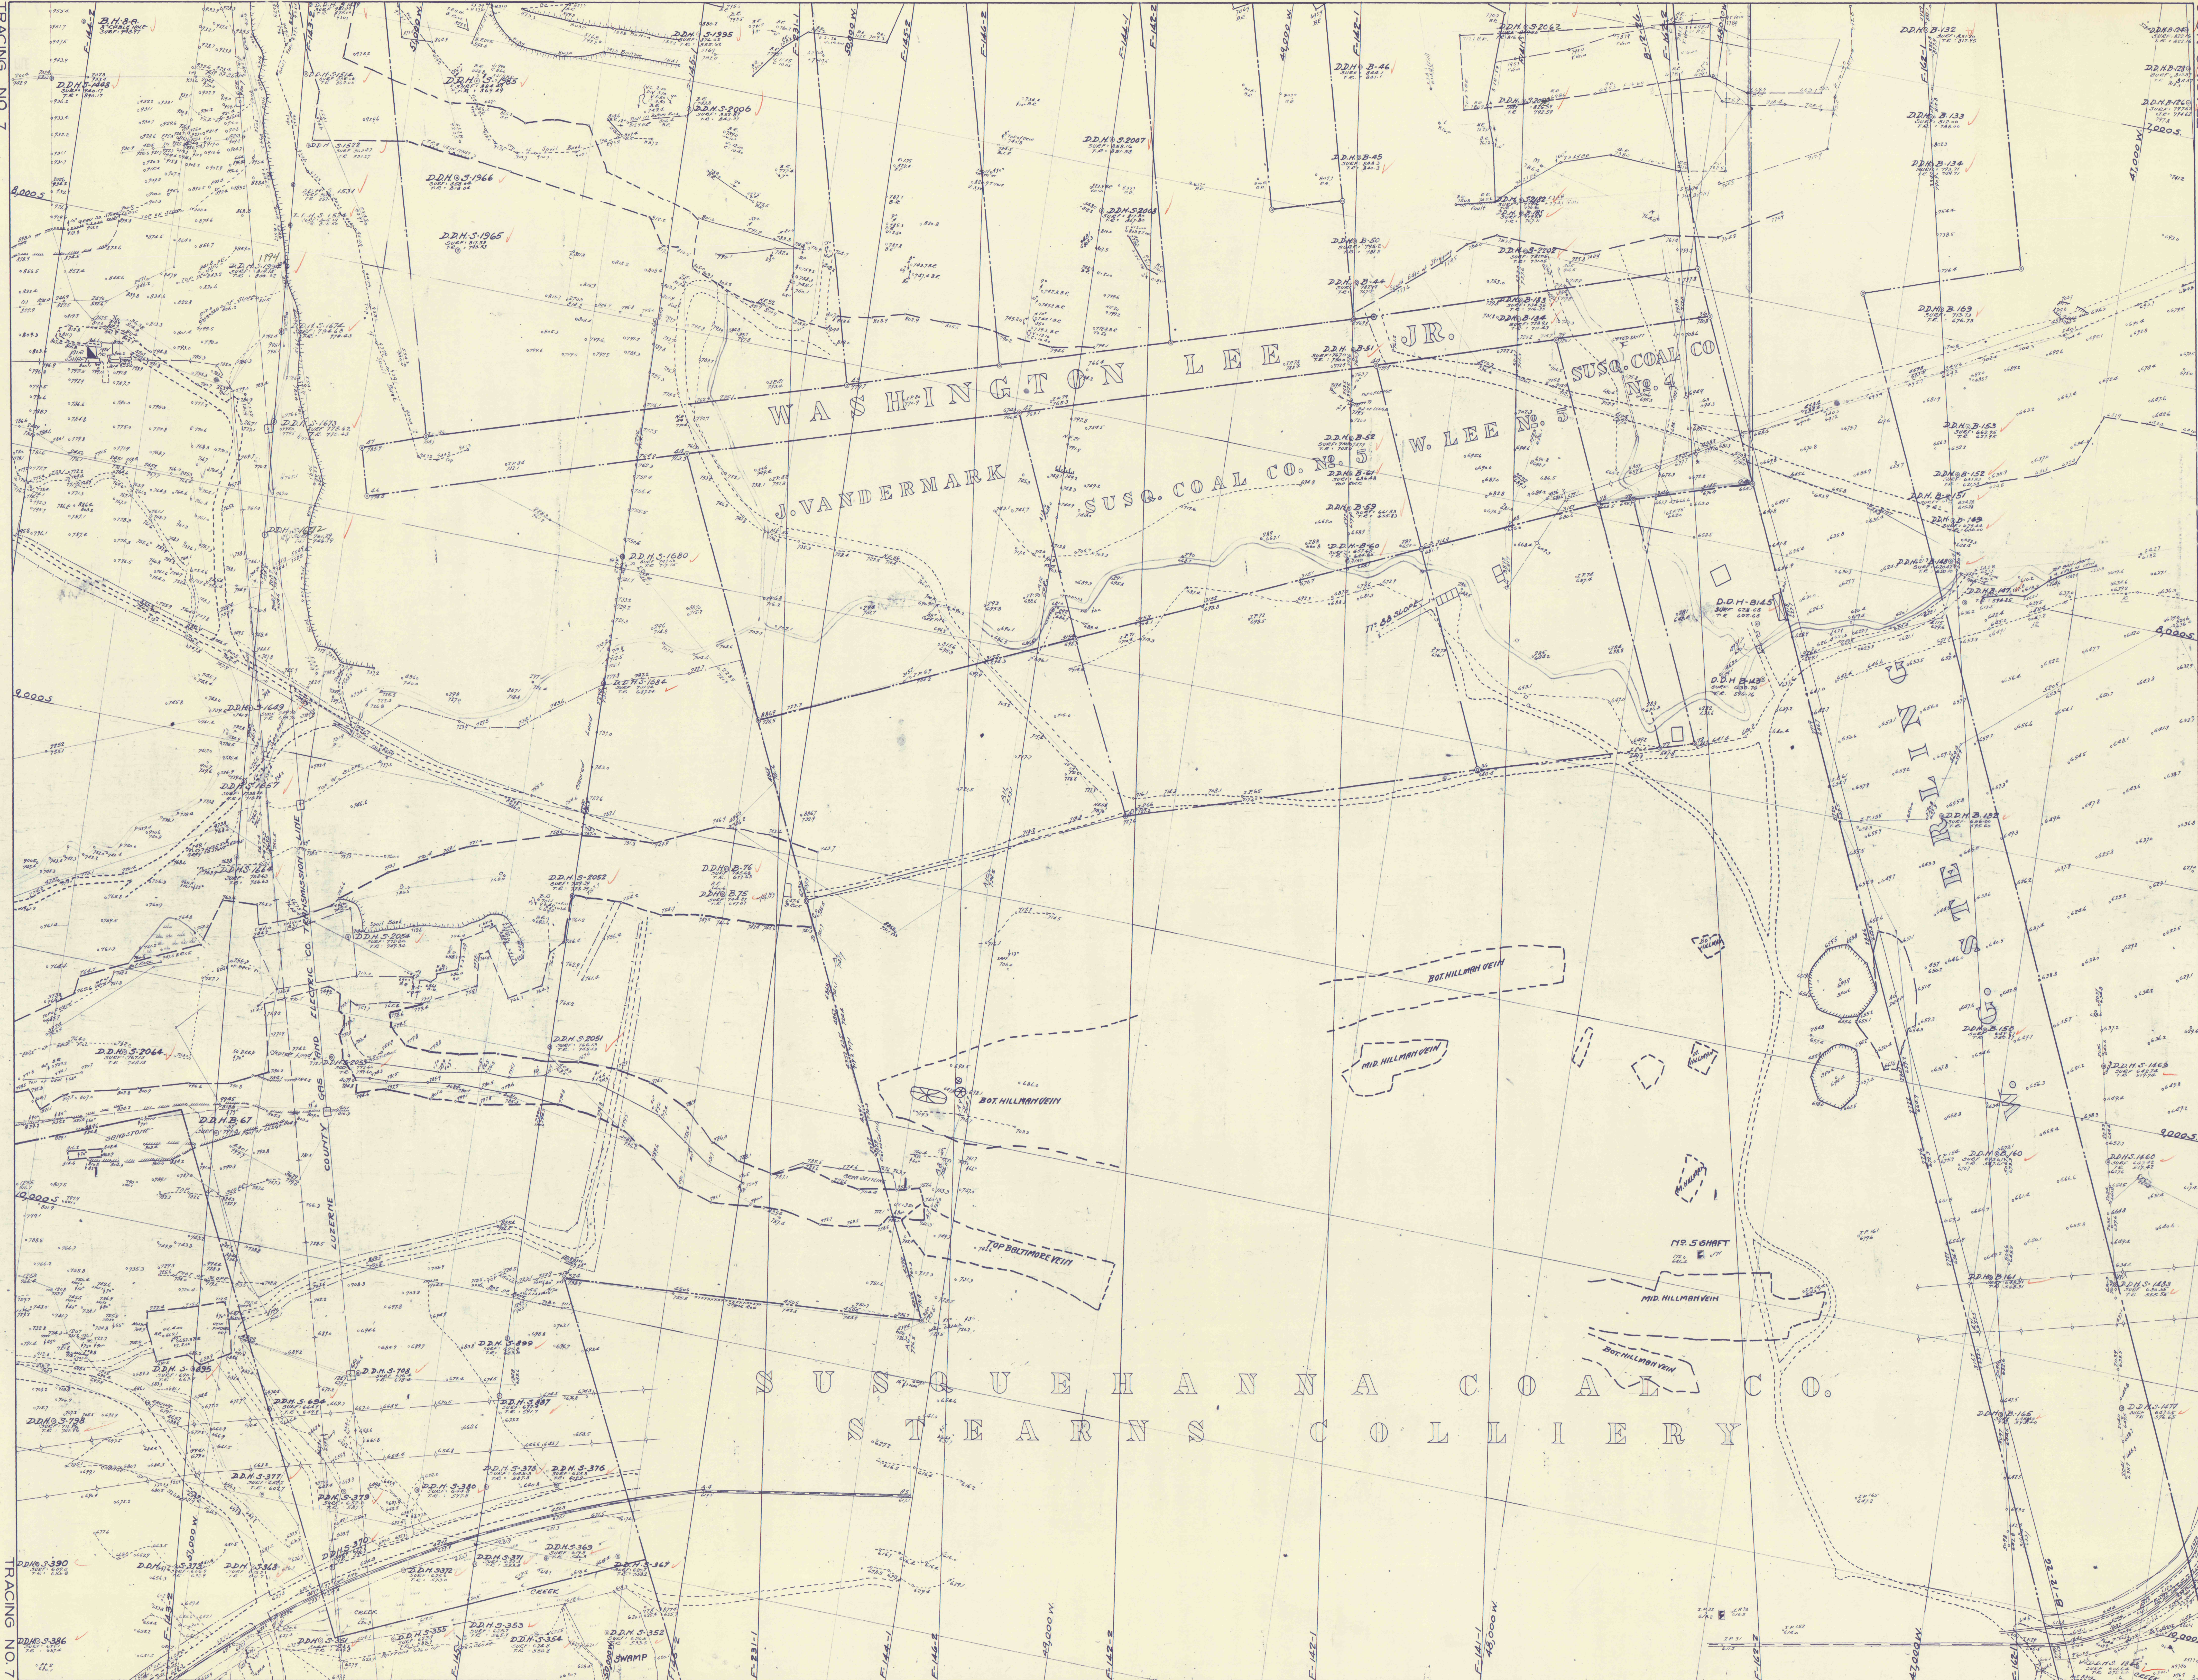

TRACING NO. 11

TRACING NO. 5

NO. 8

WANAMIE SURFACE

NO. 8