


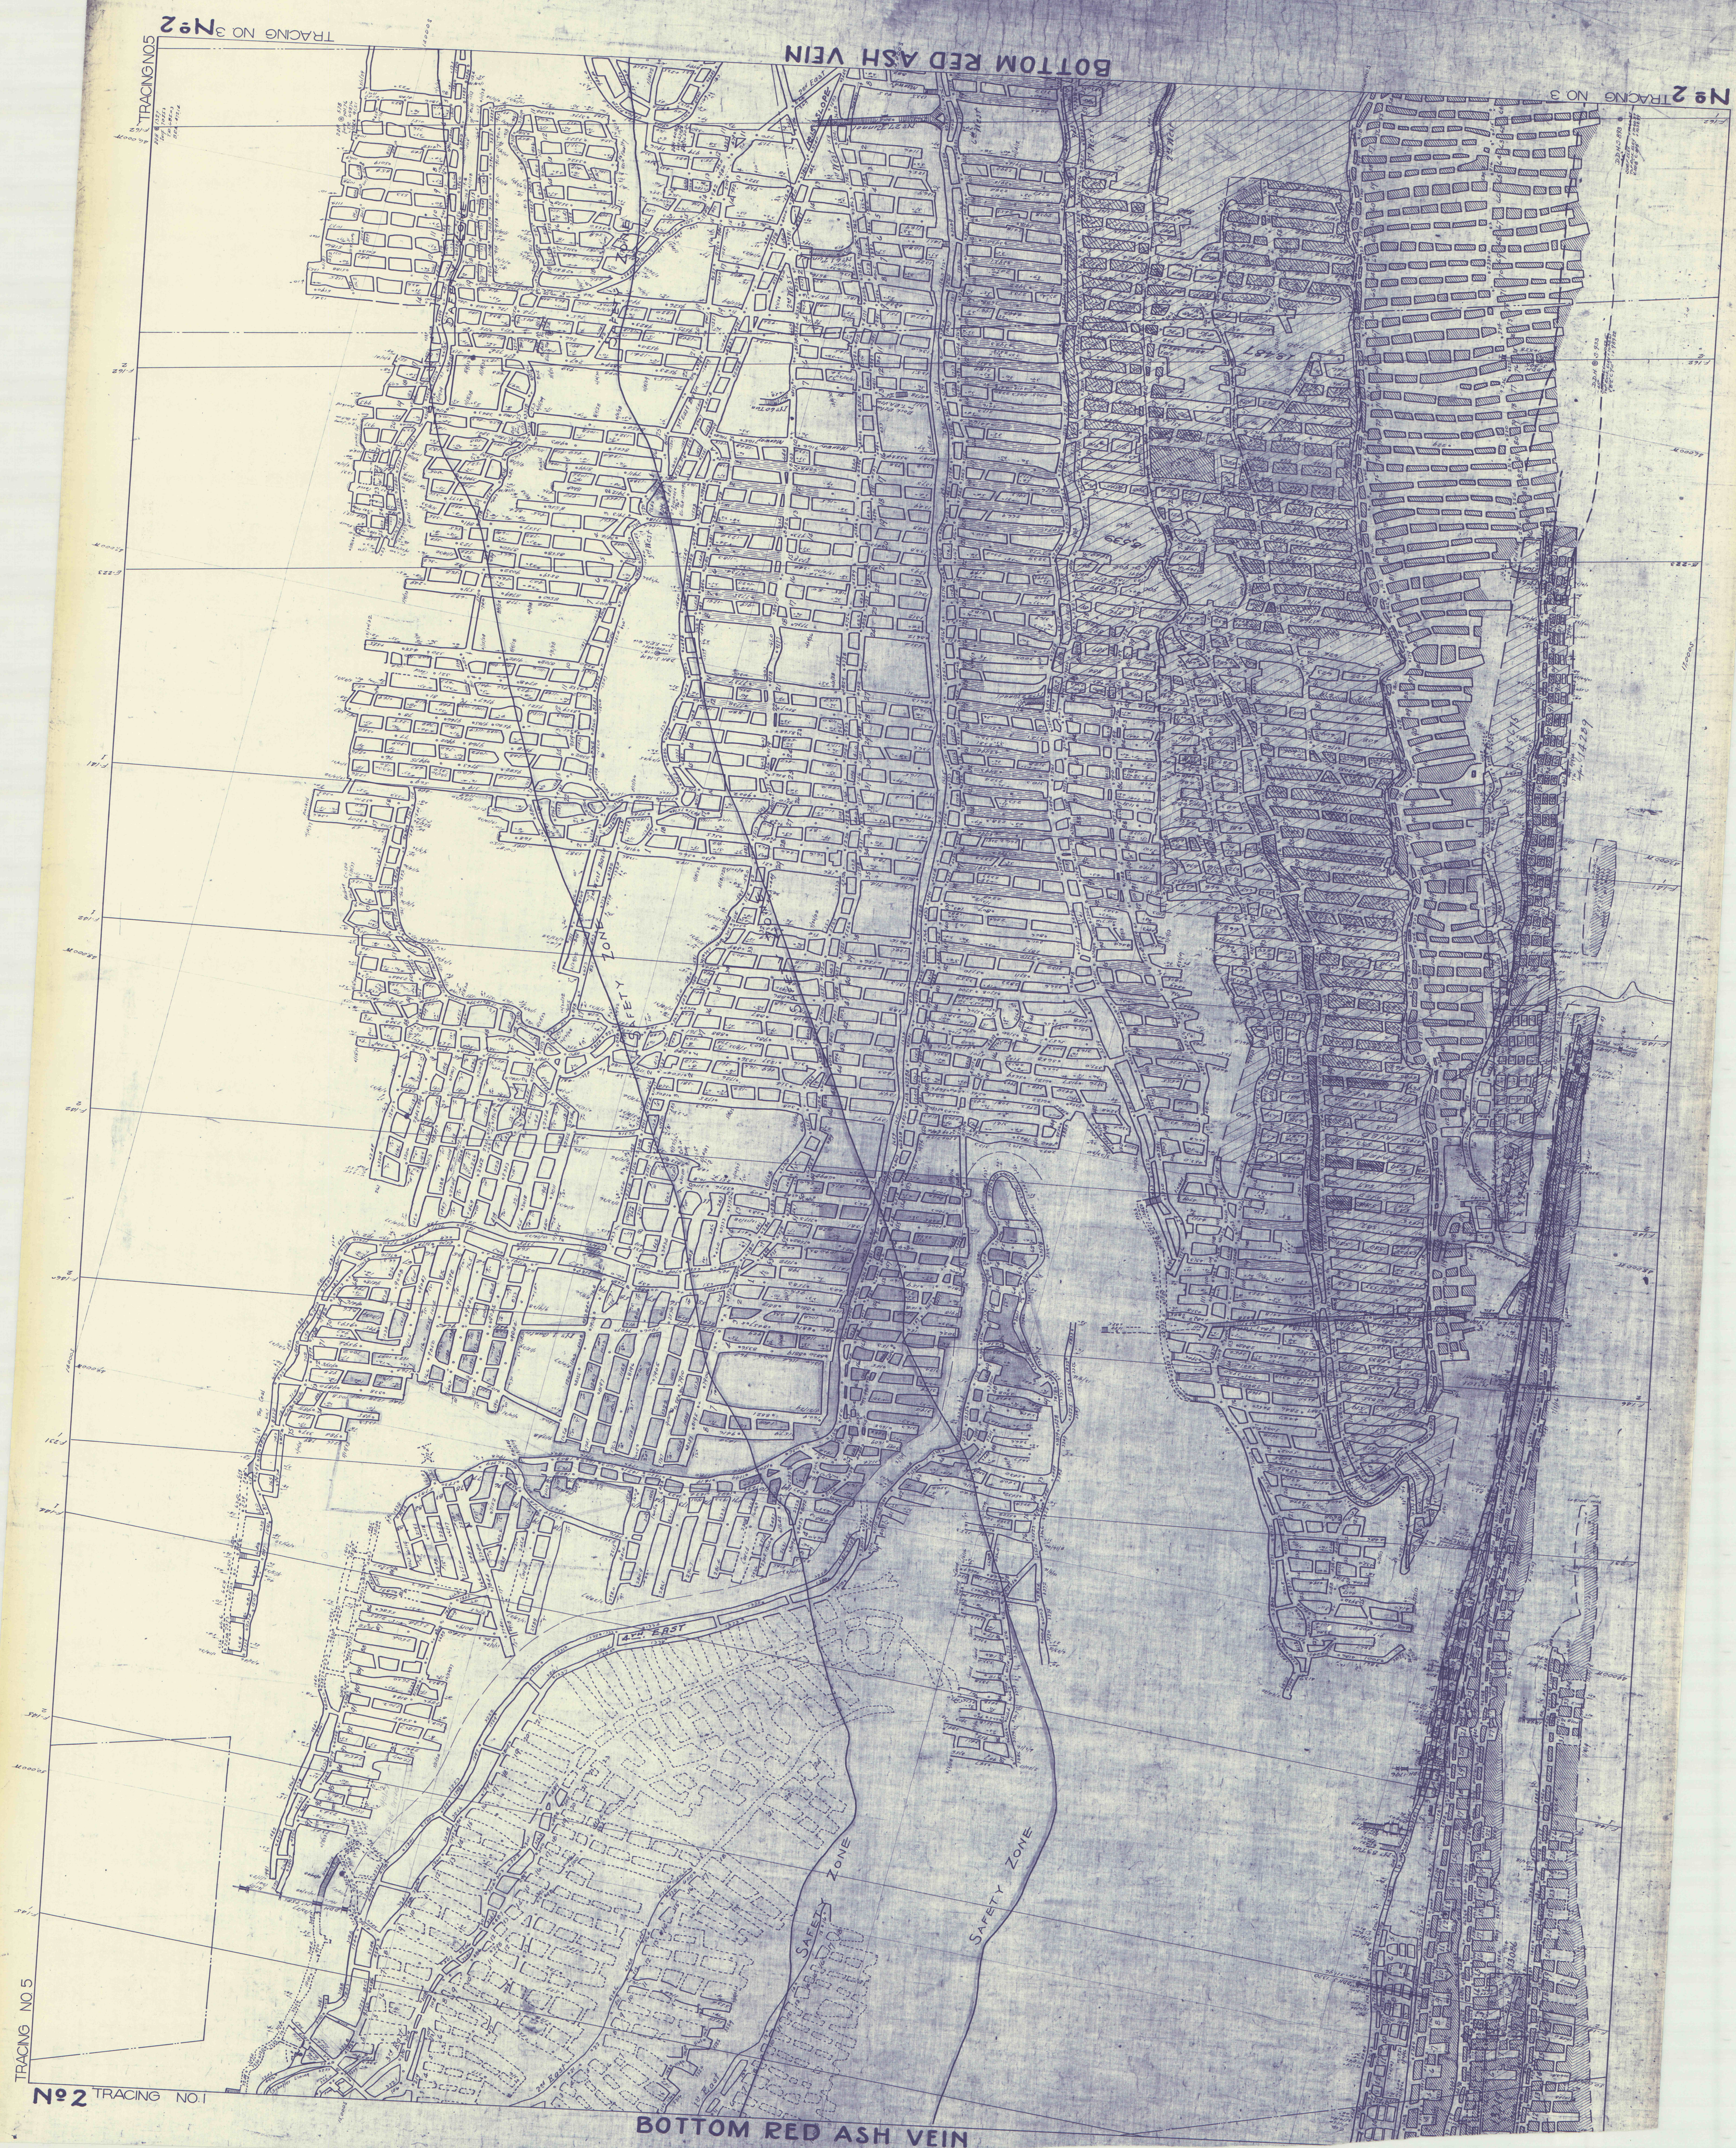

TRACING NO 5

№2 TRACING NO.1

BOTTOM RED ASH VEIN

BOTTOM RED ASH VEIN

№2 TRACING NO. 3

TRACING NO 2