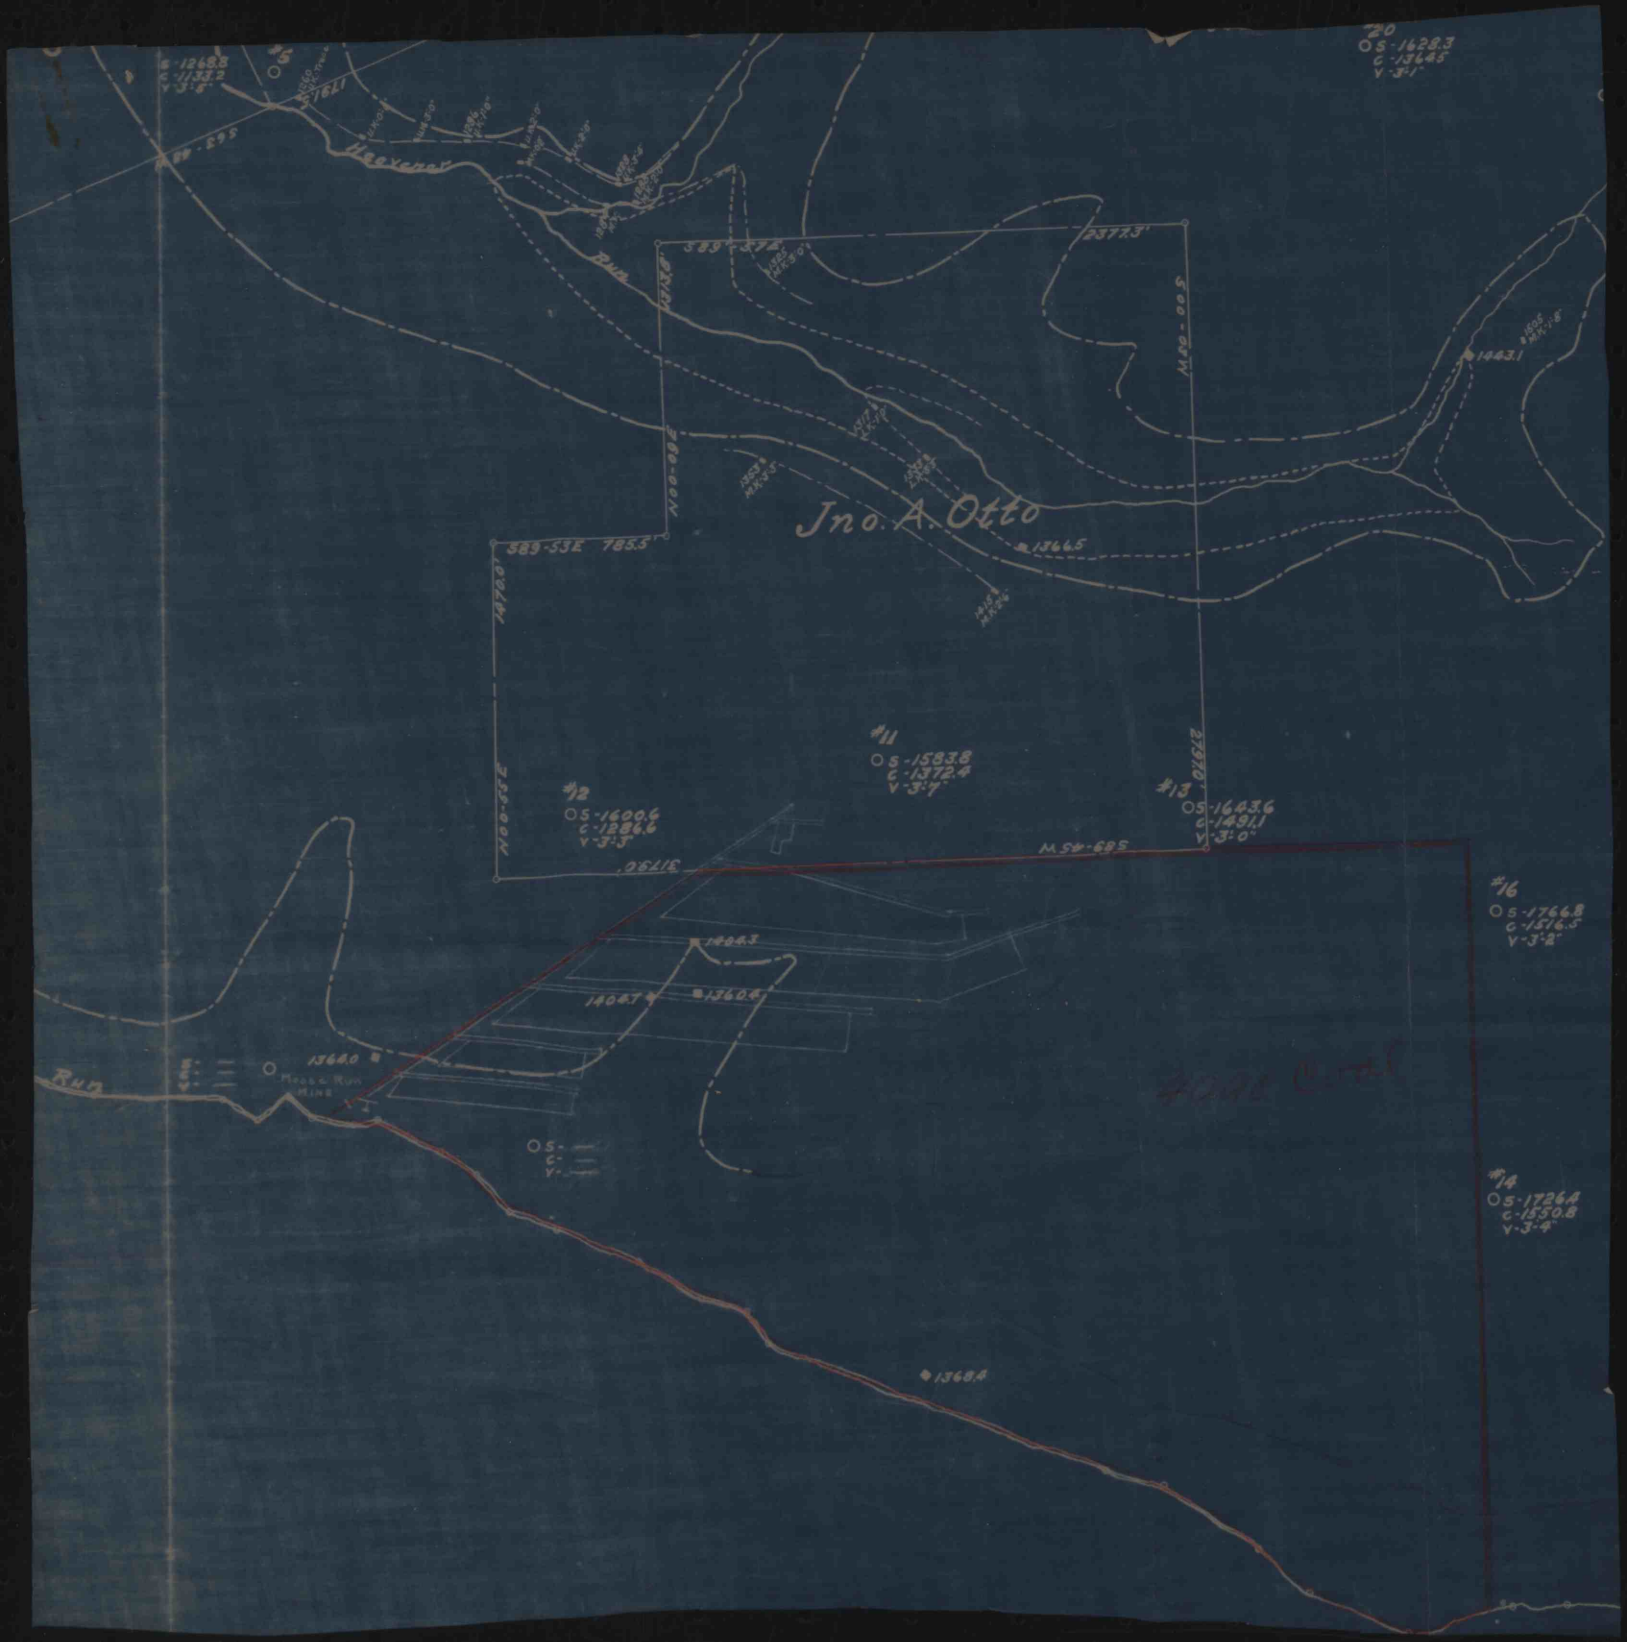
#5
S-1268.8
C-1133.2
V-3'8"
#20
S-1628.3
C-1364.5
V-3'7"
Hexenet
Run
S83°-37E
2377.3'
N00-00E
S00-00W
Jno. A. Otto
1443.1
1366.5
S83°-53E 785.5'
1470.0'
N00-53E
#11
S-1583.8
C-1372.4
V-3'7"
#12
S-1600.6
C-1286.6
V-3'5"
#13
S-1643.6
C-1491.1
V-3'0"
S89°-45W
3170.0'
#16
S-1766.8
C-1576.5
V-3'2"
1464.3
1464.7
1360.4
1364.0
Meas. Run Mine
Run
#2 Coal
#14
S-1726.4
C-1550.8
V-3'4"
1368.4