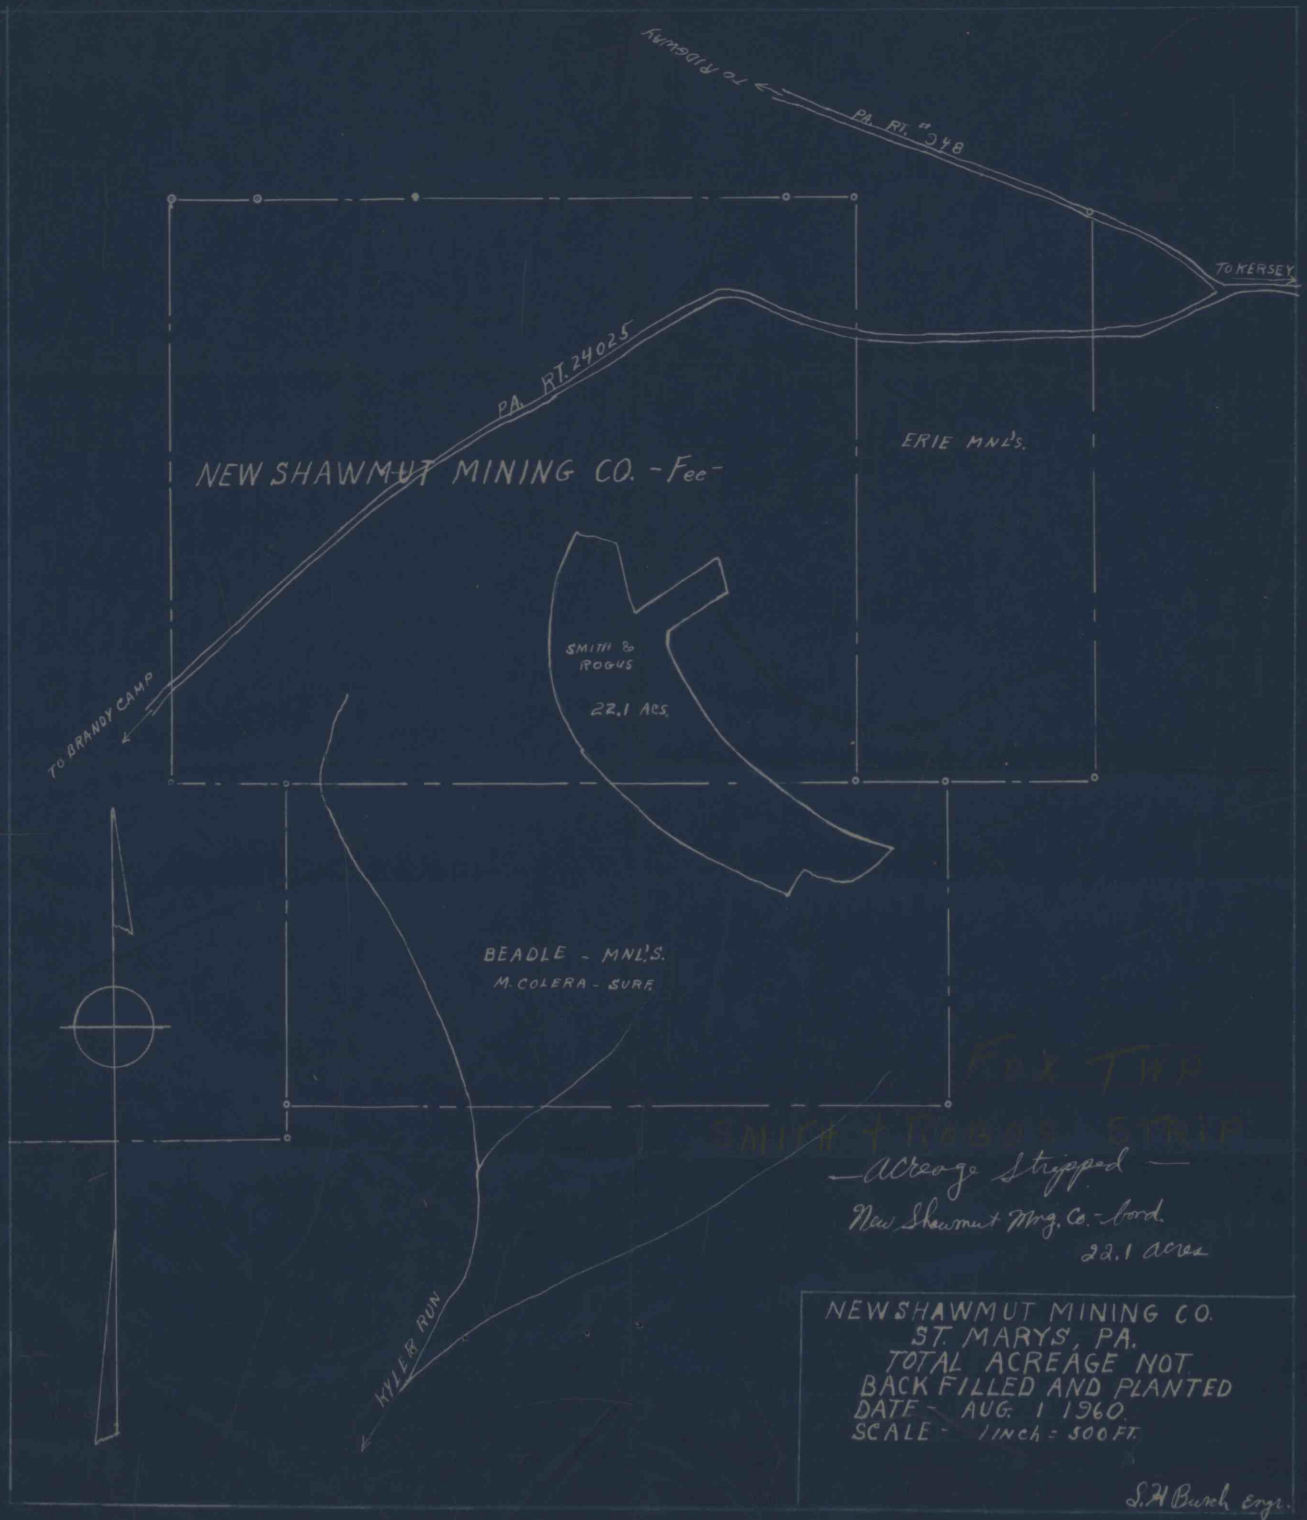
TO RIDGWAY
PA. RT. 948
TO KERSEY
PA. RT. 24025
ERIE MNL'S.
NEW SHAWMUT MINING CO. - Fee -
SMITH & ROGUS
22.1 ACS.
TO BRANDY CAMP
BEADLE - MNL'S.
M. COLERA - SURF.
WYLER RUN
FOR THE
SMITH & ROGUS STRIP
acreage Stripped
New Shawmut Mng. Co. - bond.
22.1 acres
NEWSHAWMUT MINING CO.
ST. MARYS, PA.
TOTAL ACREAGE NOT
BACK FILLED AND PLANTED
DATE - AUG. 1 1960
SCALE - 1 INCH = 500 FT.
S. H. Burch Engr.