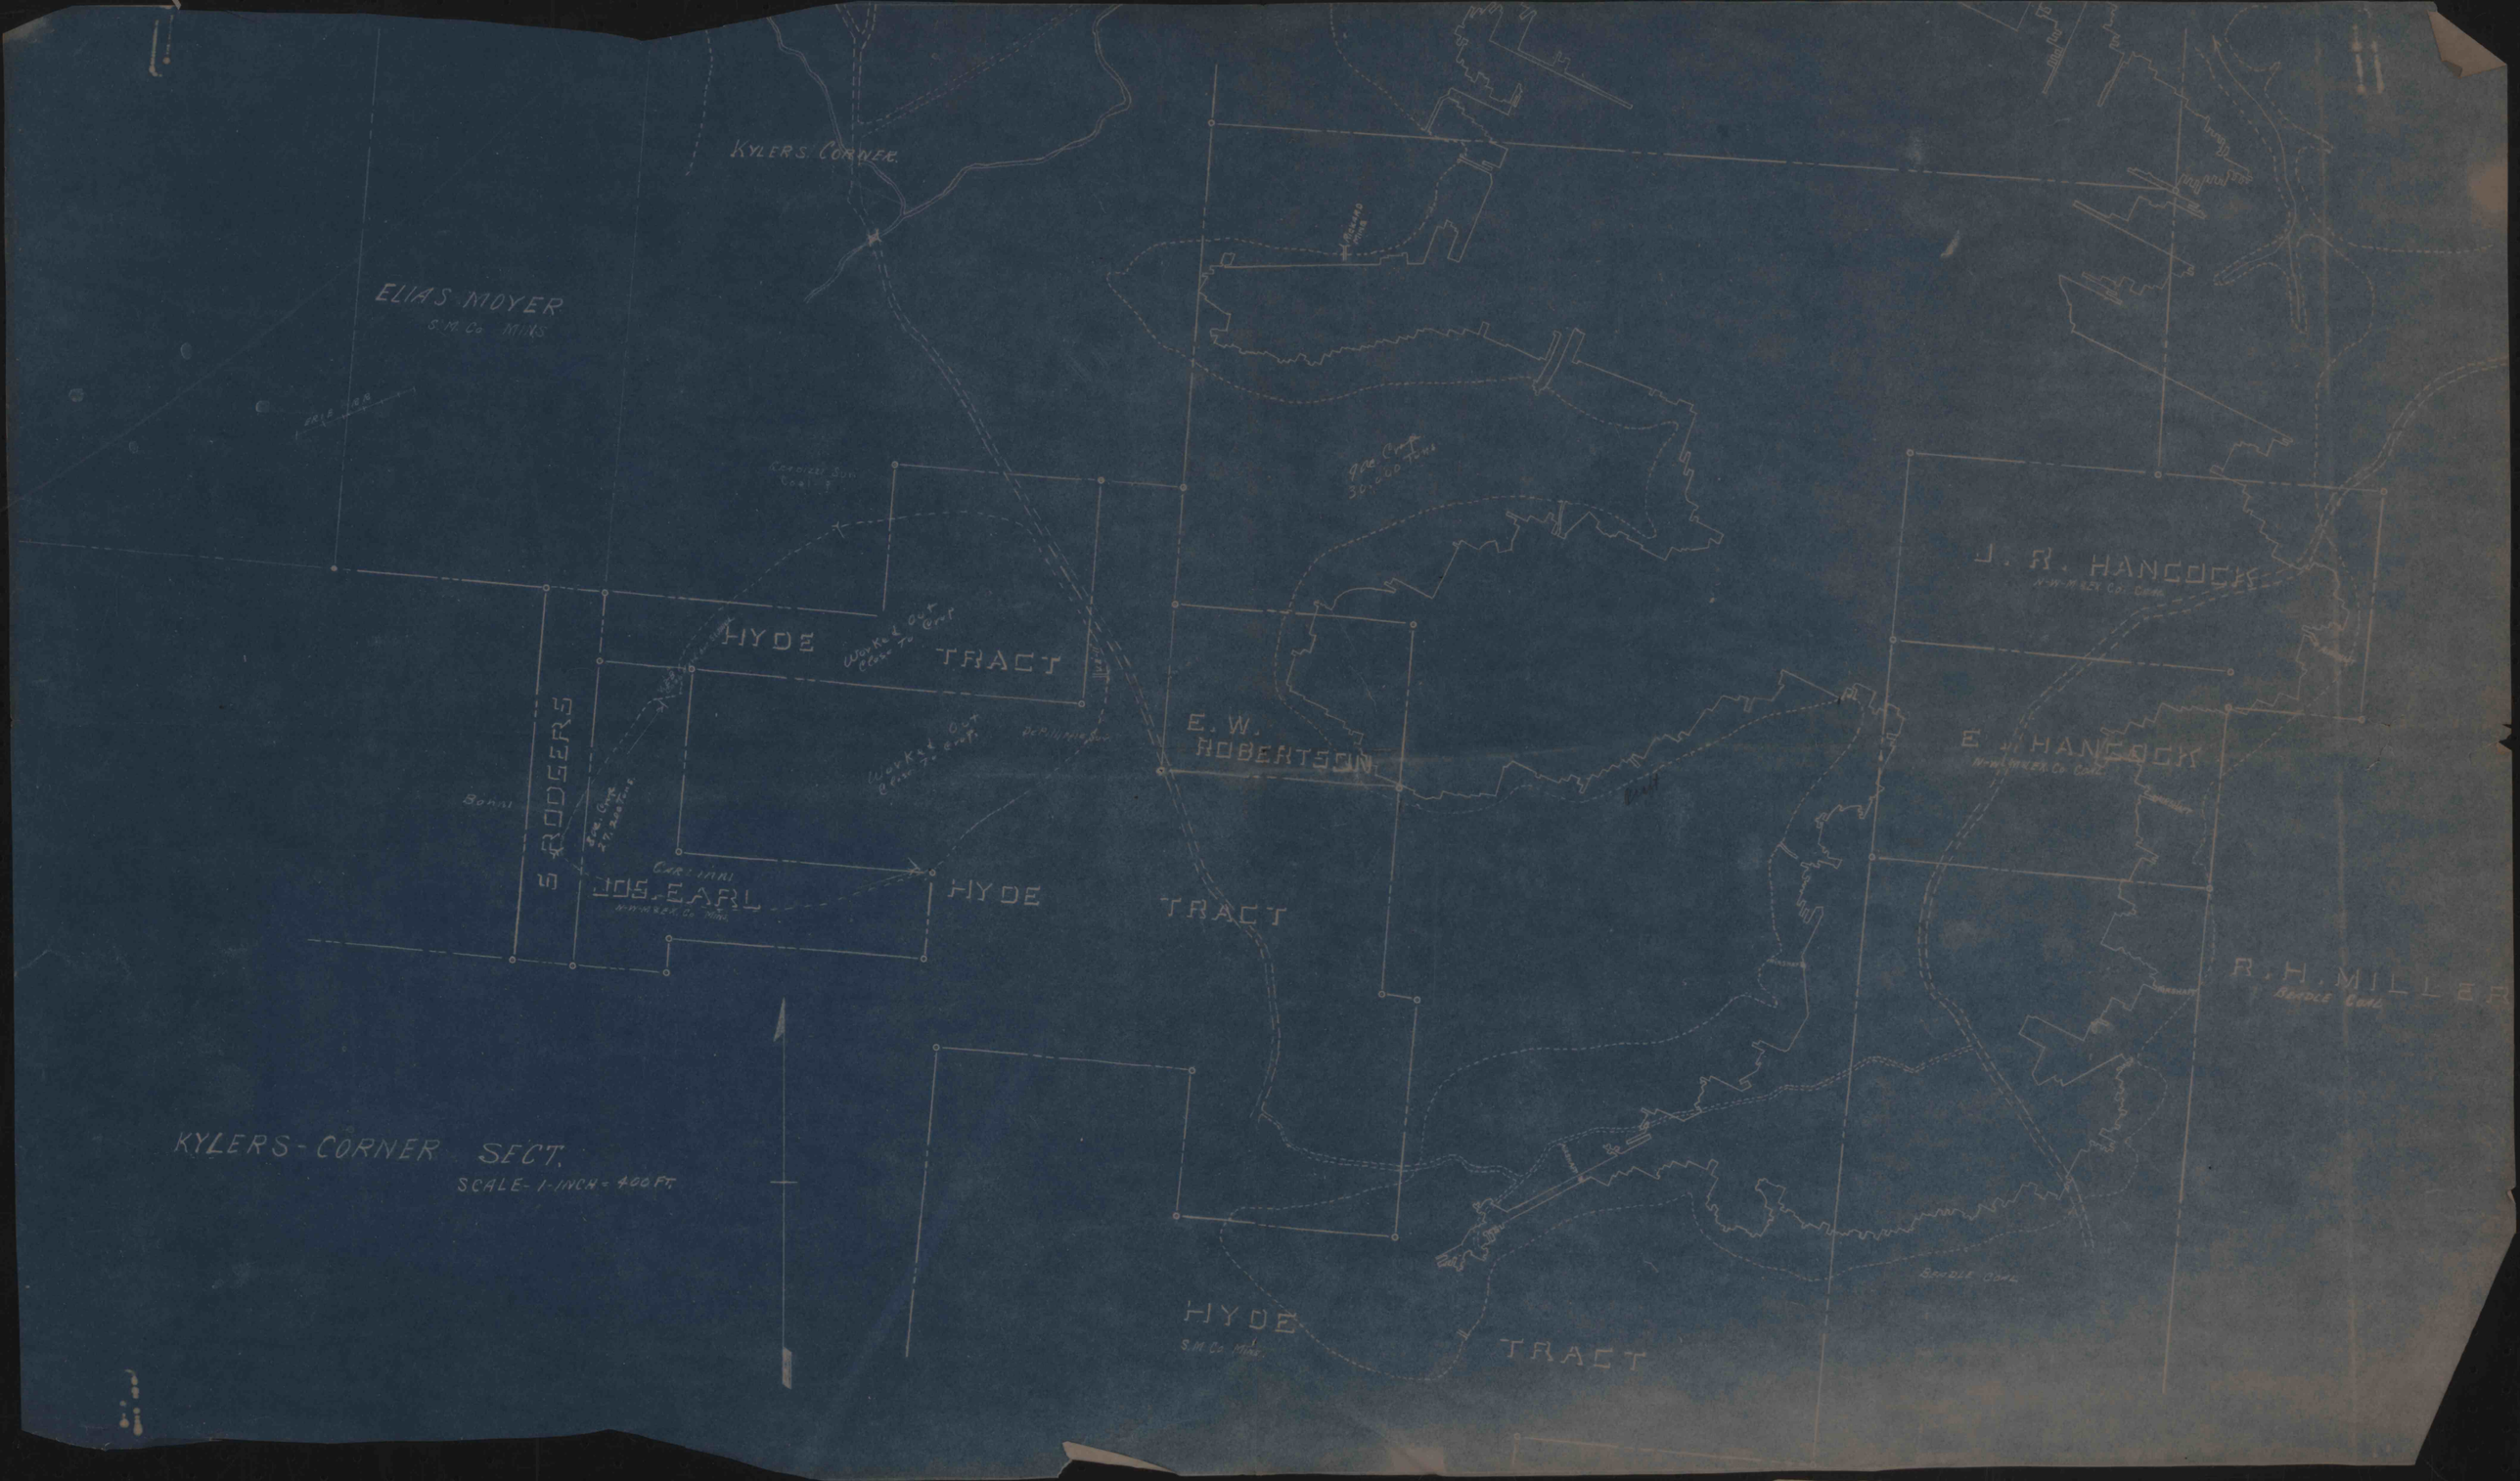

Standberg at Kyler Corners.

I think that round top. Is pretty well worked out by deep mines. There Is about 14 or 15 lifts around the Crop line. In the South West Corner. there looks to be some good stripping as the Cover Is to shallow for deep mining I think there Is about 8 Ac. of Crop that could be Stripped, or about 27,200 tons, some of the Crop Is on the N.W.M.S.E.R.Co. Coal that was in the exchange, I dont know how much, as I just Sketched the Crop line on the map, Standberg talked about stripping that hollow. East of the round top, on the Hyde Farm. that the S.M.Co has the Coal. I think there Is about 9 Ac. of Crop or. 30,000 tons, on this piece of this did not work to close to the Crop by deep mines.