


MAP
OF THE
GOSS RUN COLLIERY
OPERATED BY
BERWIND WHITE & CO.
CLEARFIELD CO.

P.N.N.A.
SCALE 1000 FT. PER INCH
1878
P. Cameron

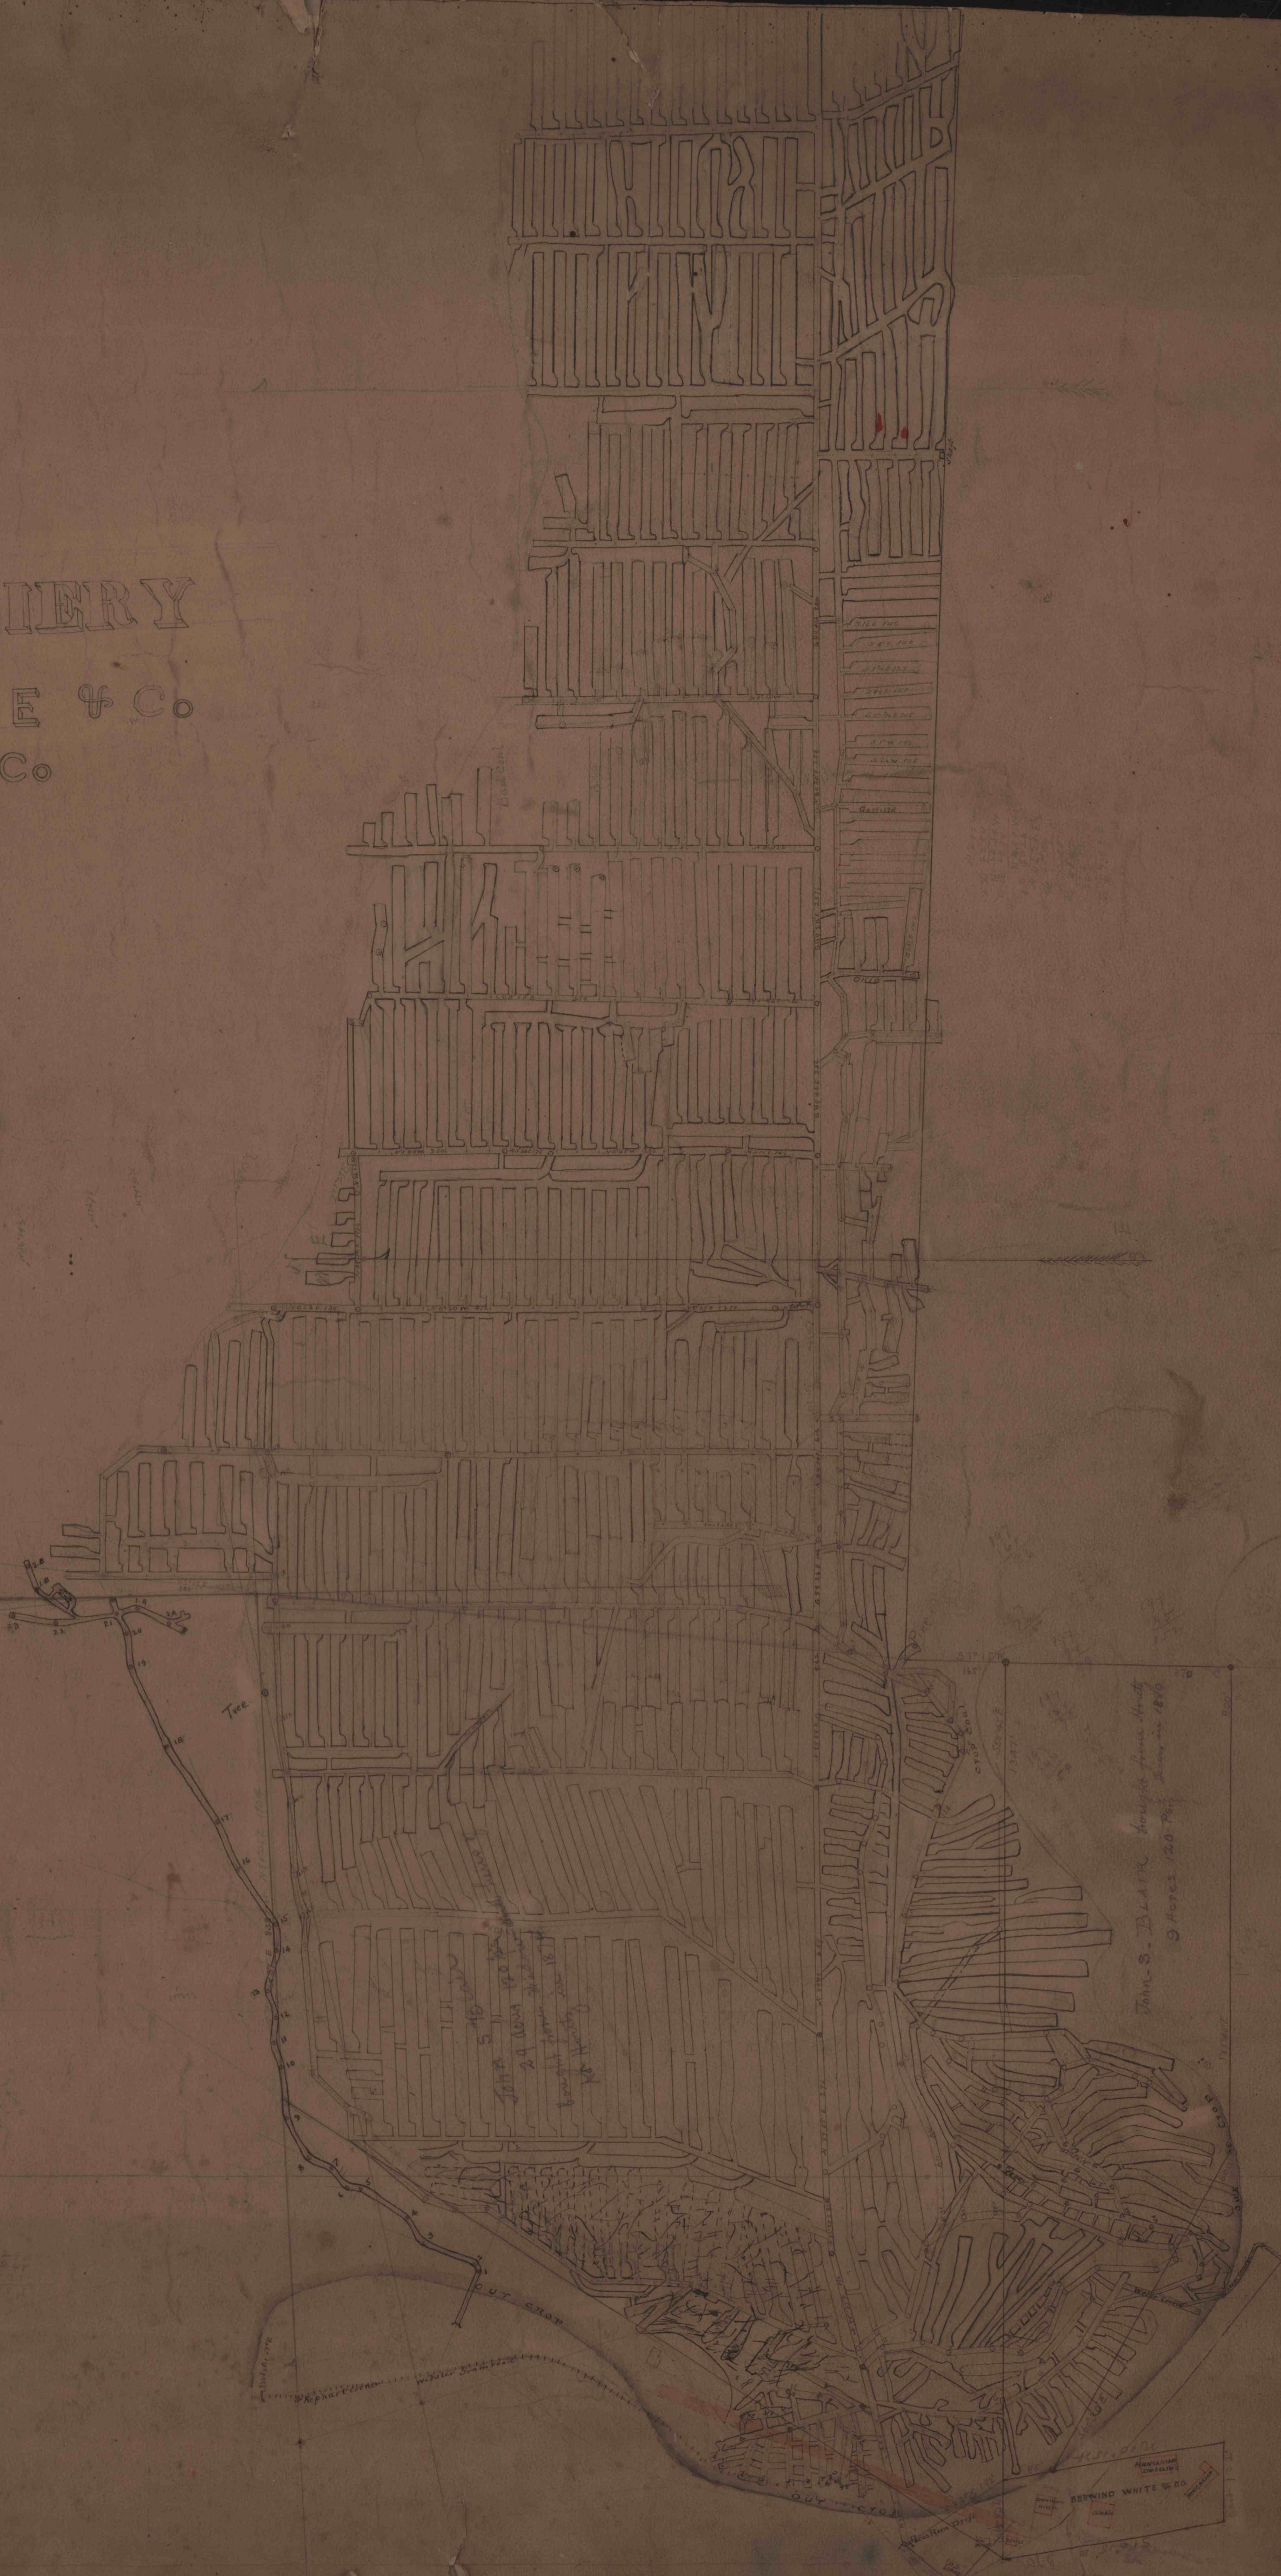

D
Lower Shelf
49-A